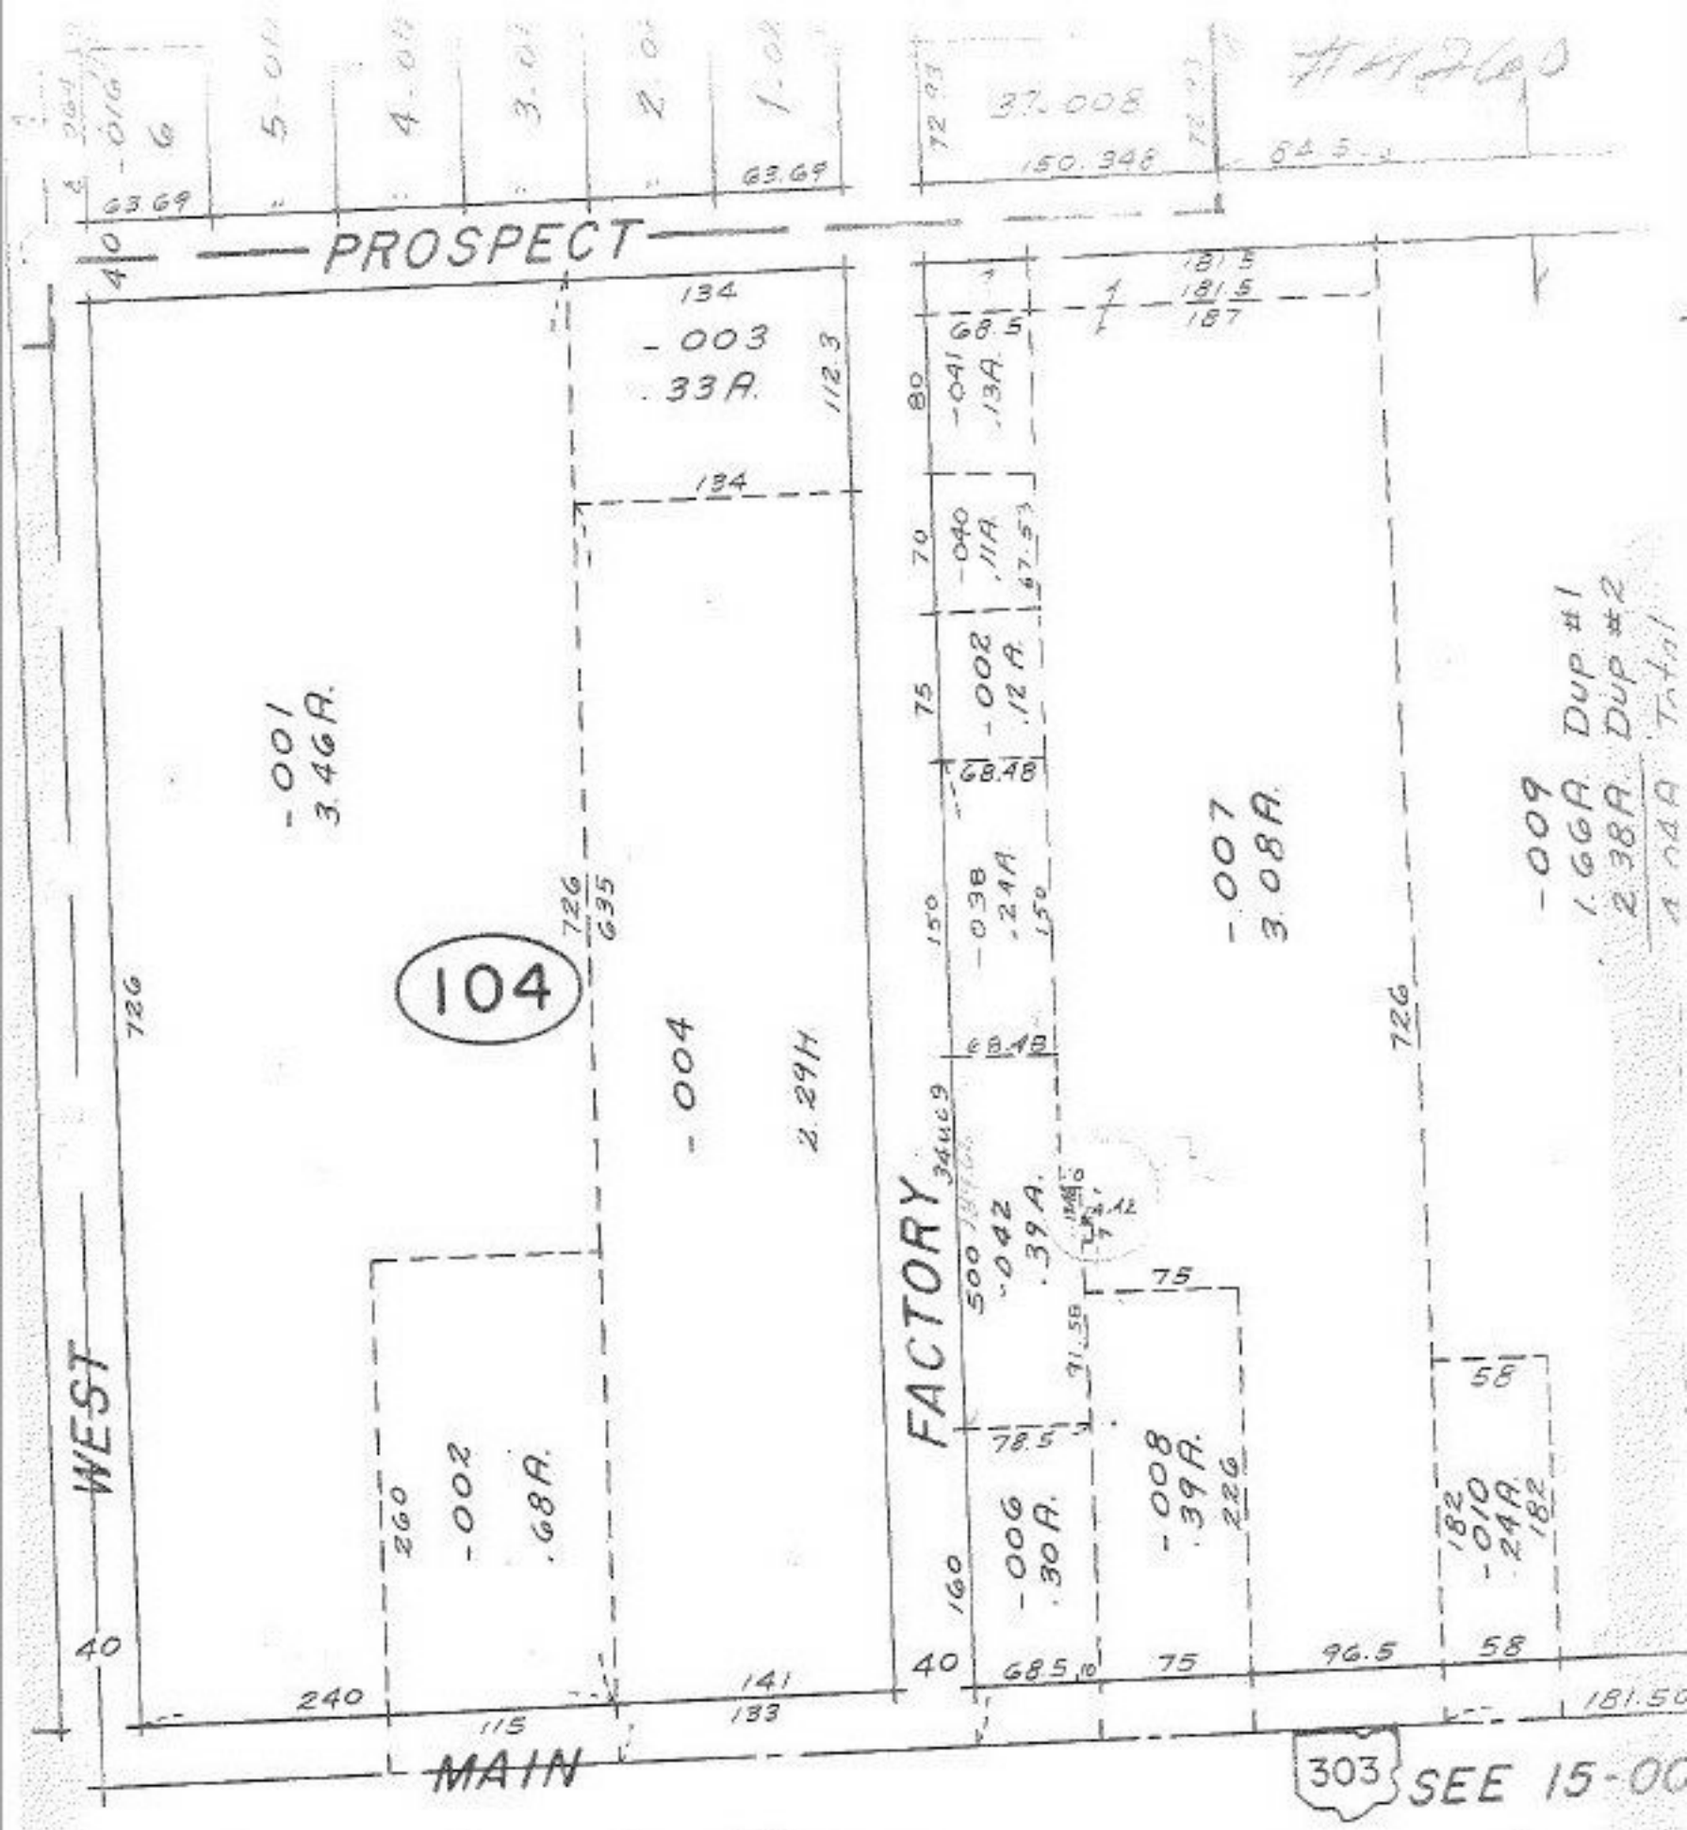

Correct Cronaflex Tract of
[illegible]

NOV 13 ENT'D

LAGRANGE TWP.

SCALE: 1" = 100'

15-00-045B