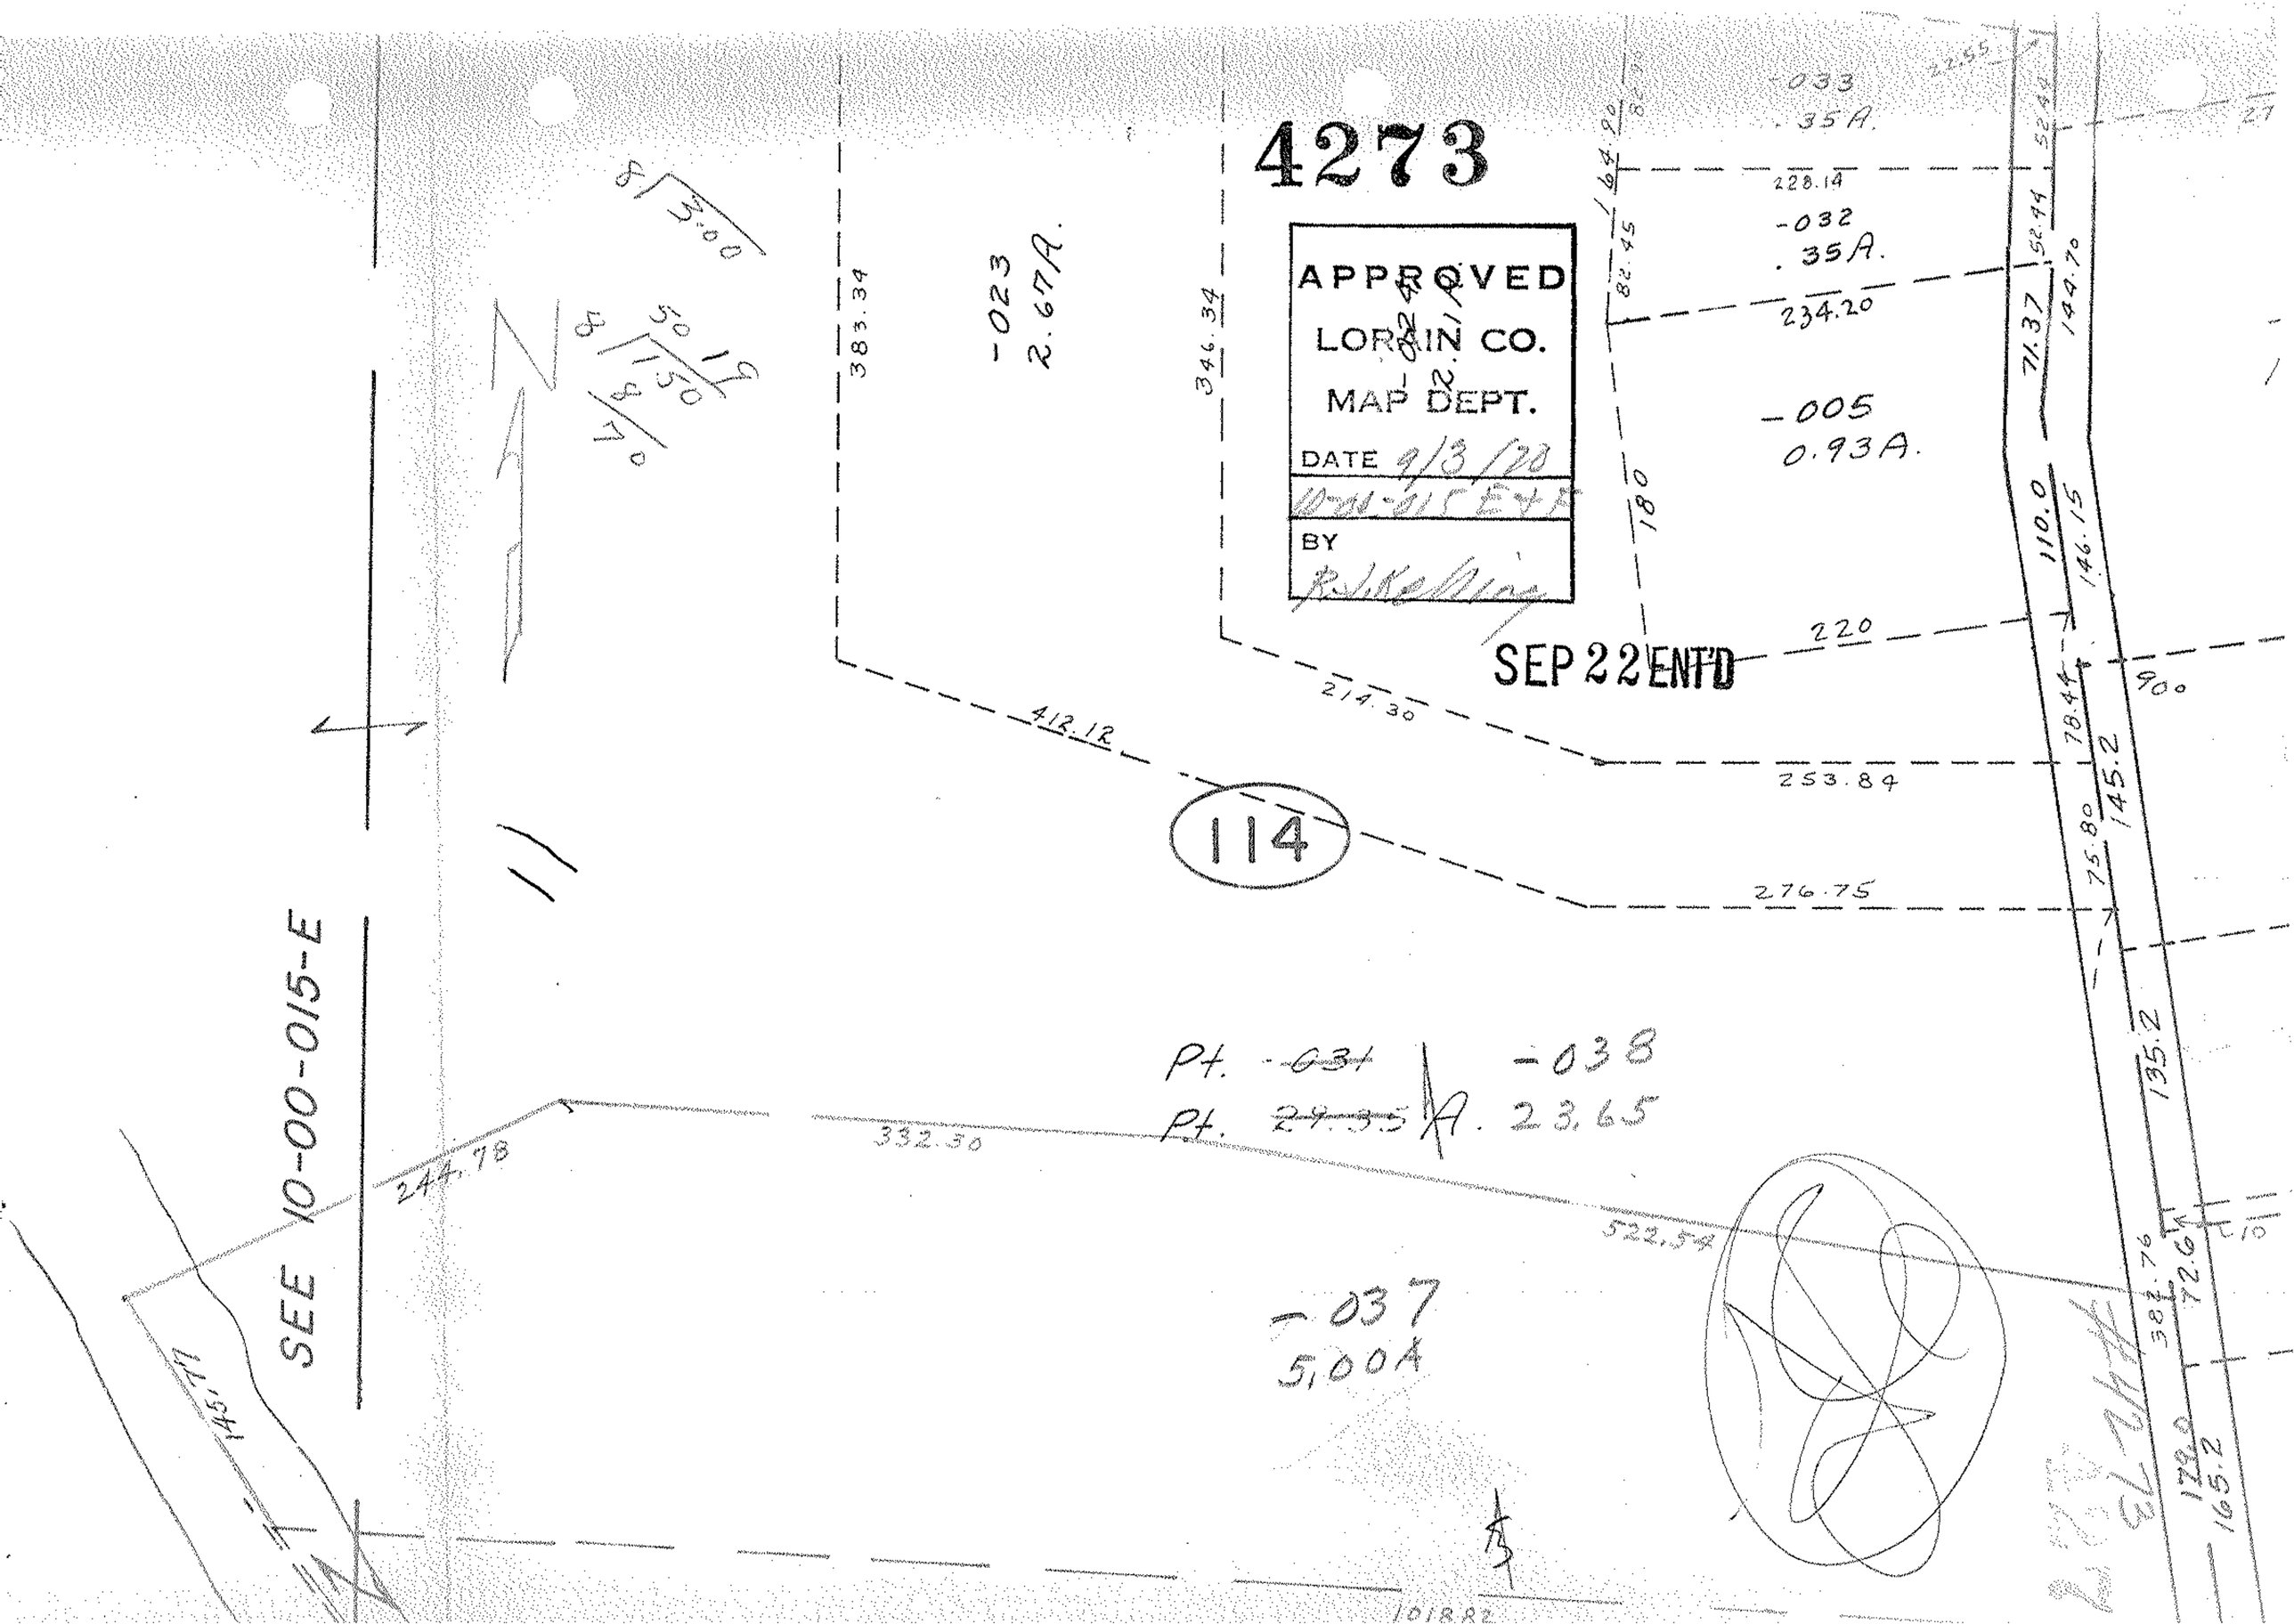
4273
APPROVED
LORAIN CO.
MAP DEPT.
DATE 9/3/78
BY
SEP 22 ENT'D
-033
.35A.
228.14
-032
.35A.
234.20
-005
0.93A.
220
214.30
253.84
276.75
383.34
346.34
412.12
-023
2.67A.
114
Pt. ~~-031~~ -038
Pt. ~~29.35~~ A. 23.65
332.30
244.78
522.54
-037
5.00A
SEE 10-00-015-E
145.77
1018.82
90°
145.2
135.2
165.2
110.0
146.15
71.37
144.70
52.44
52.44
22.55
82.45
164.90
180
78.44
75.80
72.6
382.76
179.0
N