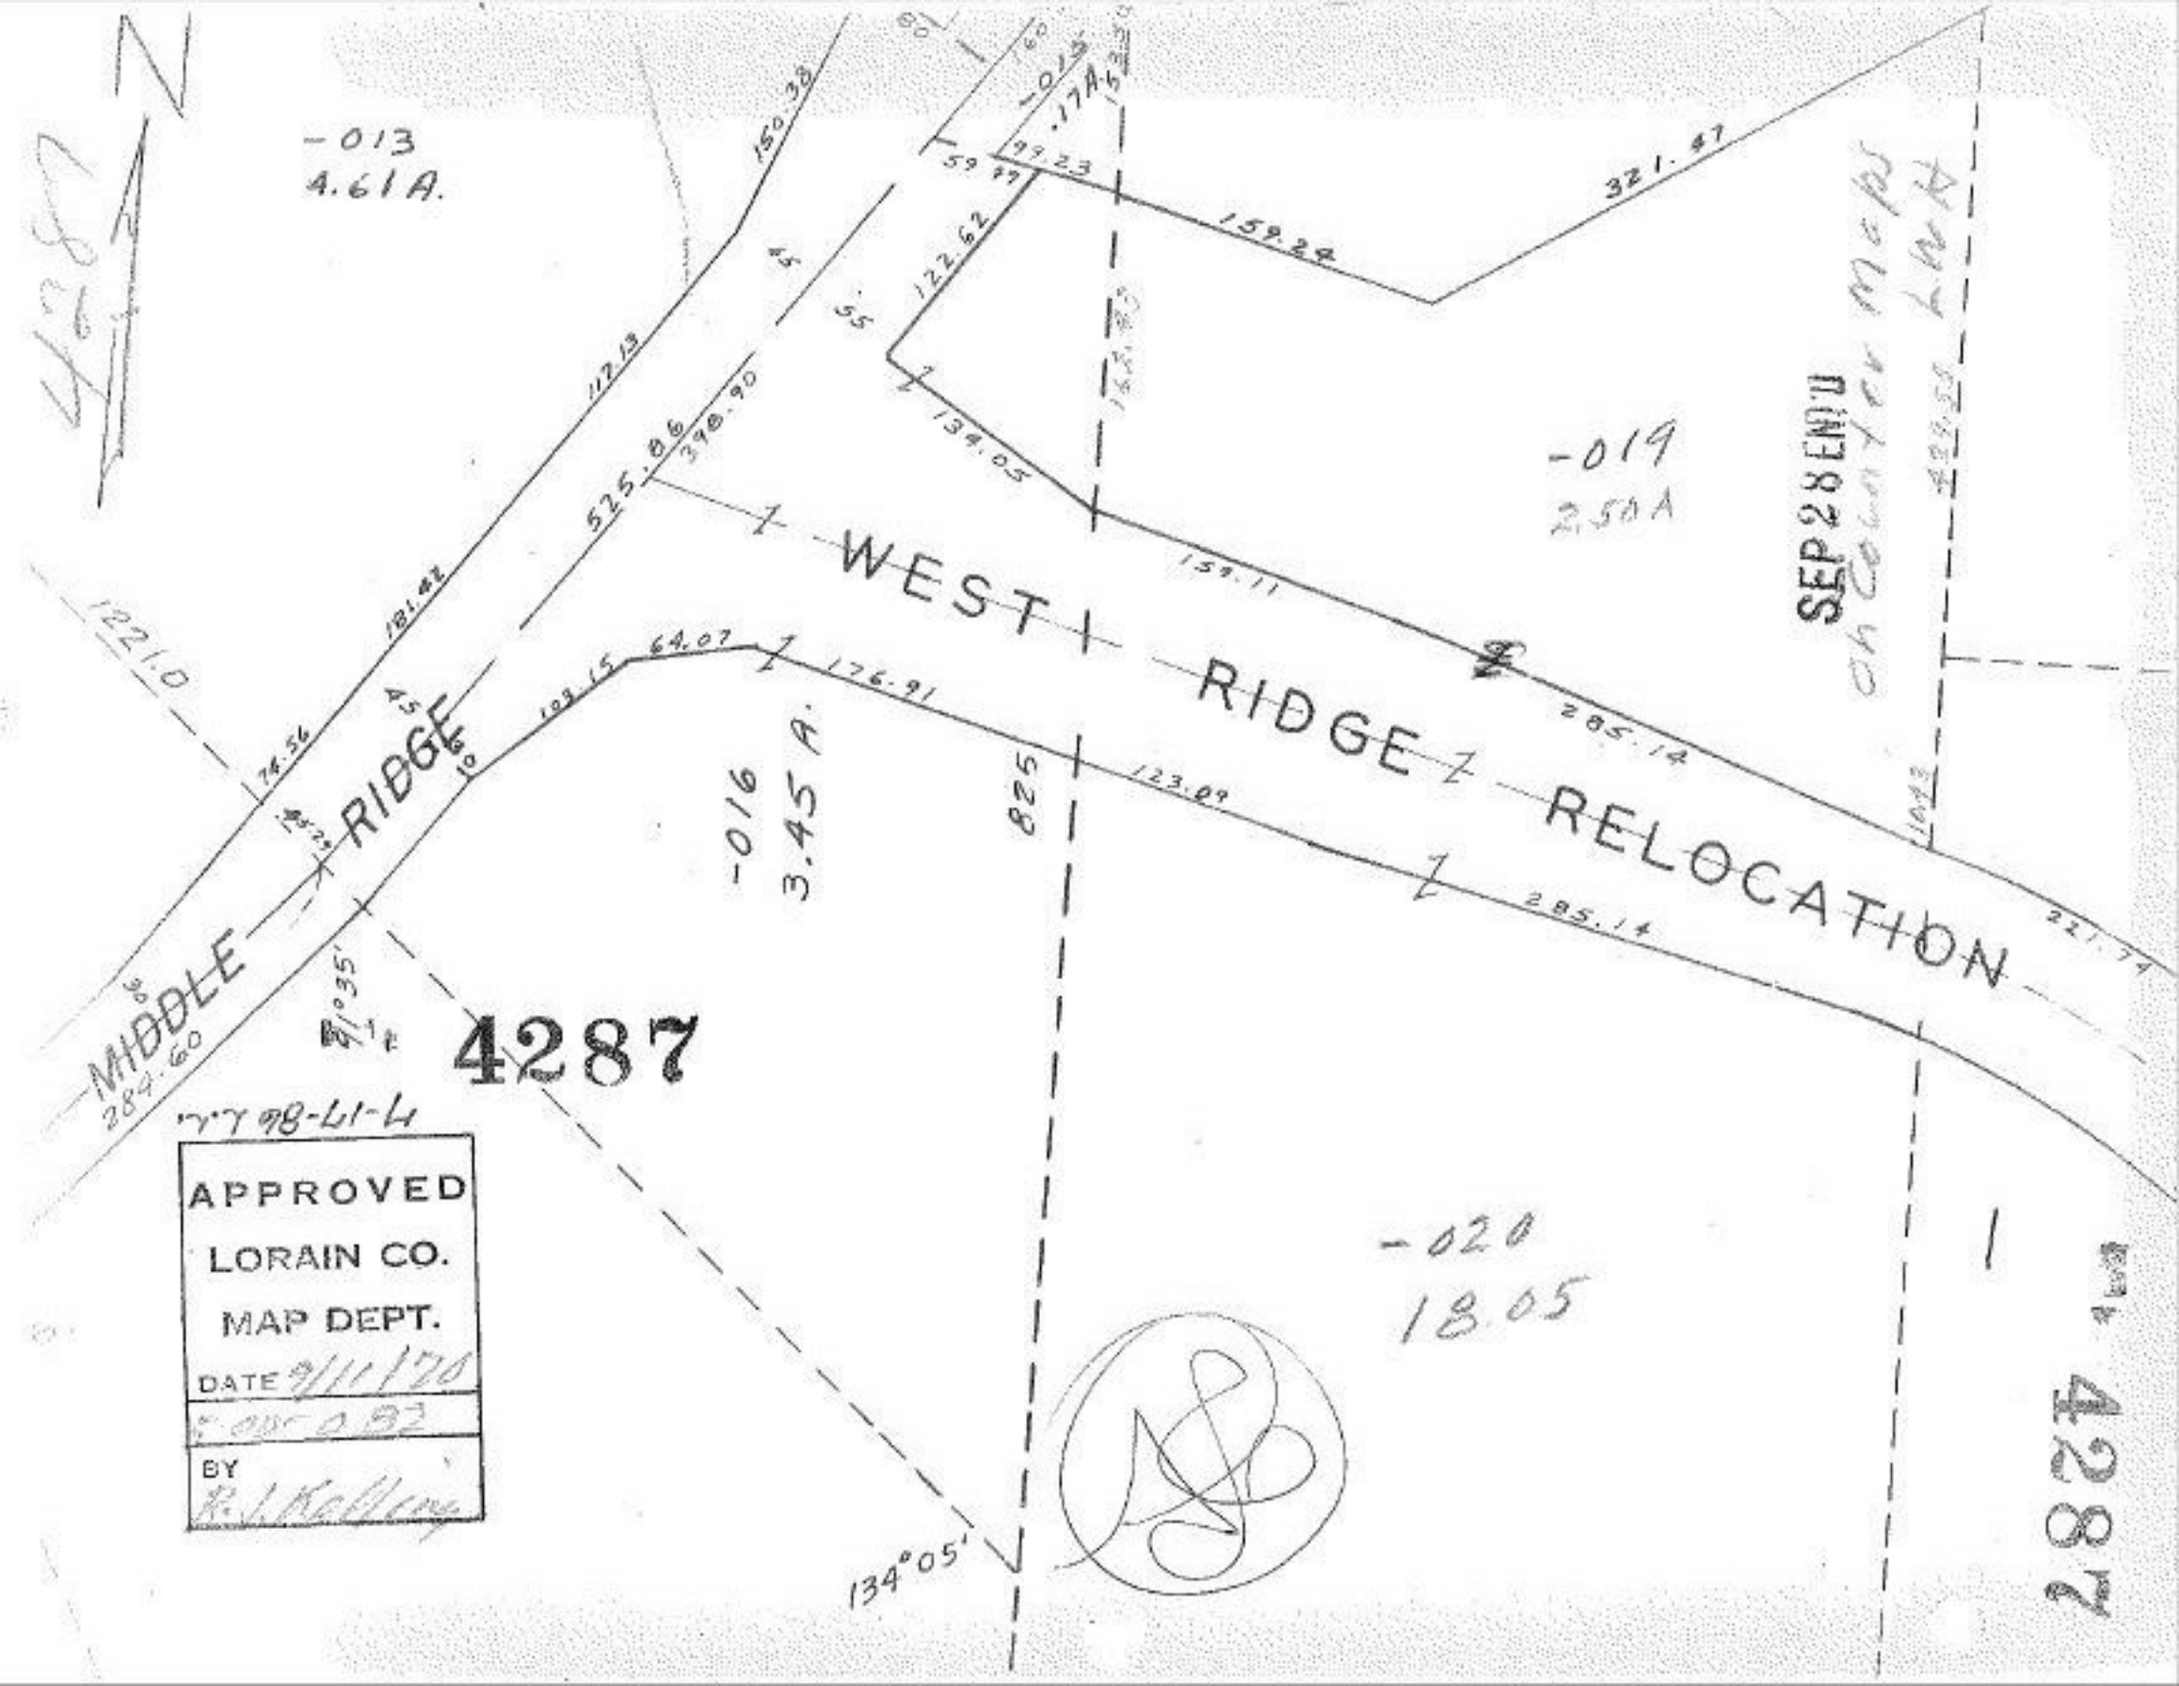
-013
4.61A.
-017
-019
2.50A
-016
3.45A.
-020
18.05
WEST RIDGE RELOCATION
MIDDLE RIDGE
4287
APPROVED
LORAIN CO.
MAP DEPT.
DATE 9/11/70
BY R.J. Kelley
SEP 28 REC'D
4287