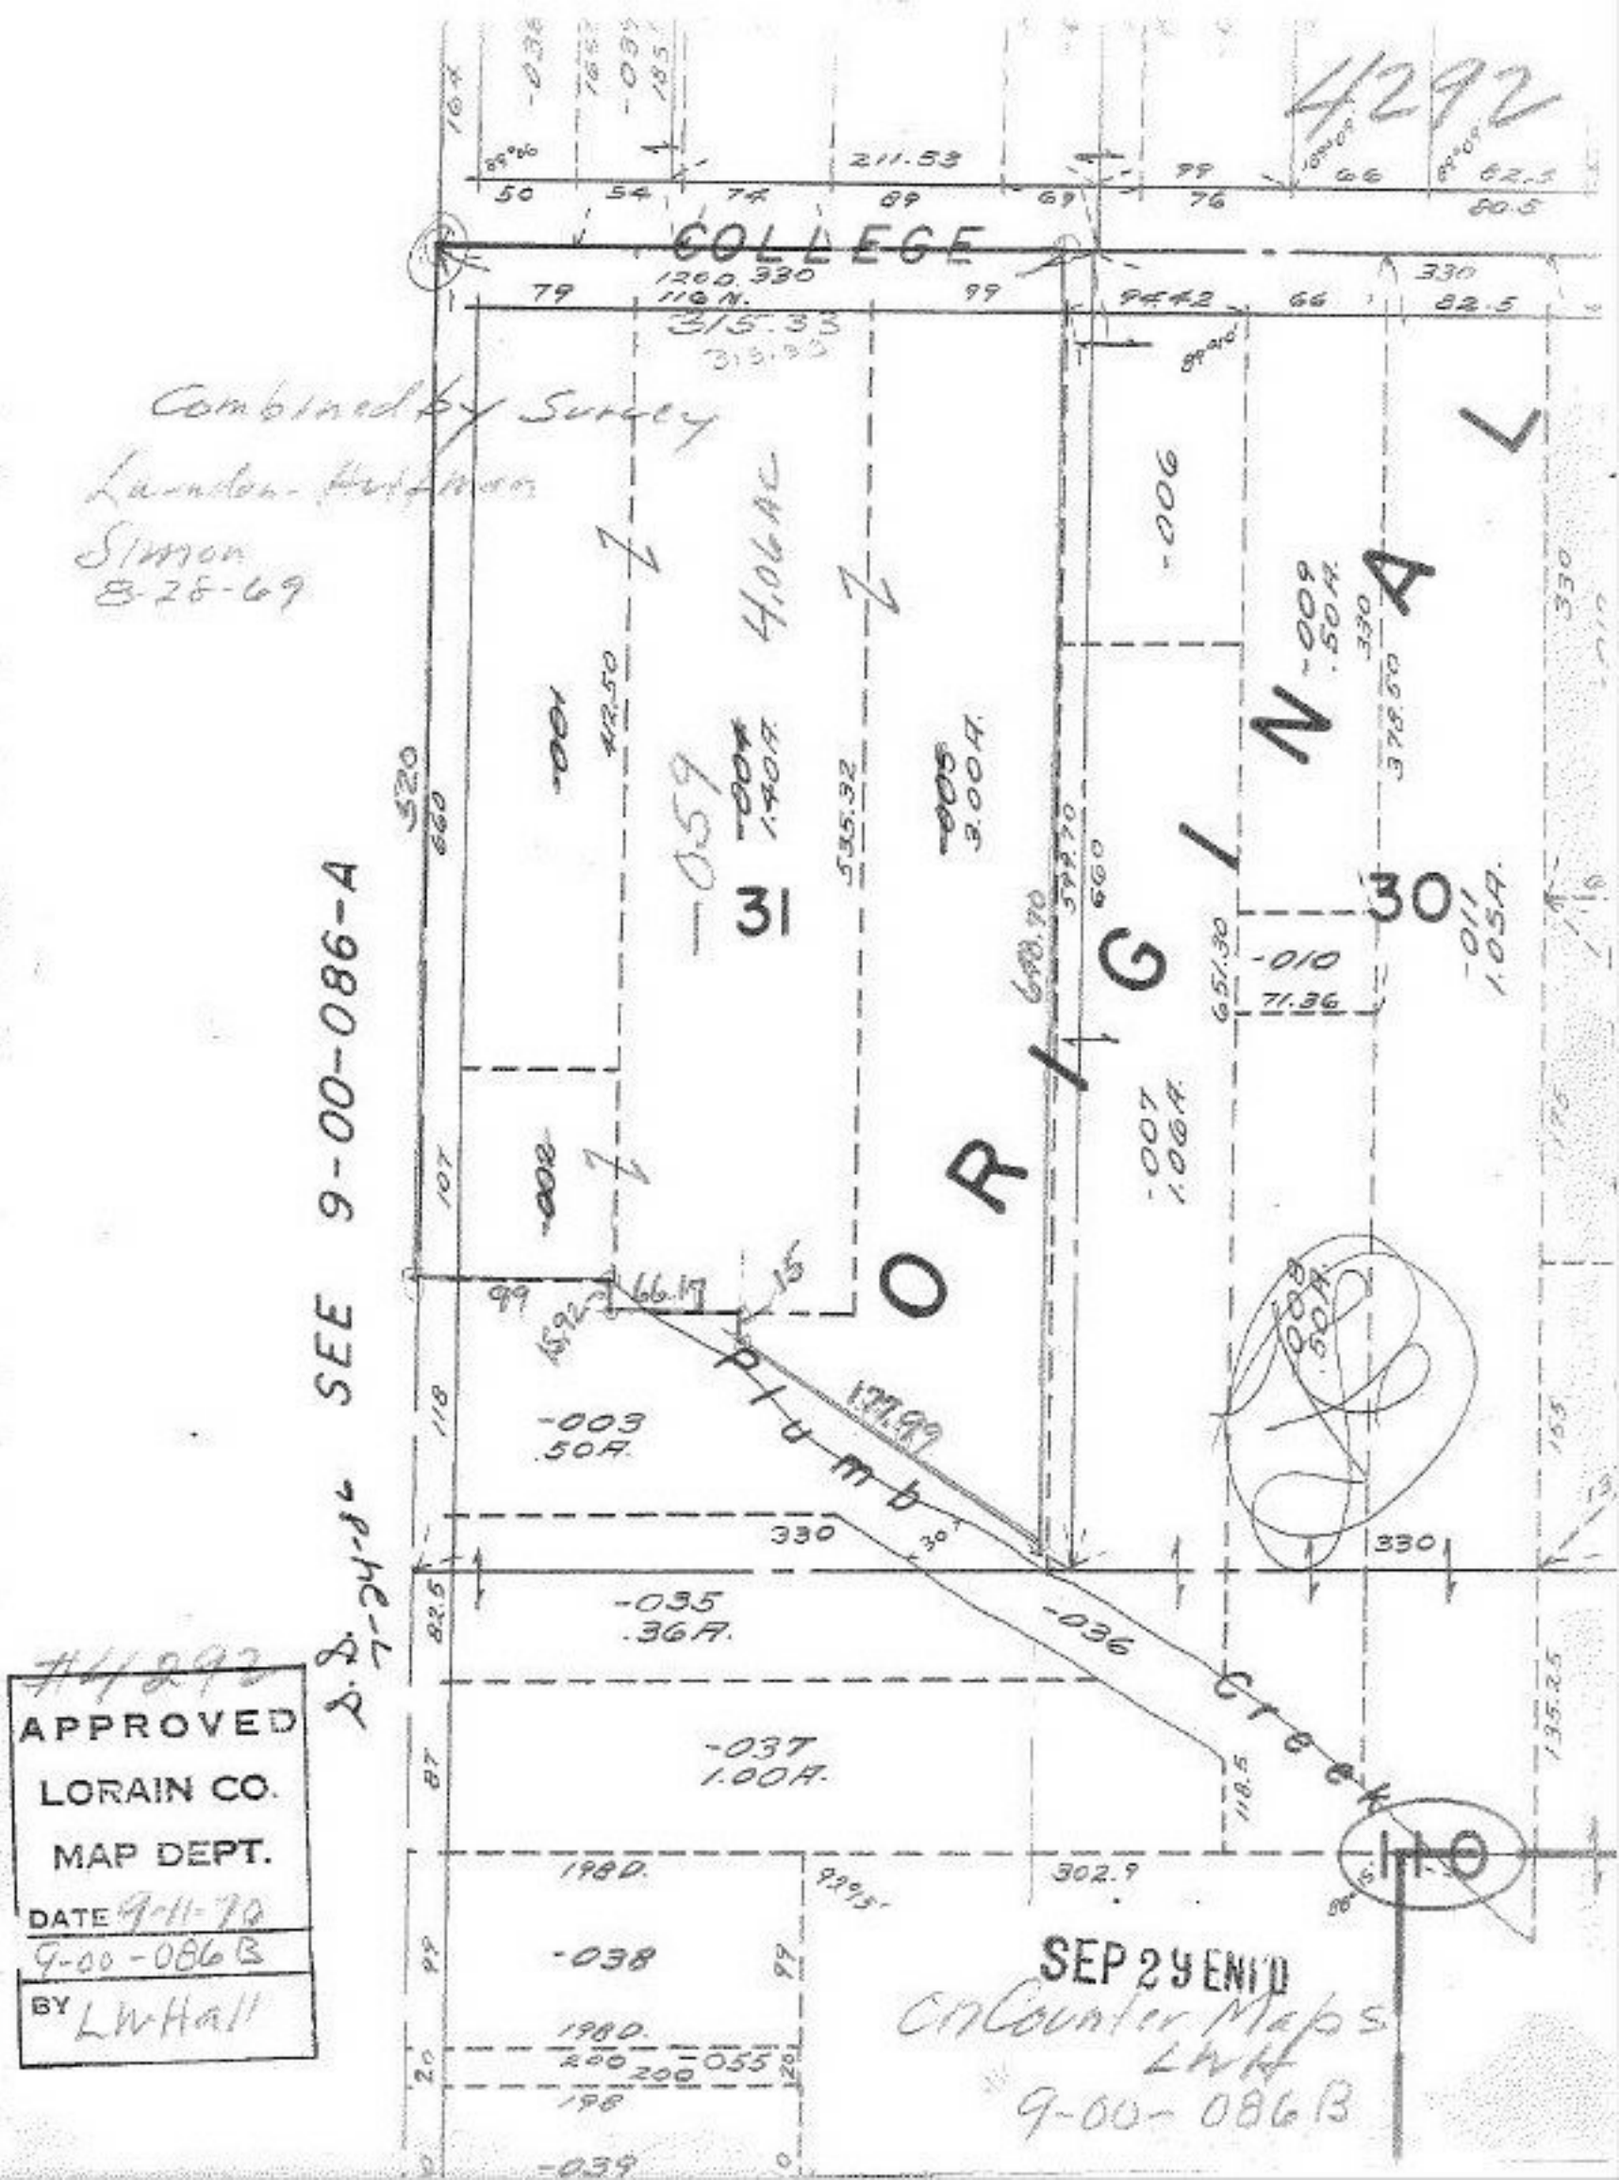
4292
COLLEGE
ORIGINAL
Combined by Survey
Landon-Hutchinson
Simson
8-26-69
4.06 AC
-059
31
30
-006
-009 .50A.
-010
71.36
-011 1.05A.
-007 1.06A.
-008
-003 .50A.
-035 .36A.
-036
-037 1.00A.
-038
-039
SEE 9-00-086-A
S. 24-4
Plumb
Creek
APPROVED
LORAIN CO.
MAP DEPT.
DATE 9-11-70
9-00-086B
BY LWHall
#4292
SEP 29 ENTD
On Counter Maps
LWH
9-00-086B