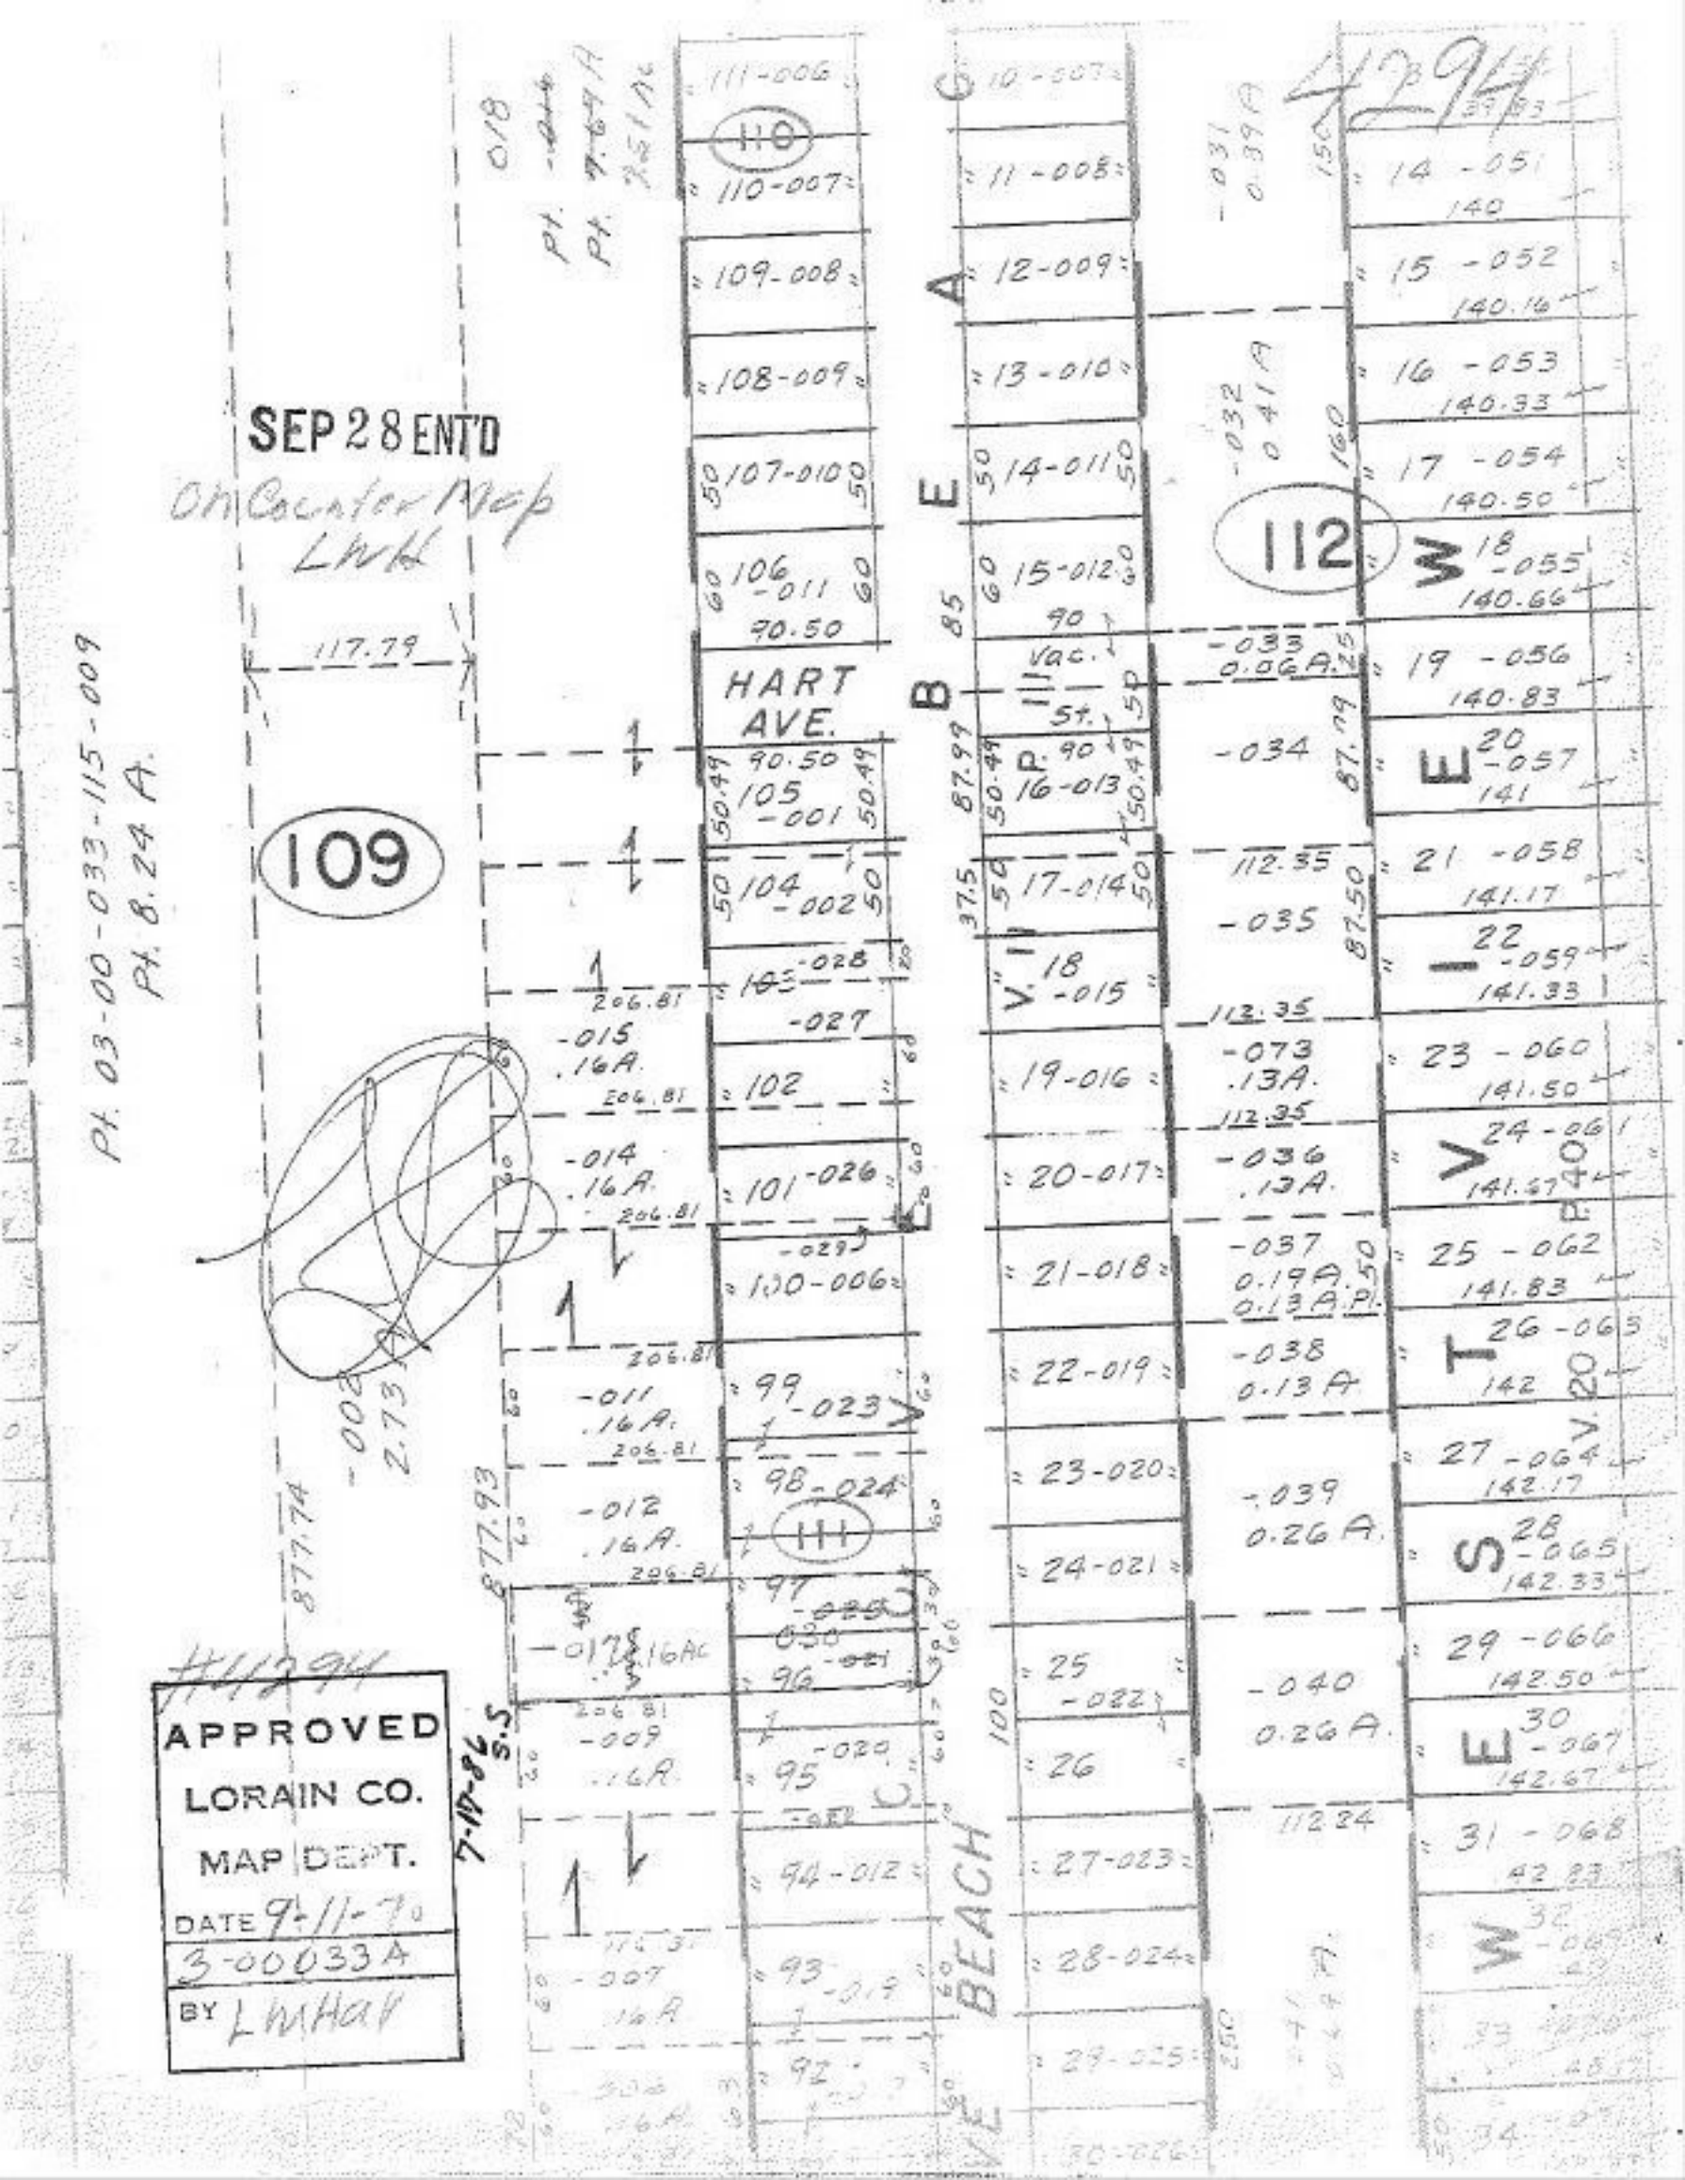

SEP 28 ENT'D
On Counter Map
LWH
4294
HART AVE.
BEACH
109
110
111
112
Pt. 03-00-033-115-009
Pt. 8.24 A.
117.79
877.74
877.93
APPROVED
LORAIN CO.
MAP DEPT.
DATE 9-11-70
3-00033A
BY LWHar
7-17-86 S.S.