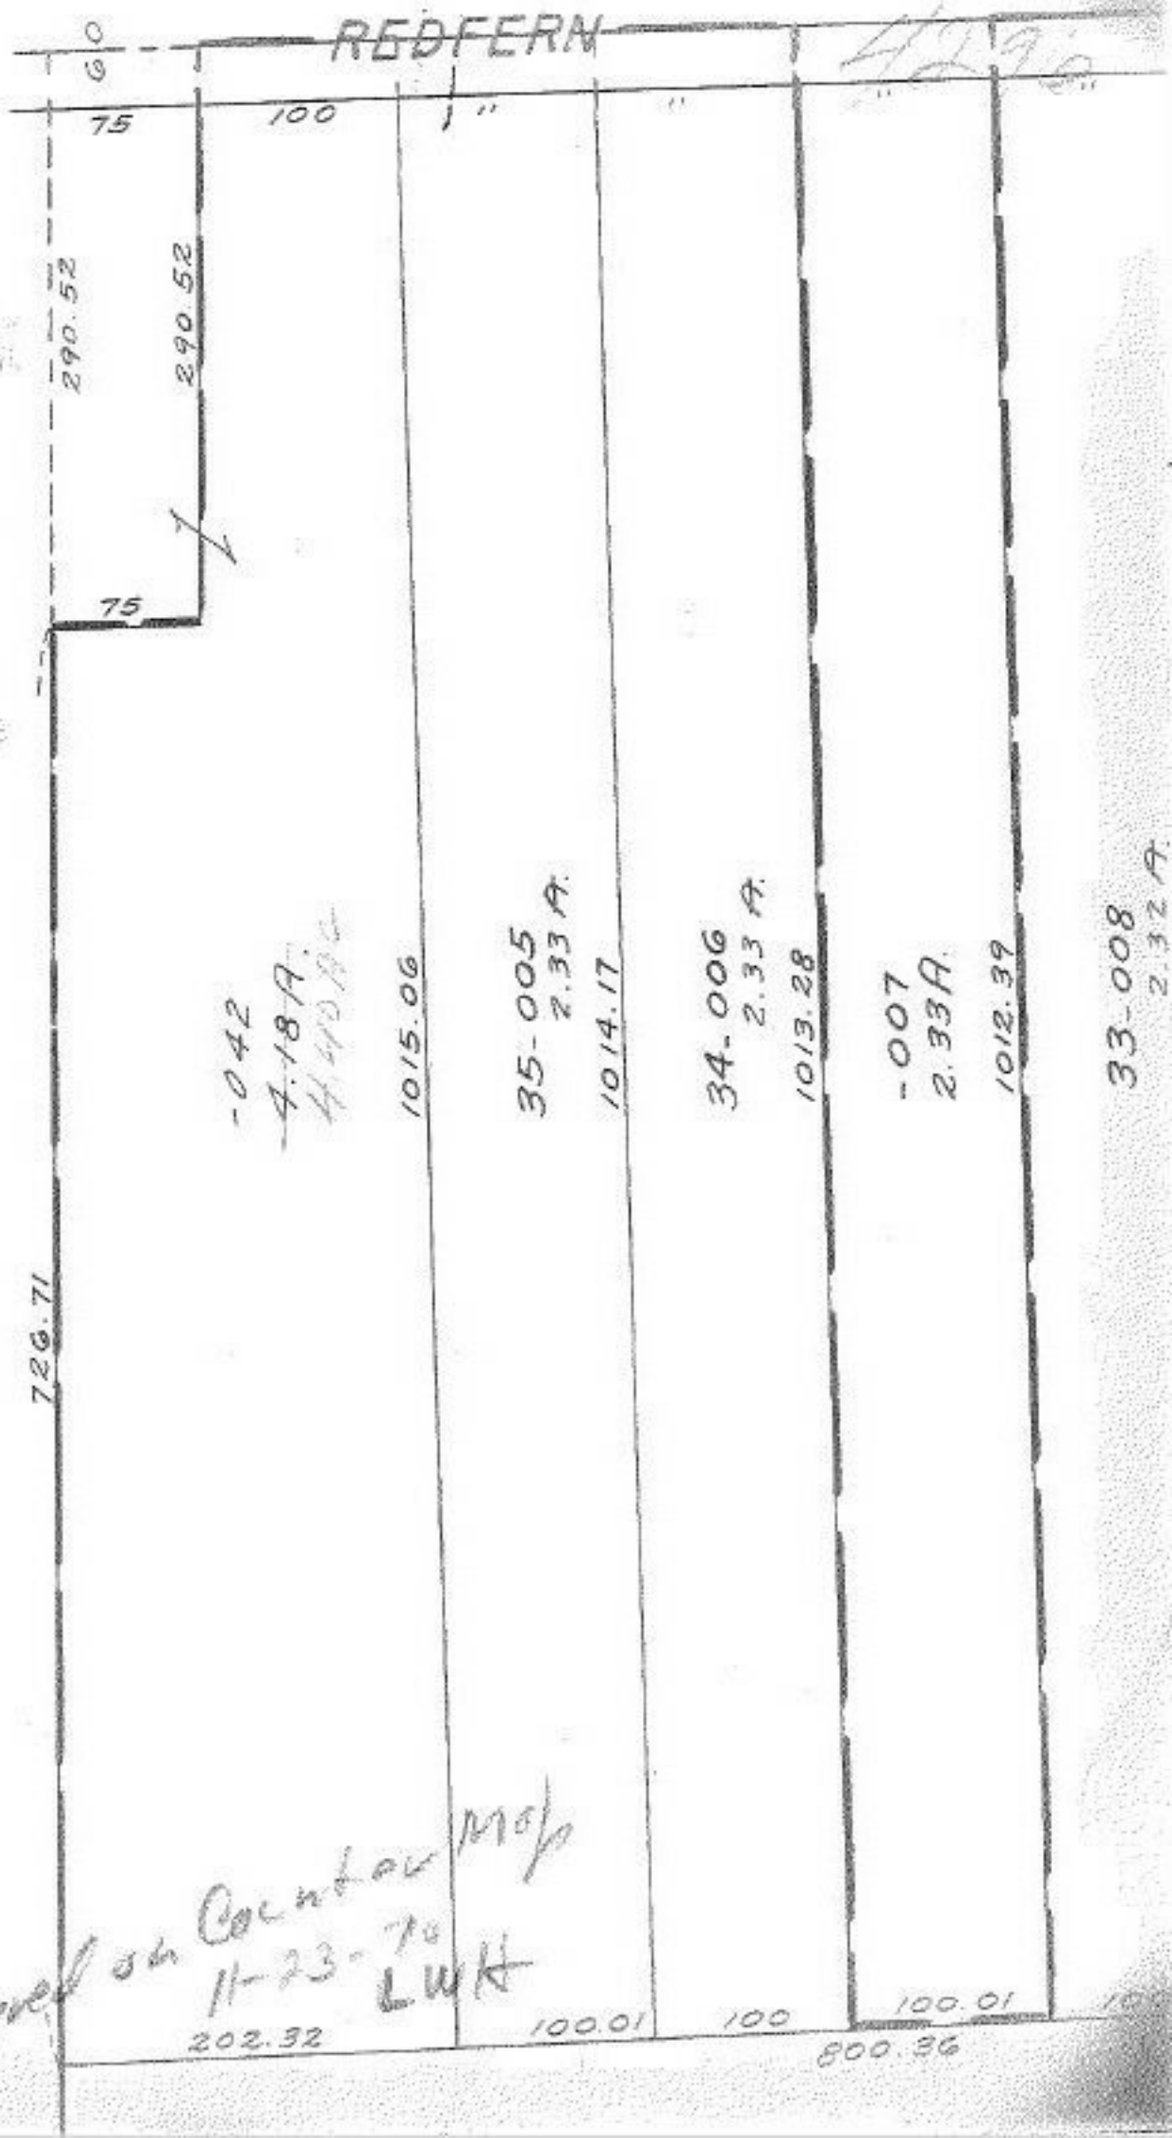

APPROVED
LORAIN CO.
MAP DEPT.
DATE 10-9-74
12-00-00213
BY LAH

Entered on Counter M&P
11-23-74 LWH