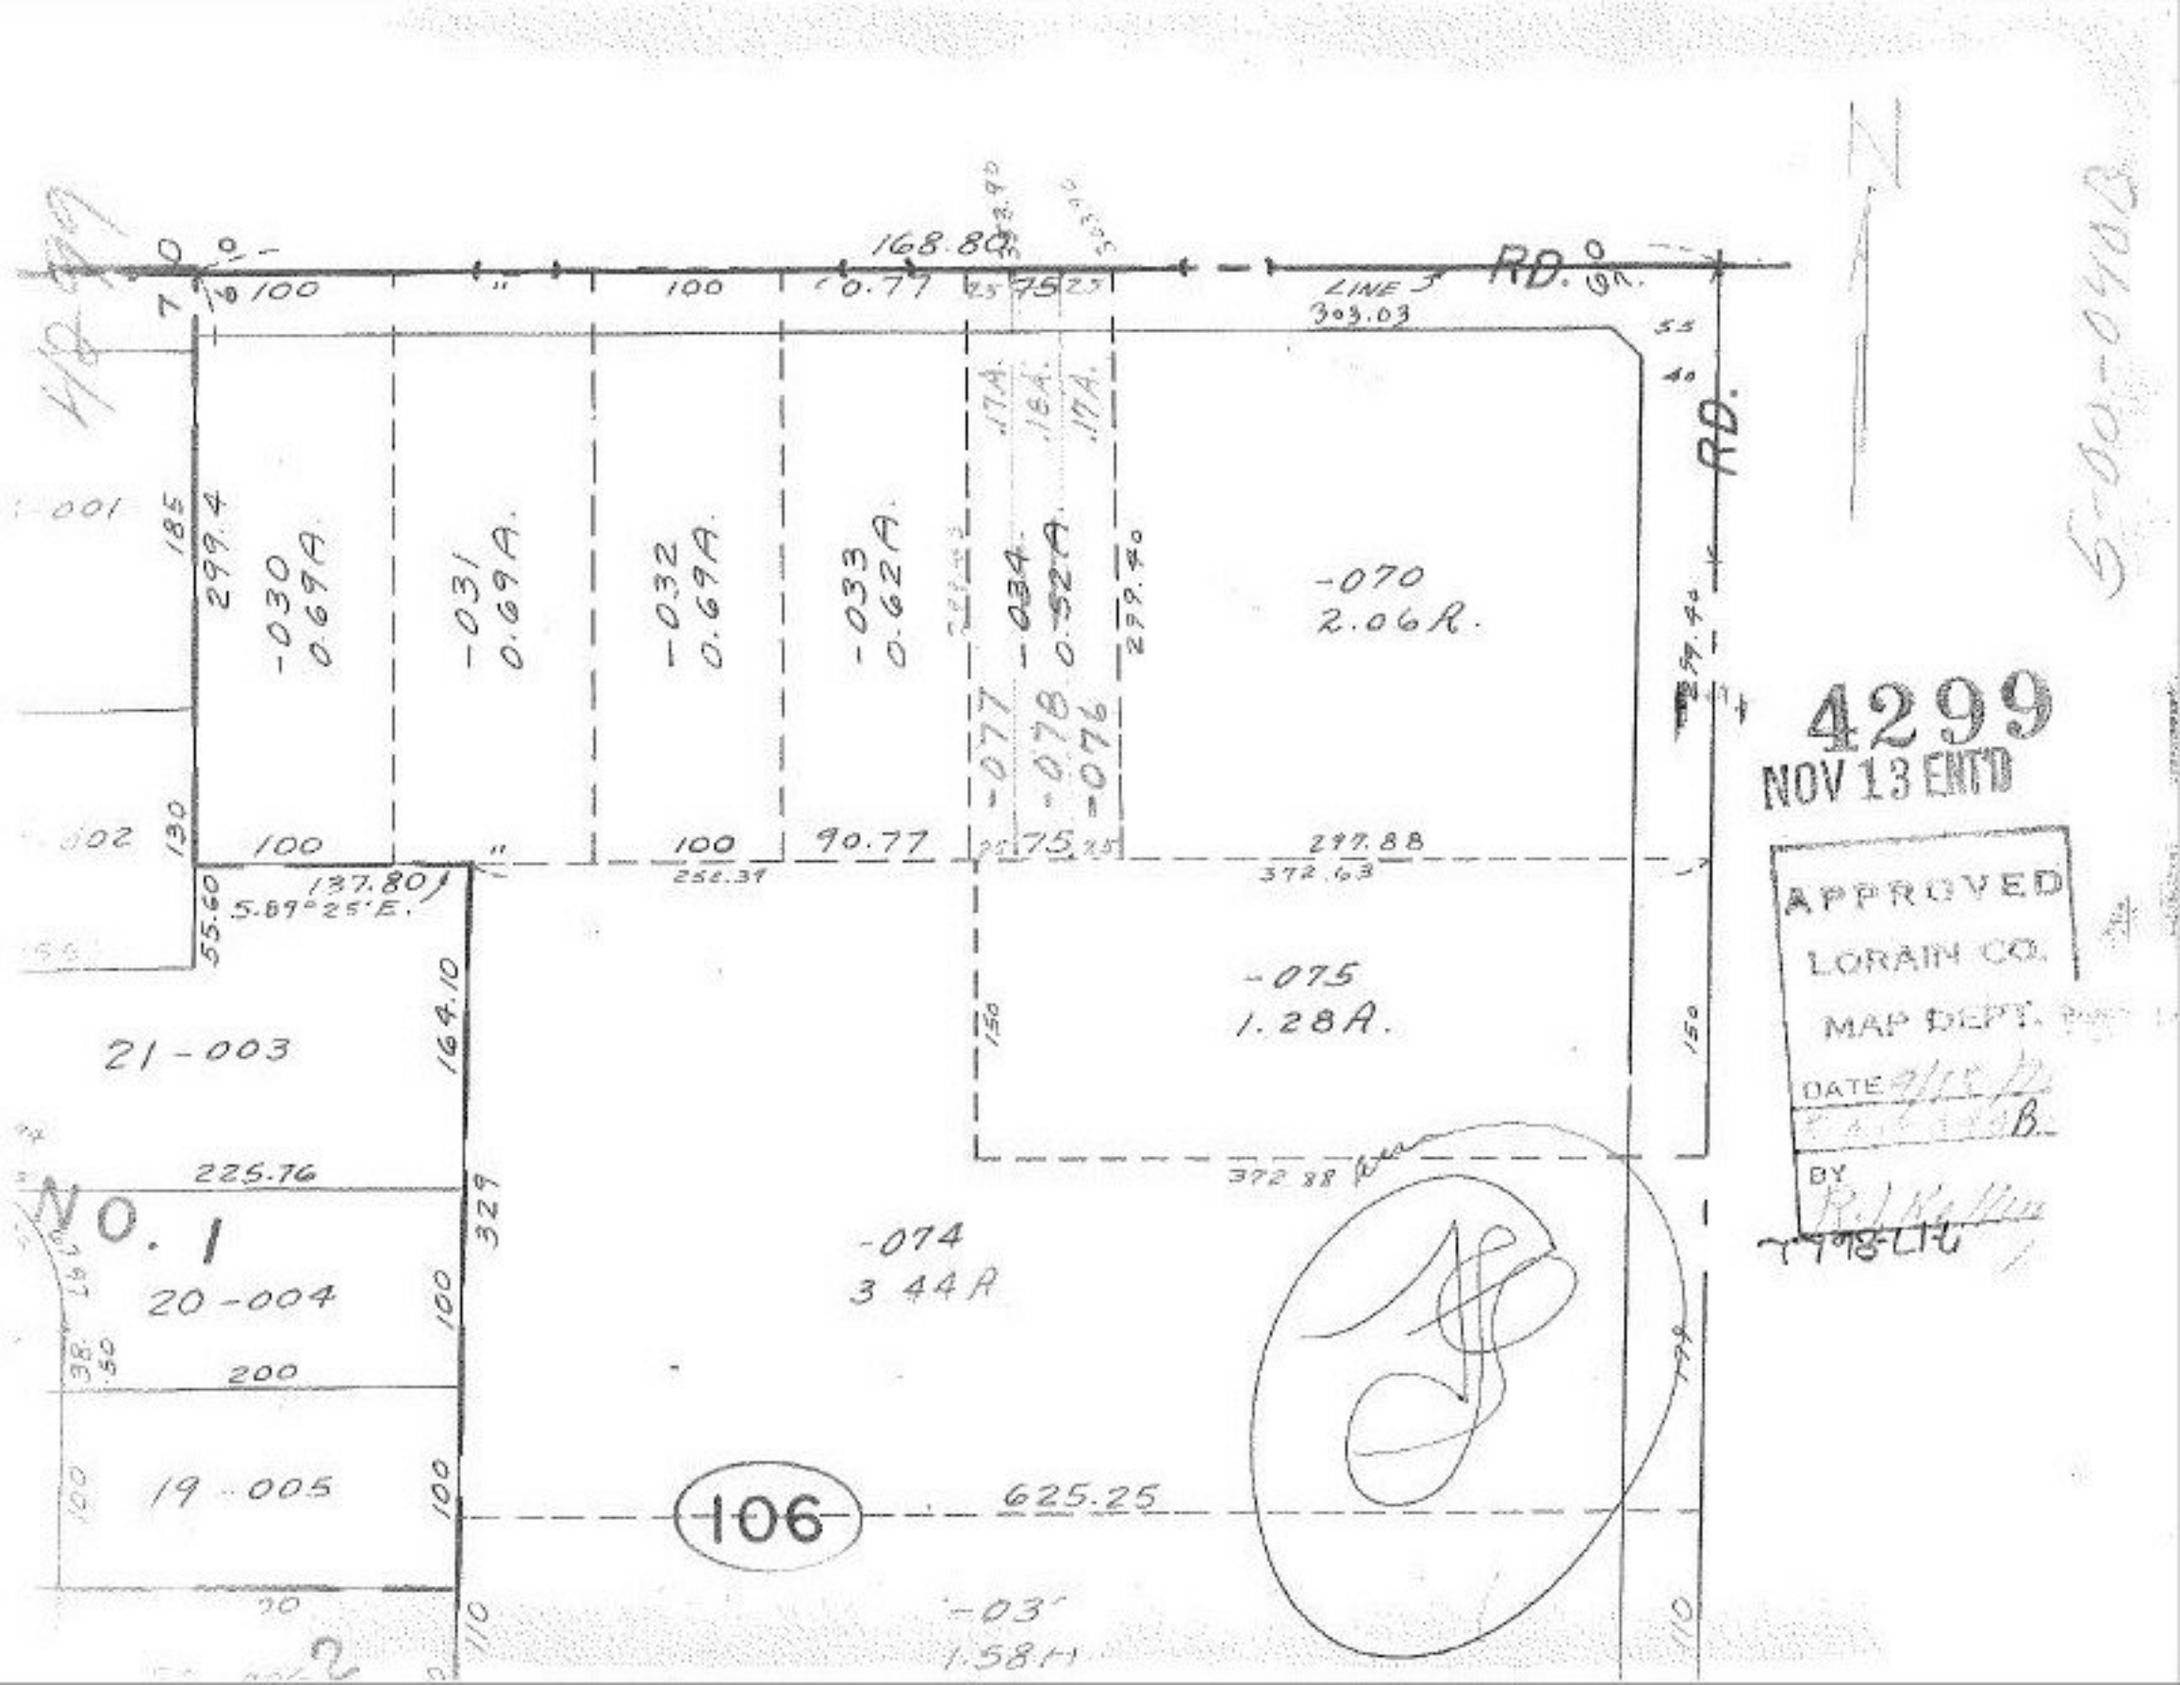
168.80
RD.
LINE 3
303.03
RD.
-030
0.69A
-031
0.69A
-032
0.69A
-033
0.62A
-034
0.52A
-077
-078
-076
-070
2.06A
-075
1.28A
-074
3.44A
-03
1.58A
21-003
20-004
19-005
NO. 1
106
625.25
297.88
372.63
90.77
137.80
5.89°25'E.
225.76
200
164.10
329
299.4
185
130
55.60
150
110
4299
NOV 13 ENT'D
APPROVED
LORAIN CO.
MAP DEPT.
DATE
BY