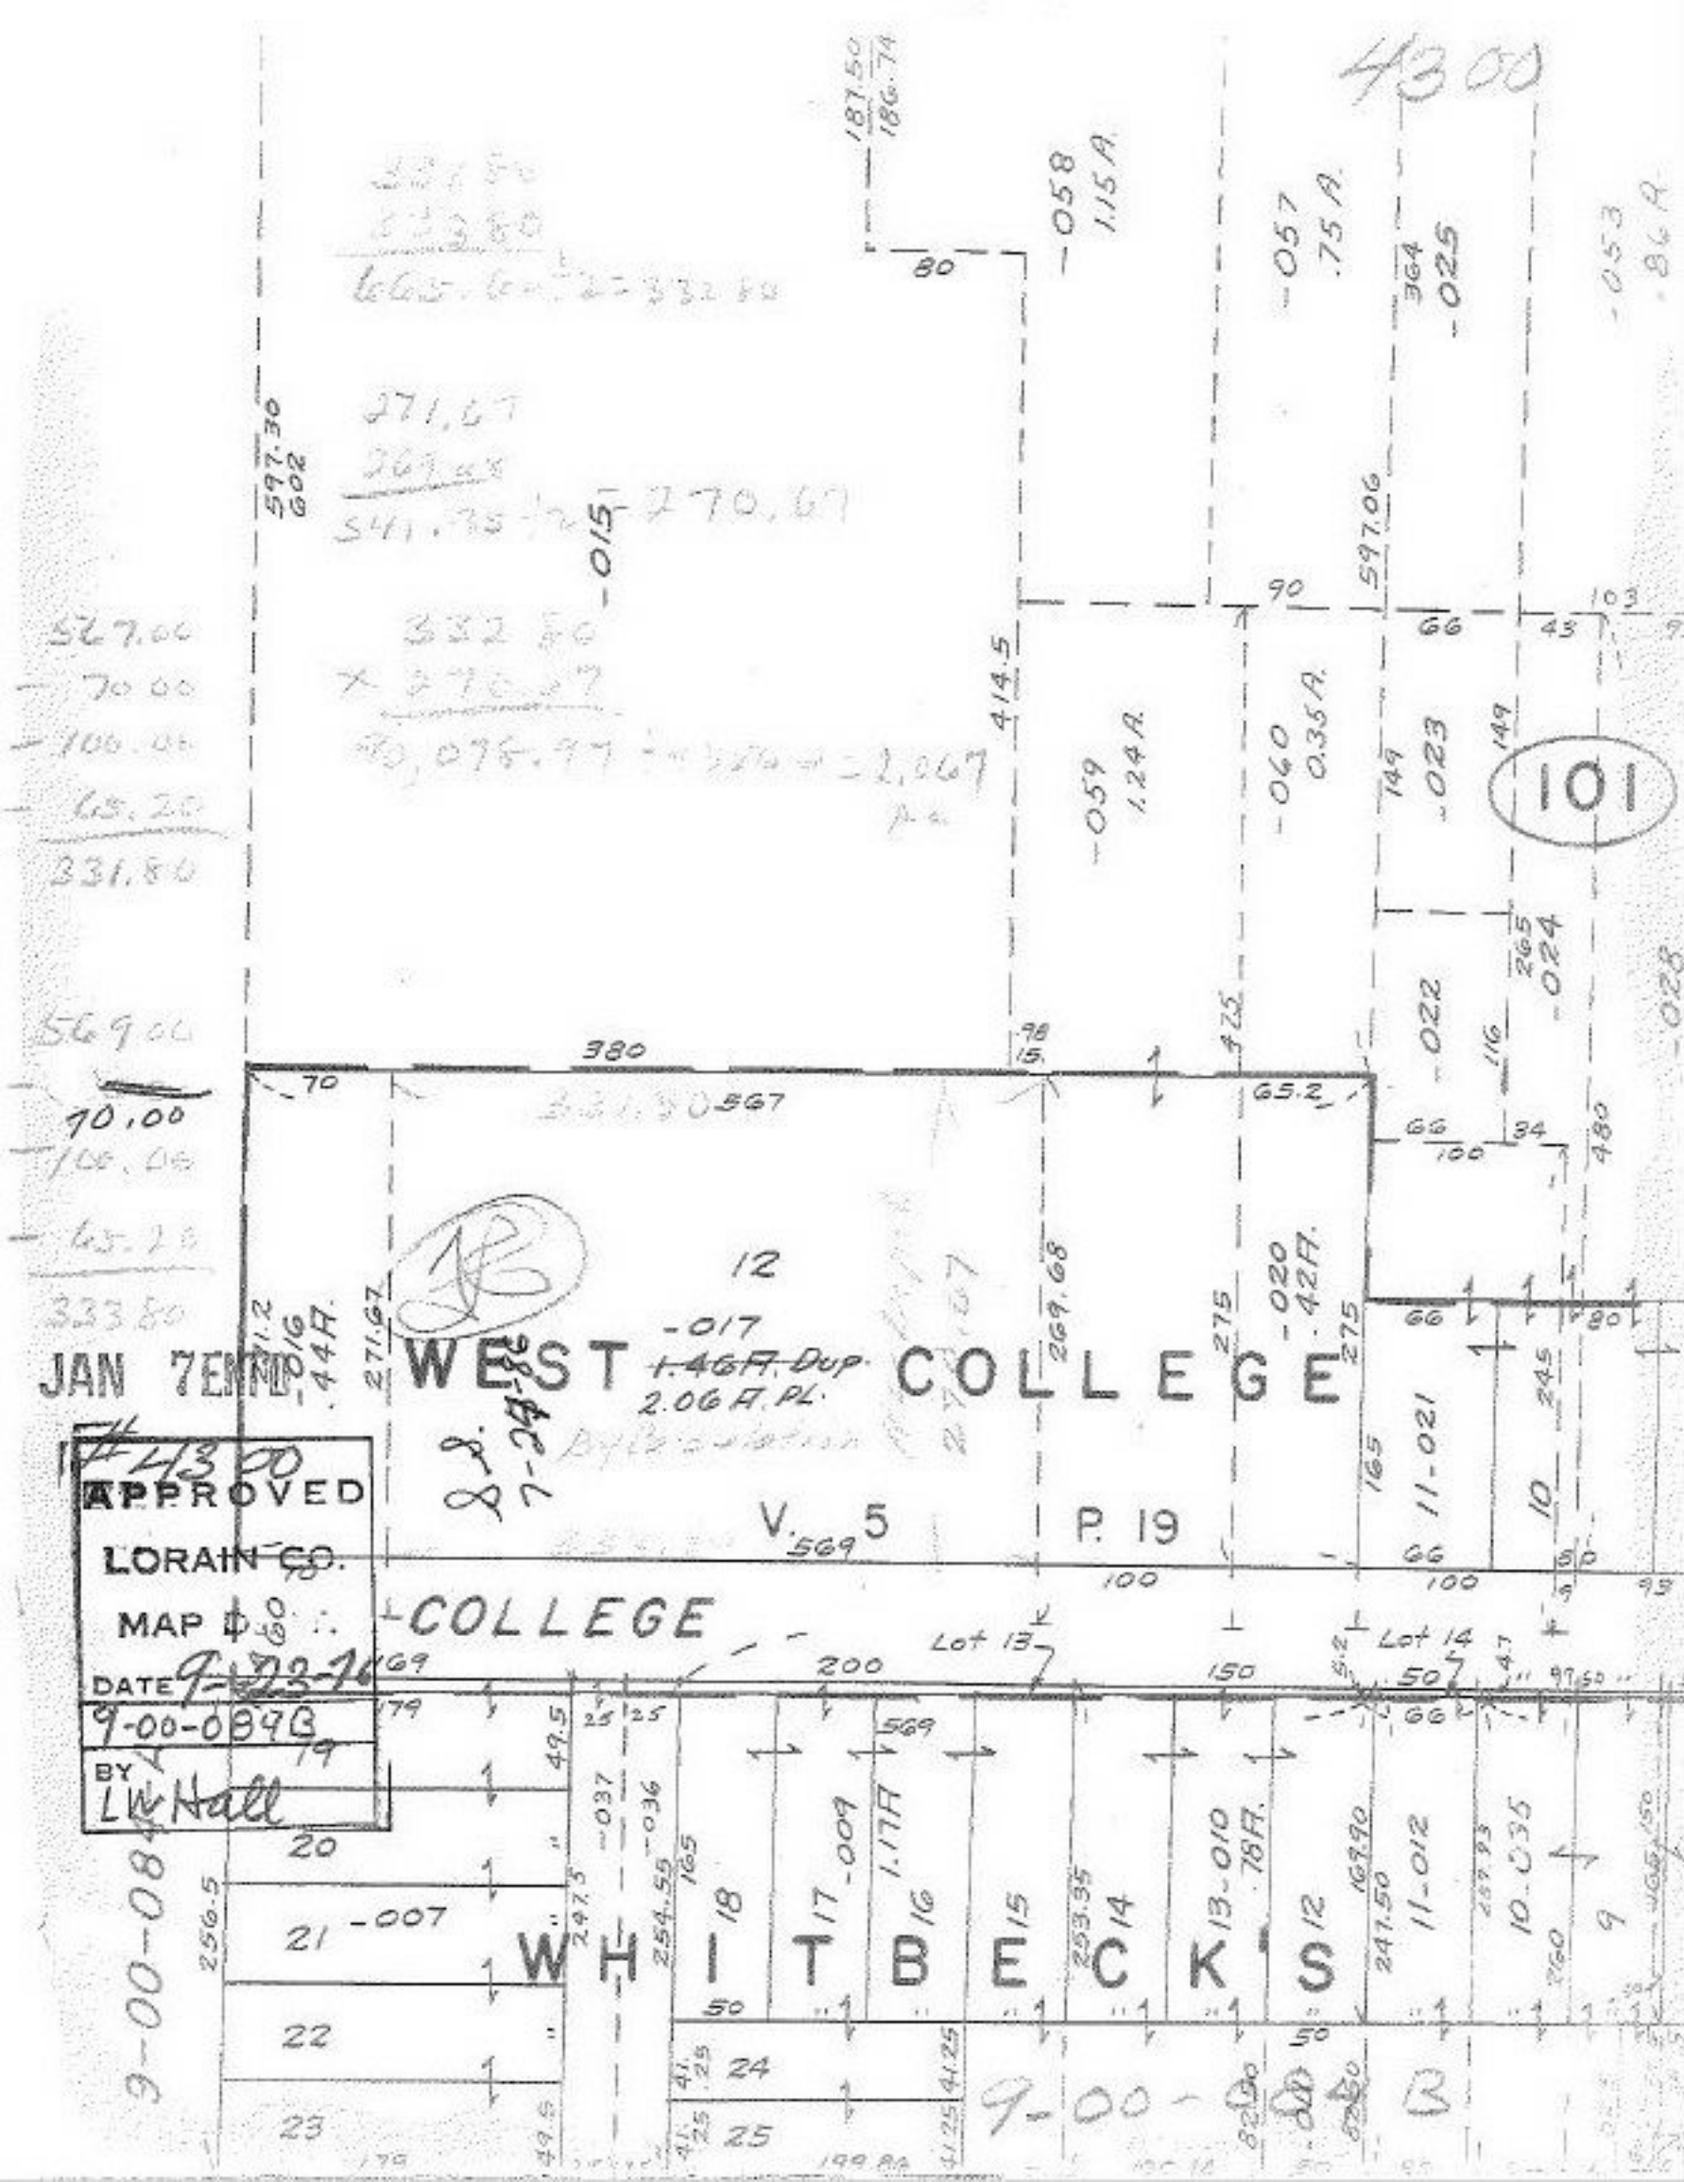

4300
101
WEST COLLEGE
V. 5 P. 19
COLLEGE
WHITBECK'S
JAN 7 ENTD
#4300
APPROVED
LORAIN CO.
MAP D
DATE 9-23-76
9-00-084B
BY LW Hall
9-00-084B