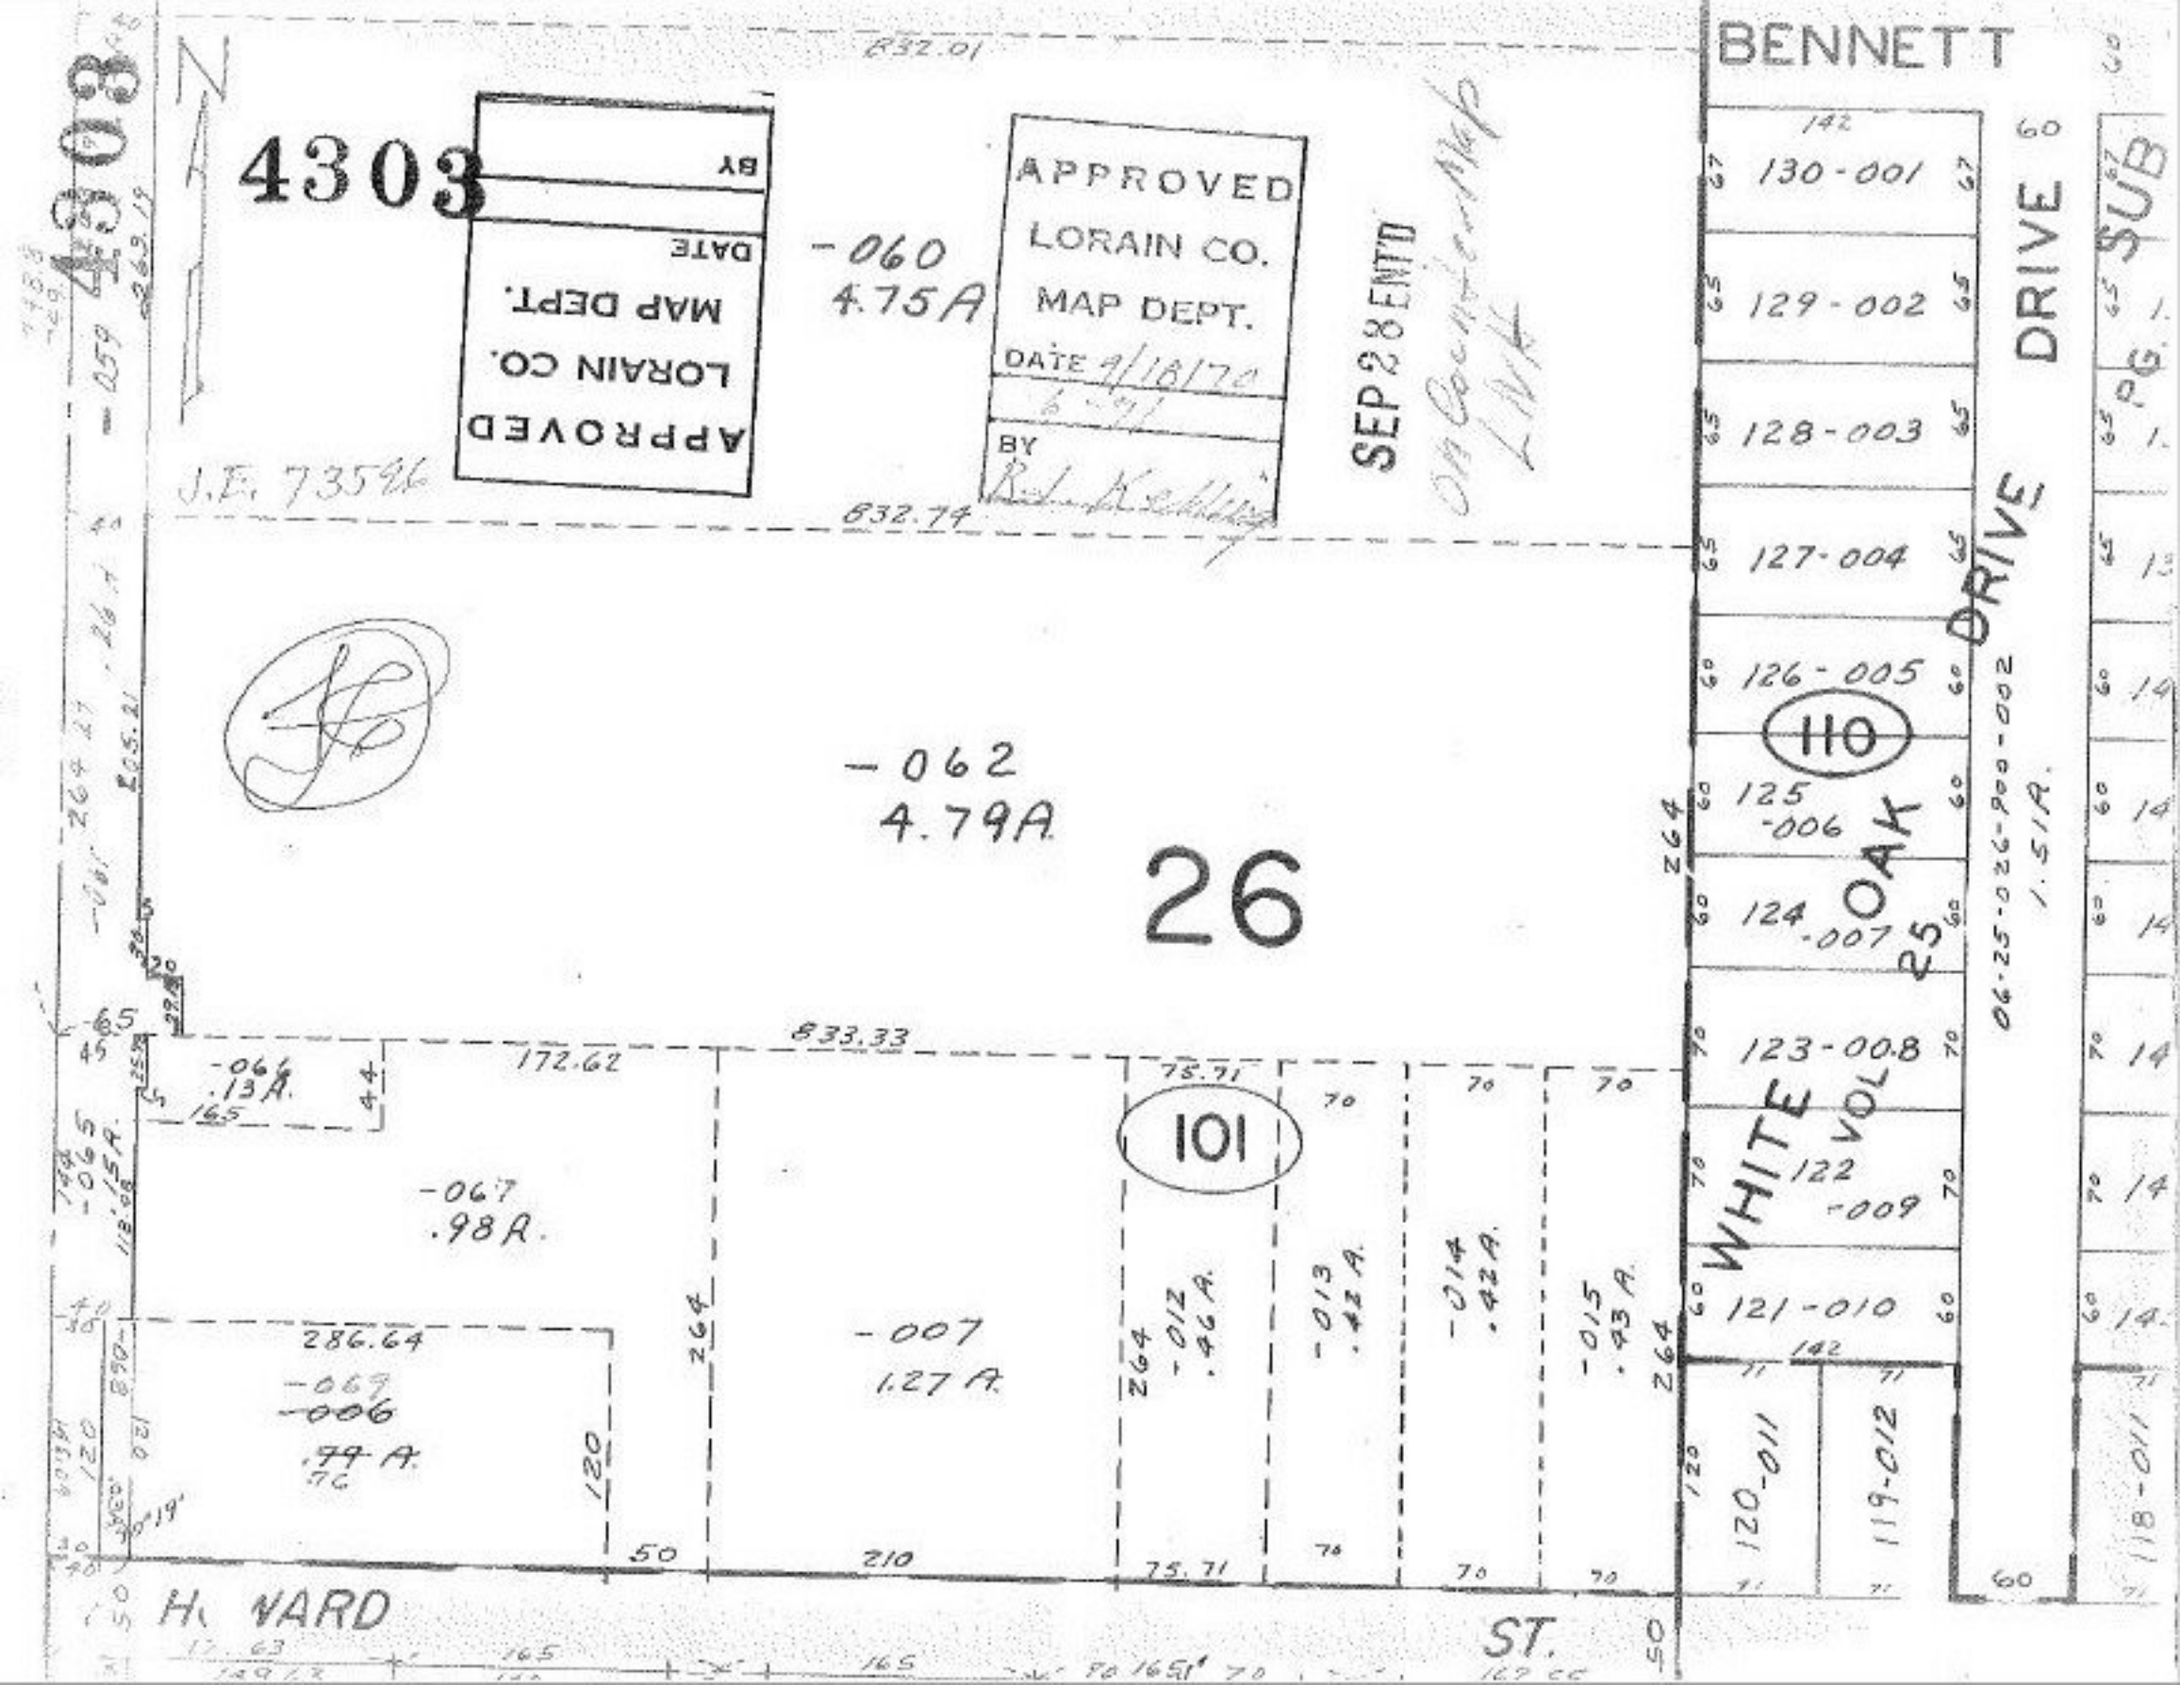
4303
APPROVED
LORAIN CO.
MAP DEPT.
DATE
BY
APPROVED
LORAIN CO.
MAP DEPT.
DATE 9/18/70
BY
SEP 28 ENT'D
J.E. 73596
-060
4.75A
-062
4.79A
26
832.01
832.74
833.33
172.62
286.64
-066
.13A.
-067
.98A.
-069
-006
.79 A.
-007
1.27 A.
-012
.46 A.
-013
.42 A.
-014
.42 A.
-015
.43 A.
101
110
BENNETT
DRIVE
WHITE OAK DRIVE
VOL 25
130-001
129-002
128-003
127-004
126-005
125-006
124-007
123-008
122-009
121-010
120-011
119-012
118-011
06-25-026-900-002
1.51A.
HOWARD
ST.