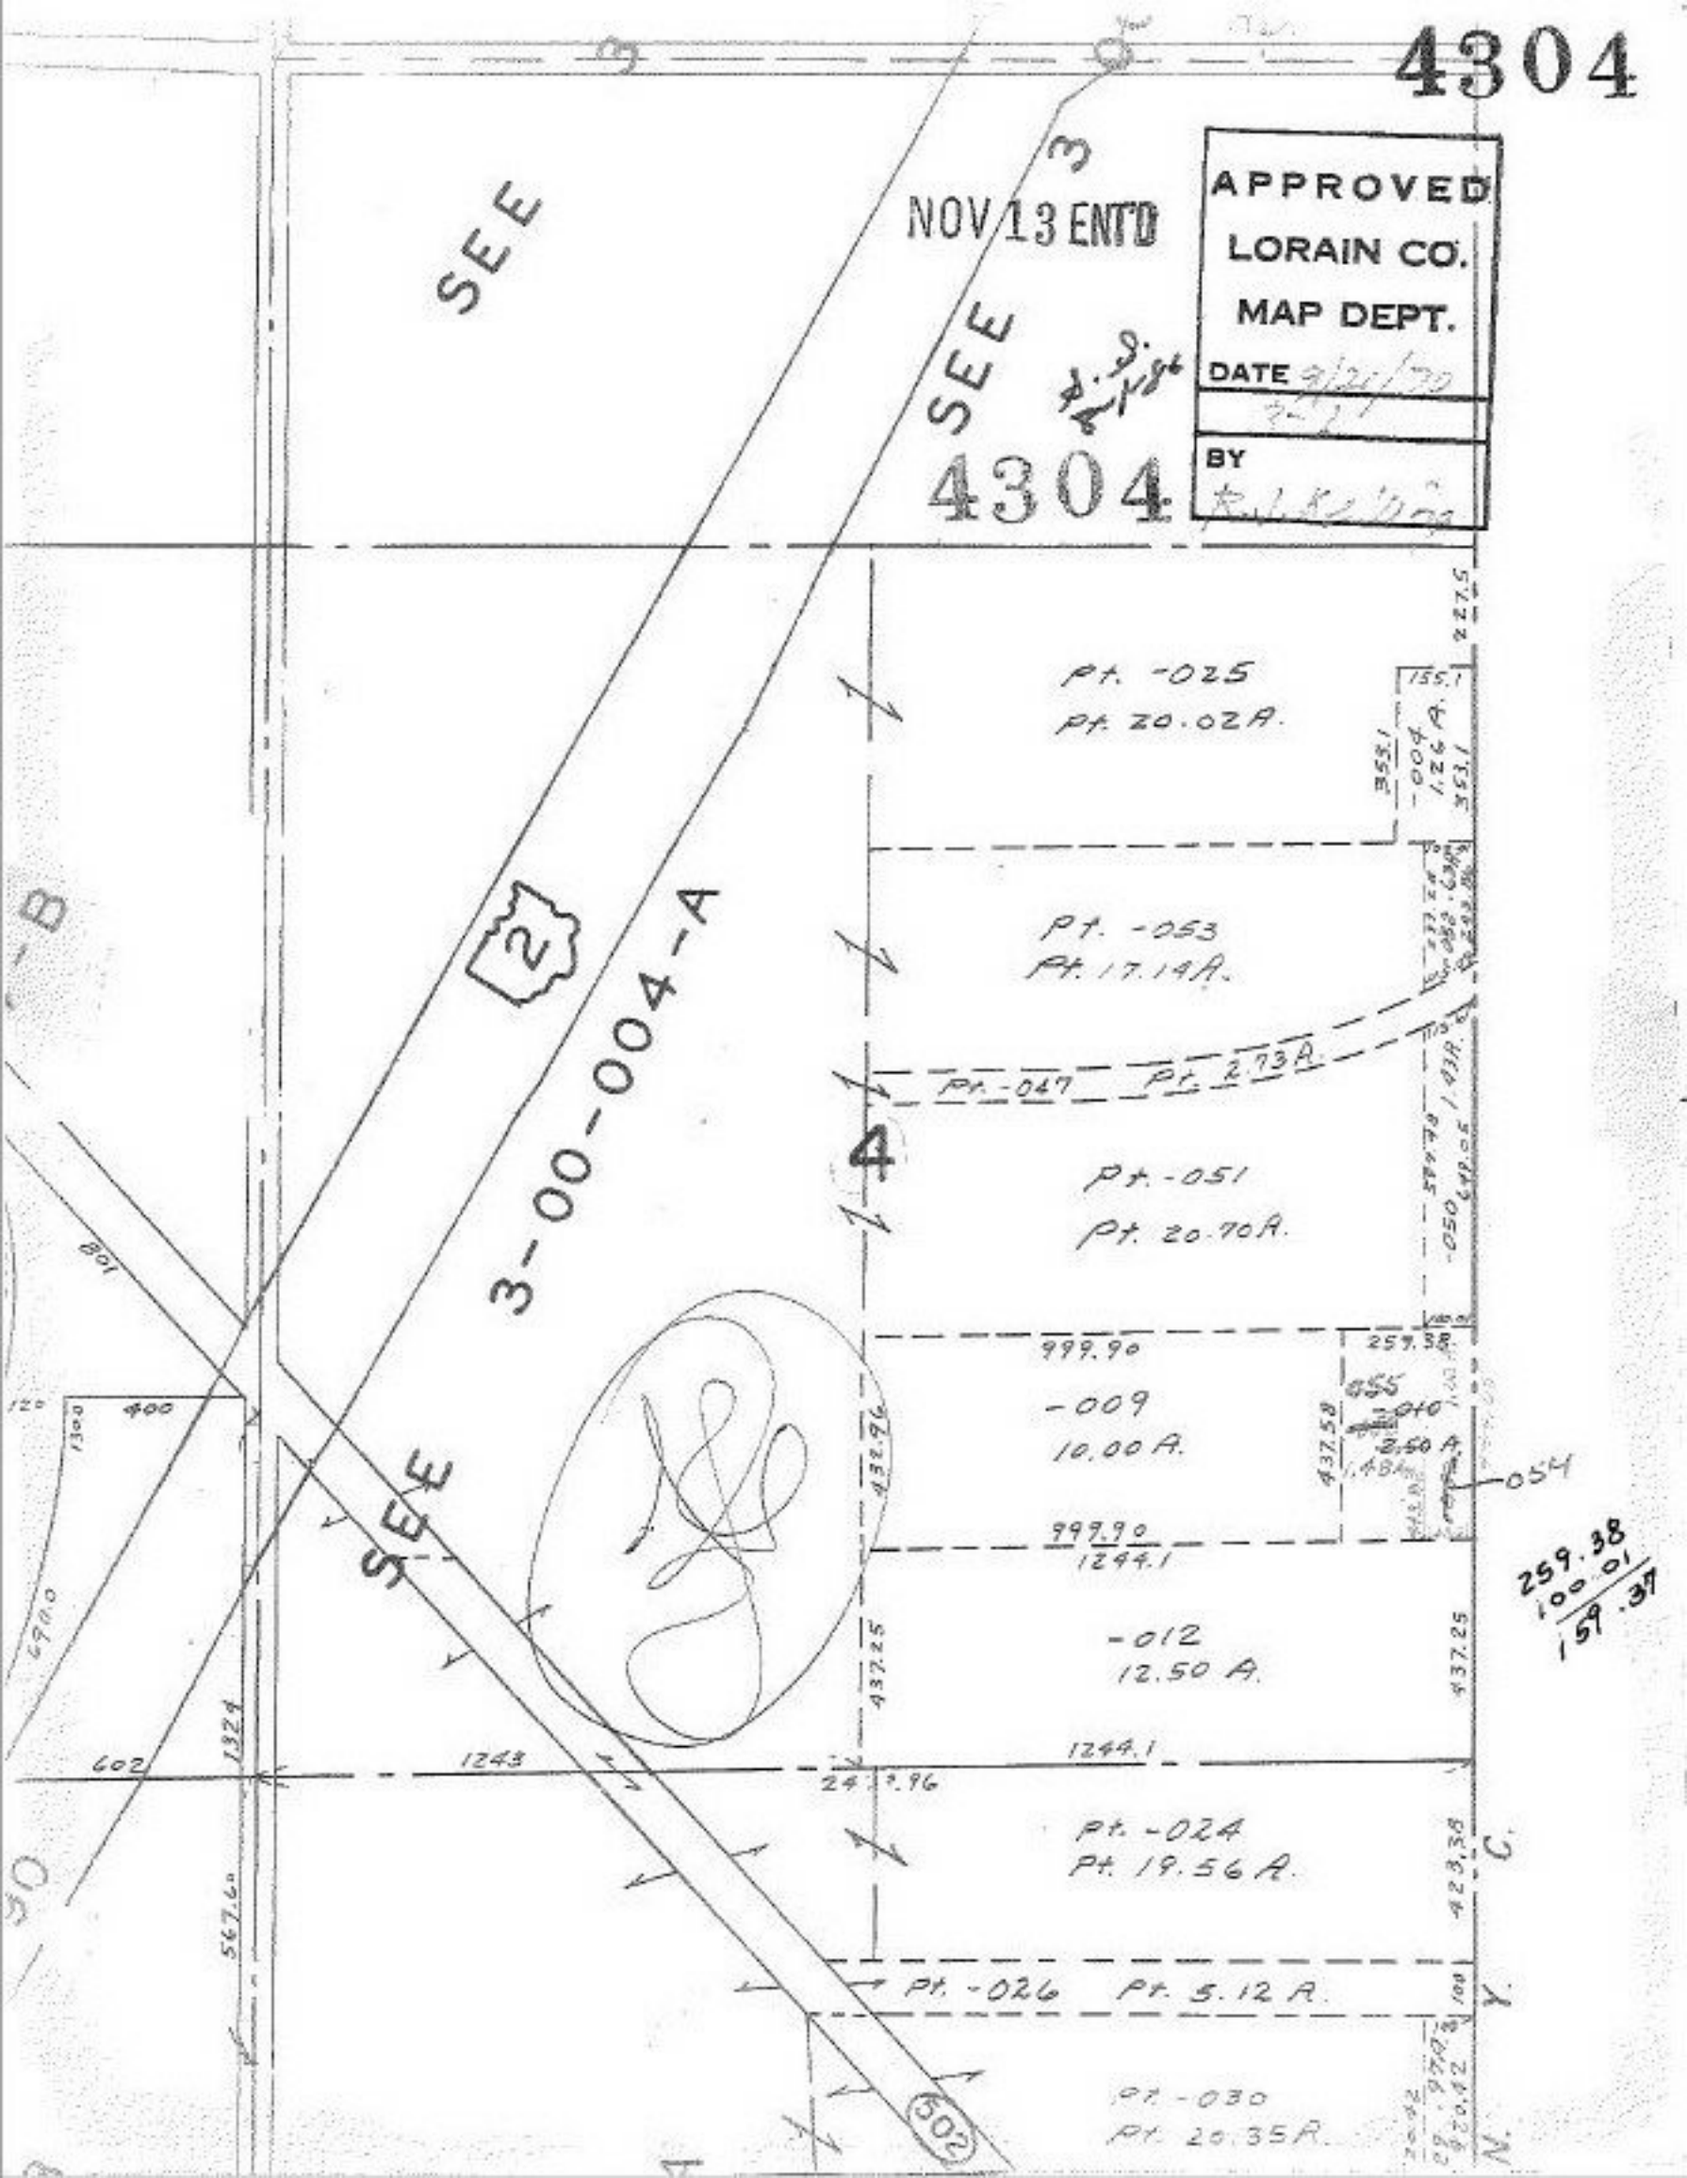
4304
NOV 13 ENT'D
APPROVED
LORAIN CO.
MAP DEPT.
DATE
BY
4304
SEE
SEE
SEE
3-00-004-A
2
4
Pt. -025
Pt. 20.02A.
Pt. -053
Pt. 17.14A.
Pt. -047 Pt. 2.73A.
Pt. -051
Pt. 20.70A.
999.90
-009
10.00 A.
999.90
1244.1
-012
12.50 A.
1244.1
Pt. -024
Pt. 19.56 A.
Pt. -026 Pt. 5.12 A.
Pt. -030
Pt. 20.35A.
-004
1.26 A.
-050
-054
259.38
100.01
159.37
227.5
155.1
353.1
259.38
437.58
432.96
437.25
423.38
1243
1324
567.60
602
400
801
690.0
502
N.
Y.
C.