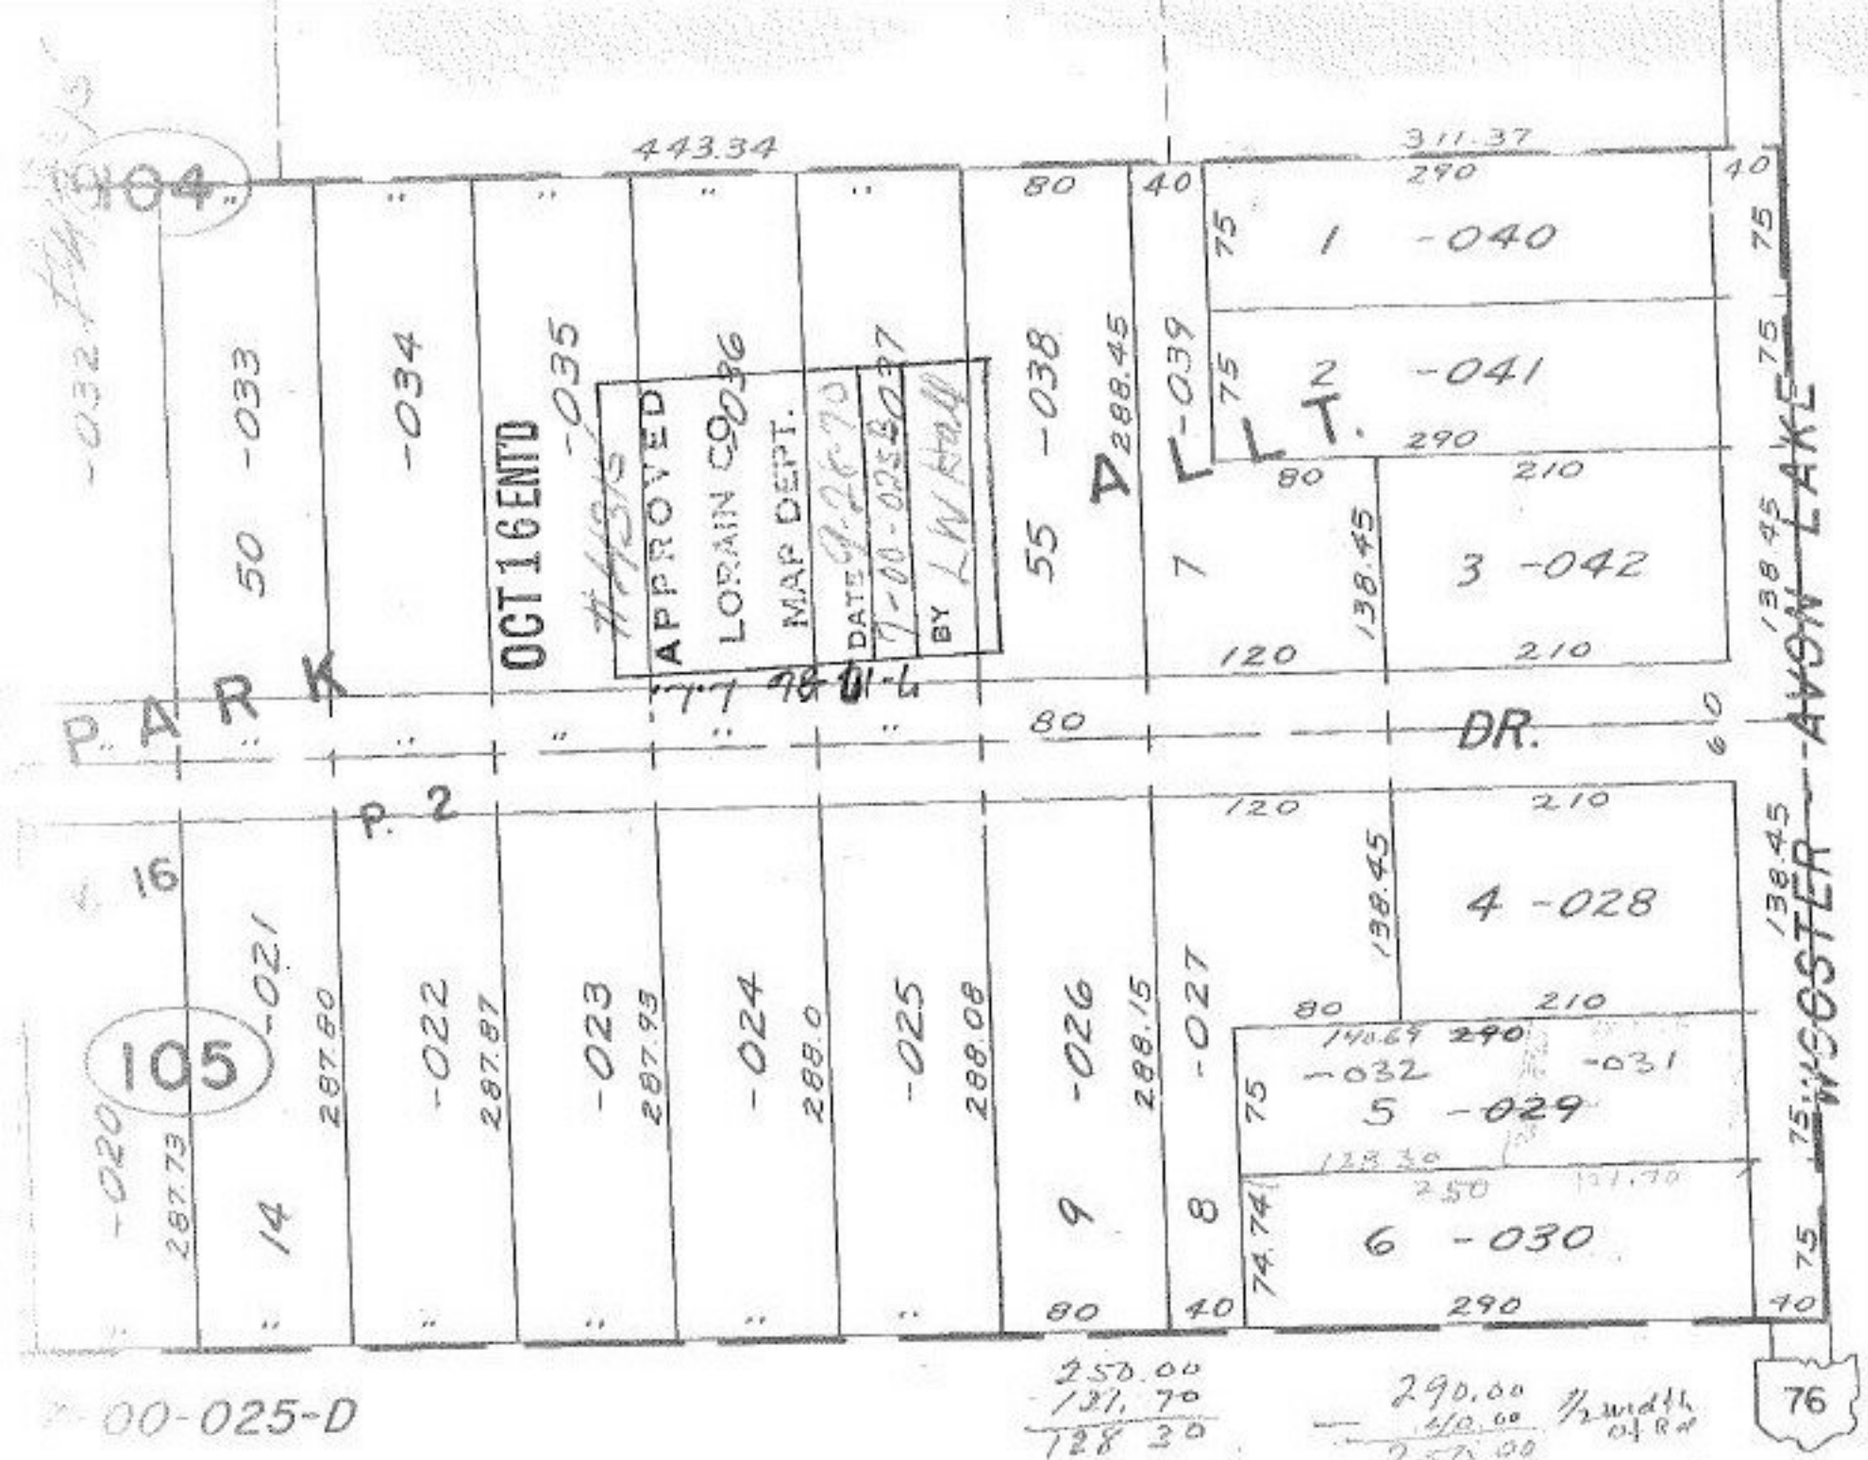

00-025-D

250.00
131.70
128 30

290.00
40.00
250.00
109.36
140.64

1/2 width of Rd

Copyright