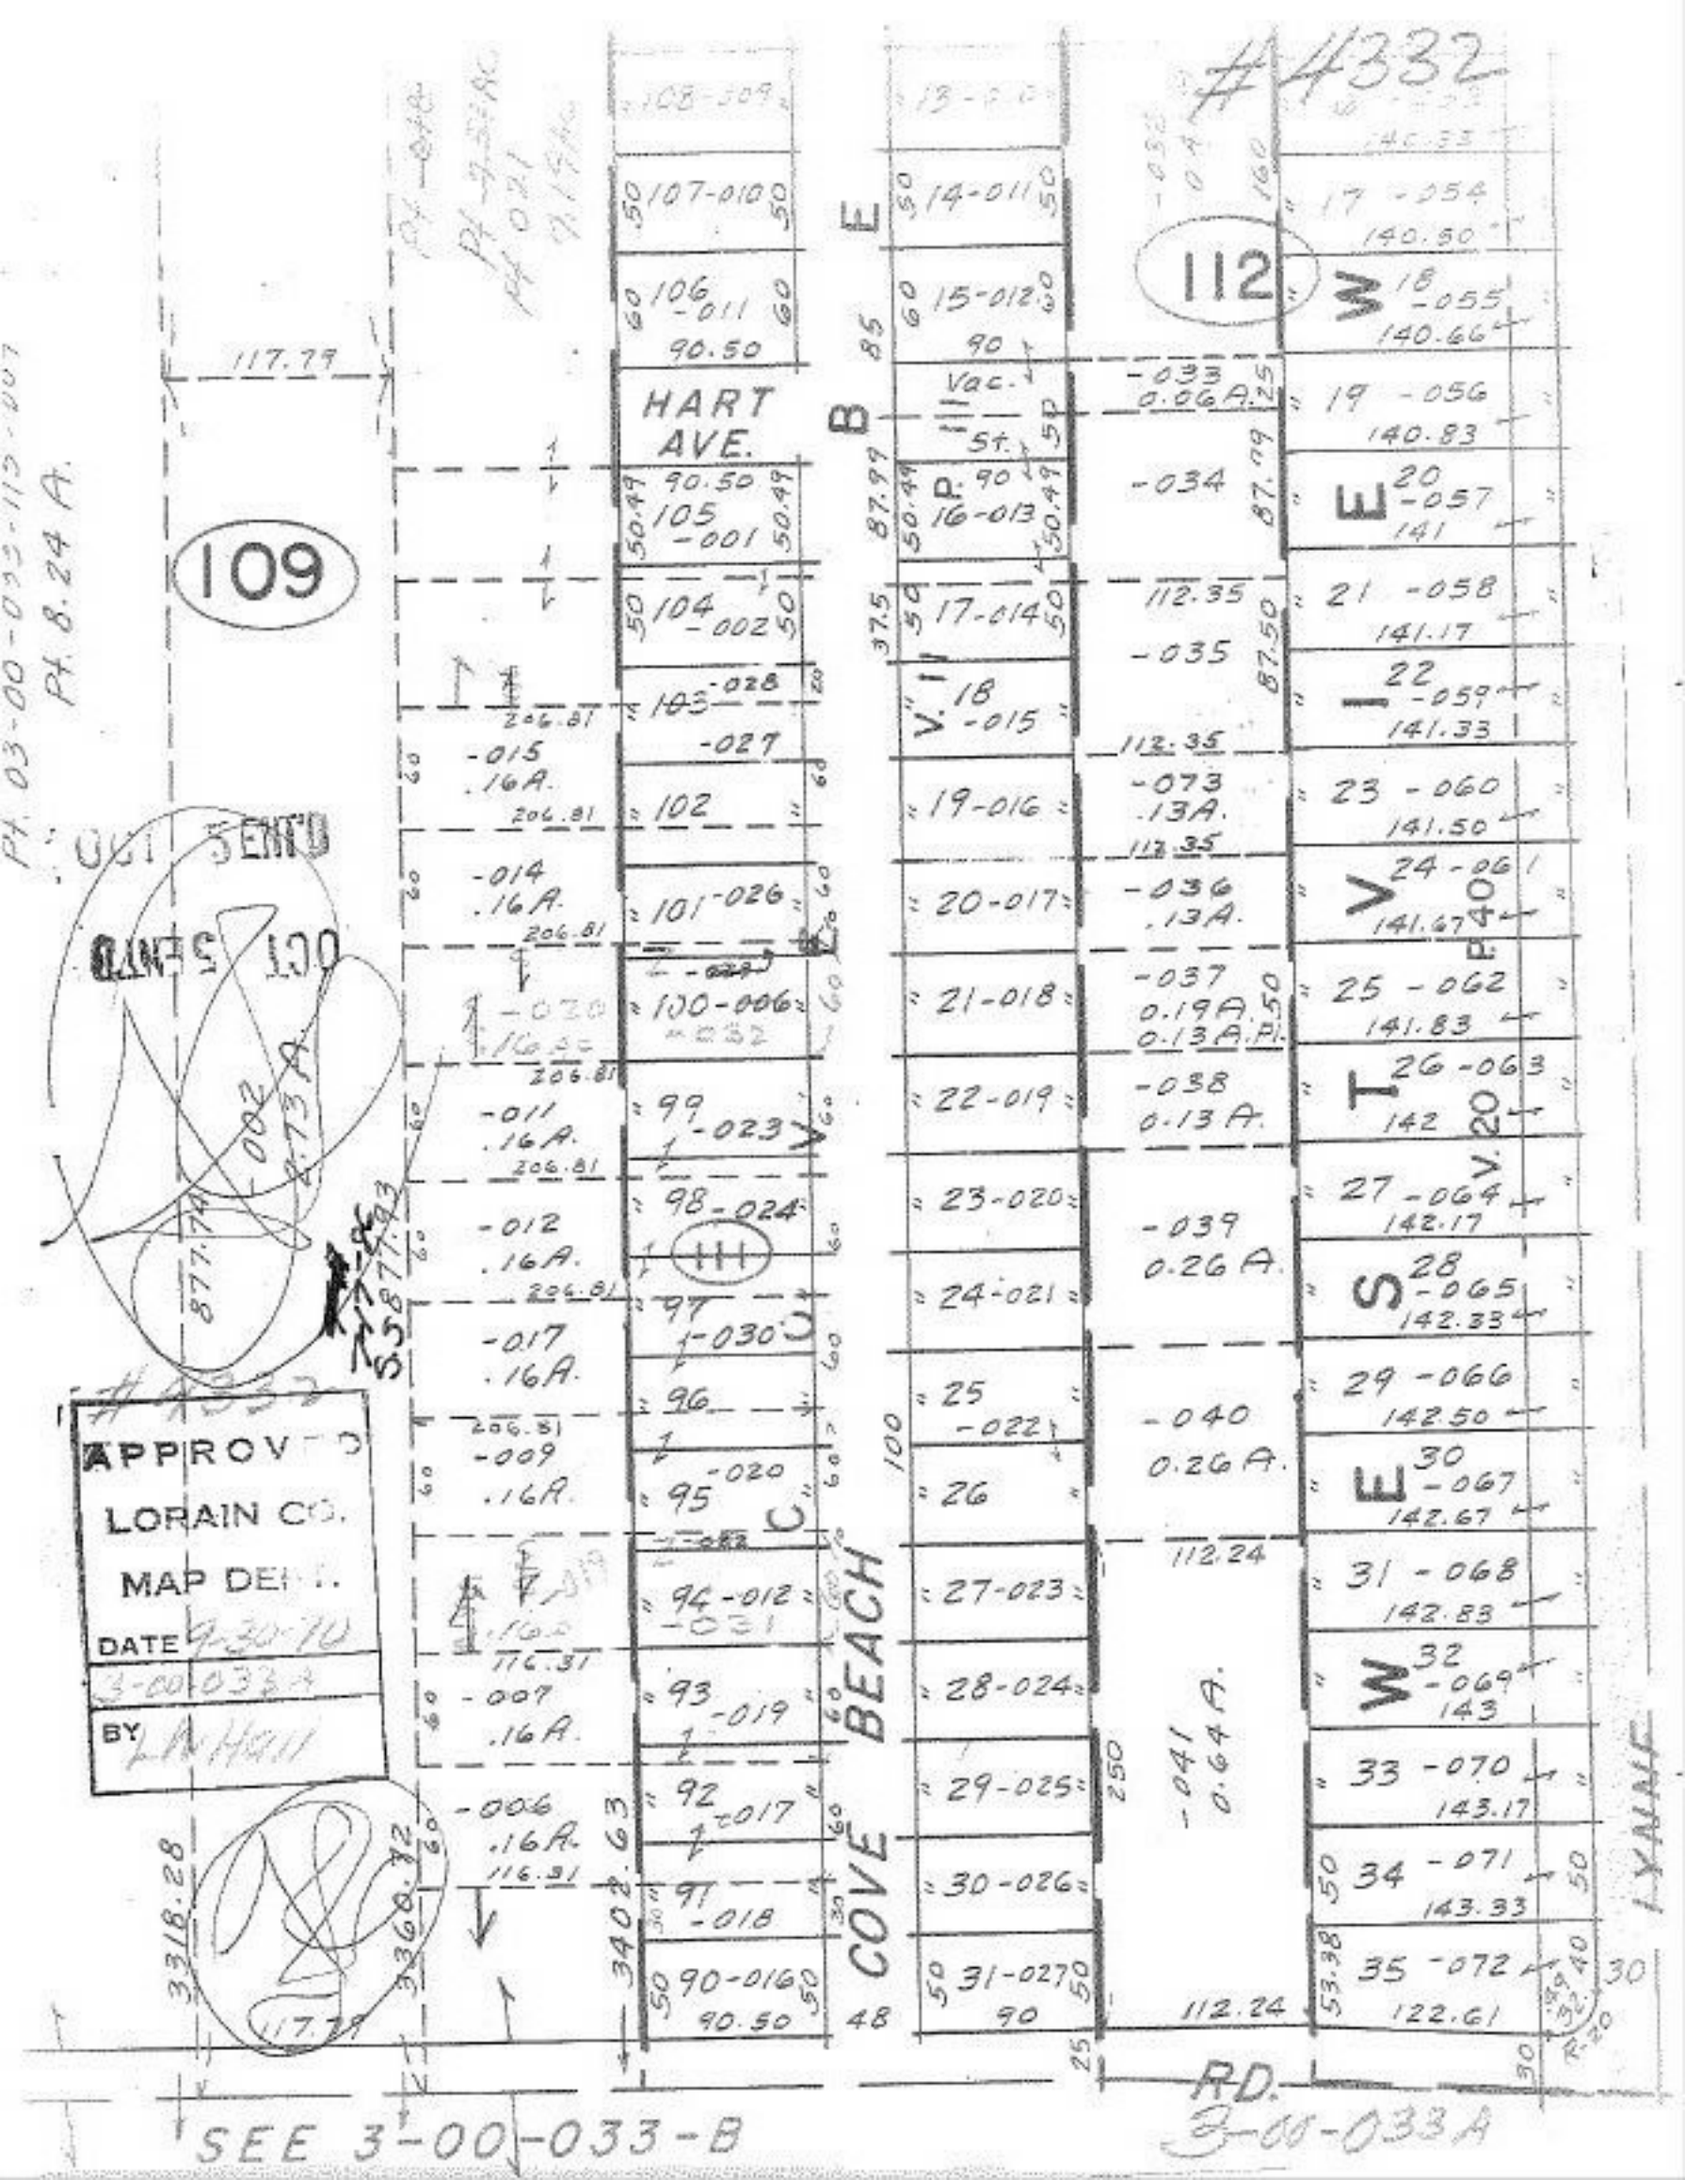
#4332
109
112
HART AVE.
COVE BEACH
LYNDALE
RD.
APPROVED
LORAIN CO.
MAP DEPT.
DATE 9-30-70
3-00-033-A
BY L.A. Hall
SEE 3-00-033-B
3-00-033A
117.79
877.74
3318.28
3360.72
3402.63
206.81
116.31
90.50
140.50
140.66
140.83
141
141.17
141.33
141.50
141.67
141.83
142
142.17
142.33
142.50
142.67
142.83
143
143.17
143.33
122.61
112.24
112.35
206.81
87.99
87.09
87.50
100
250
48
25
30
32.40
53.38
PL. 03-00-033-113-007
PL. 8.24 A.
PL. 7.32 AC.
PL. 0.21 AC.
