


7-17-86 L-1

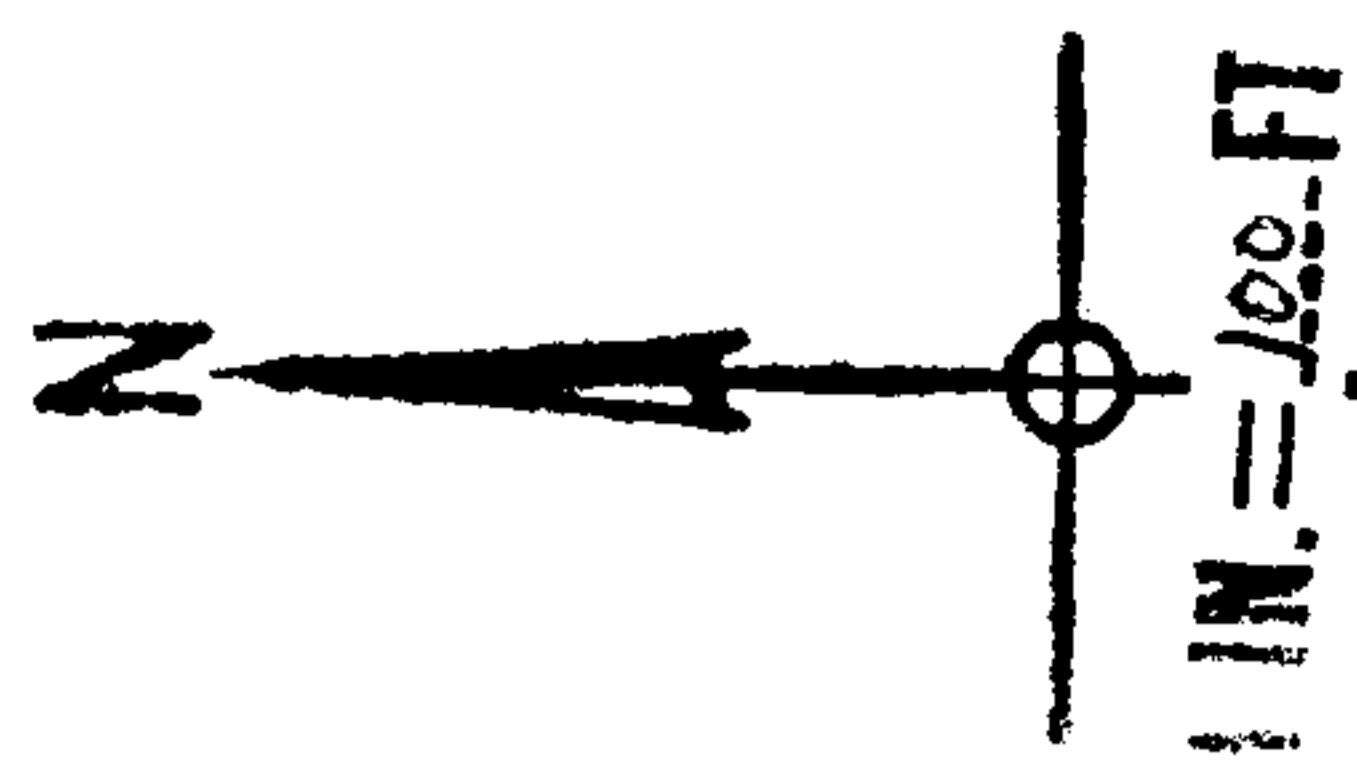


OCT 26 1960

4342
4341

APPROVED
LORAIN CO.
MAP DEPT.
DATE 10-5-70
4-00-015-B
BY *H. H. H. H.*

4343

-015-C

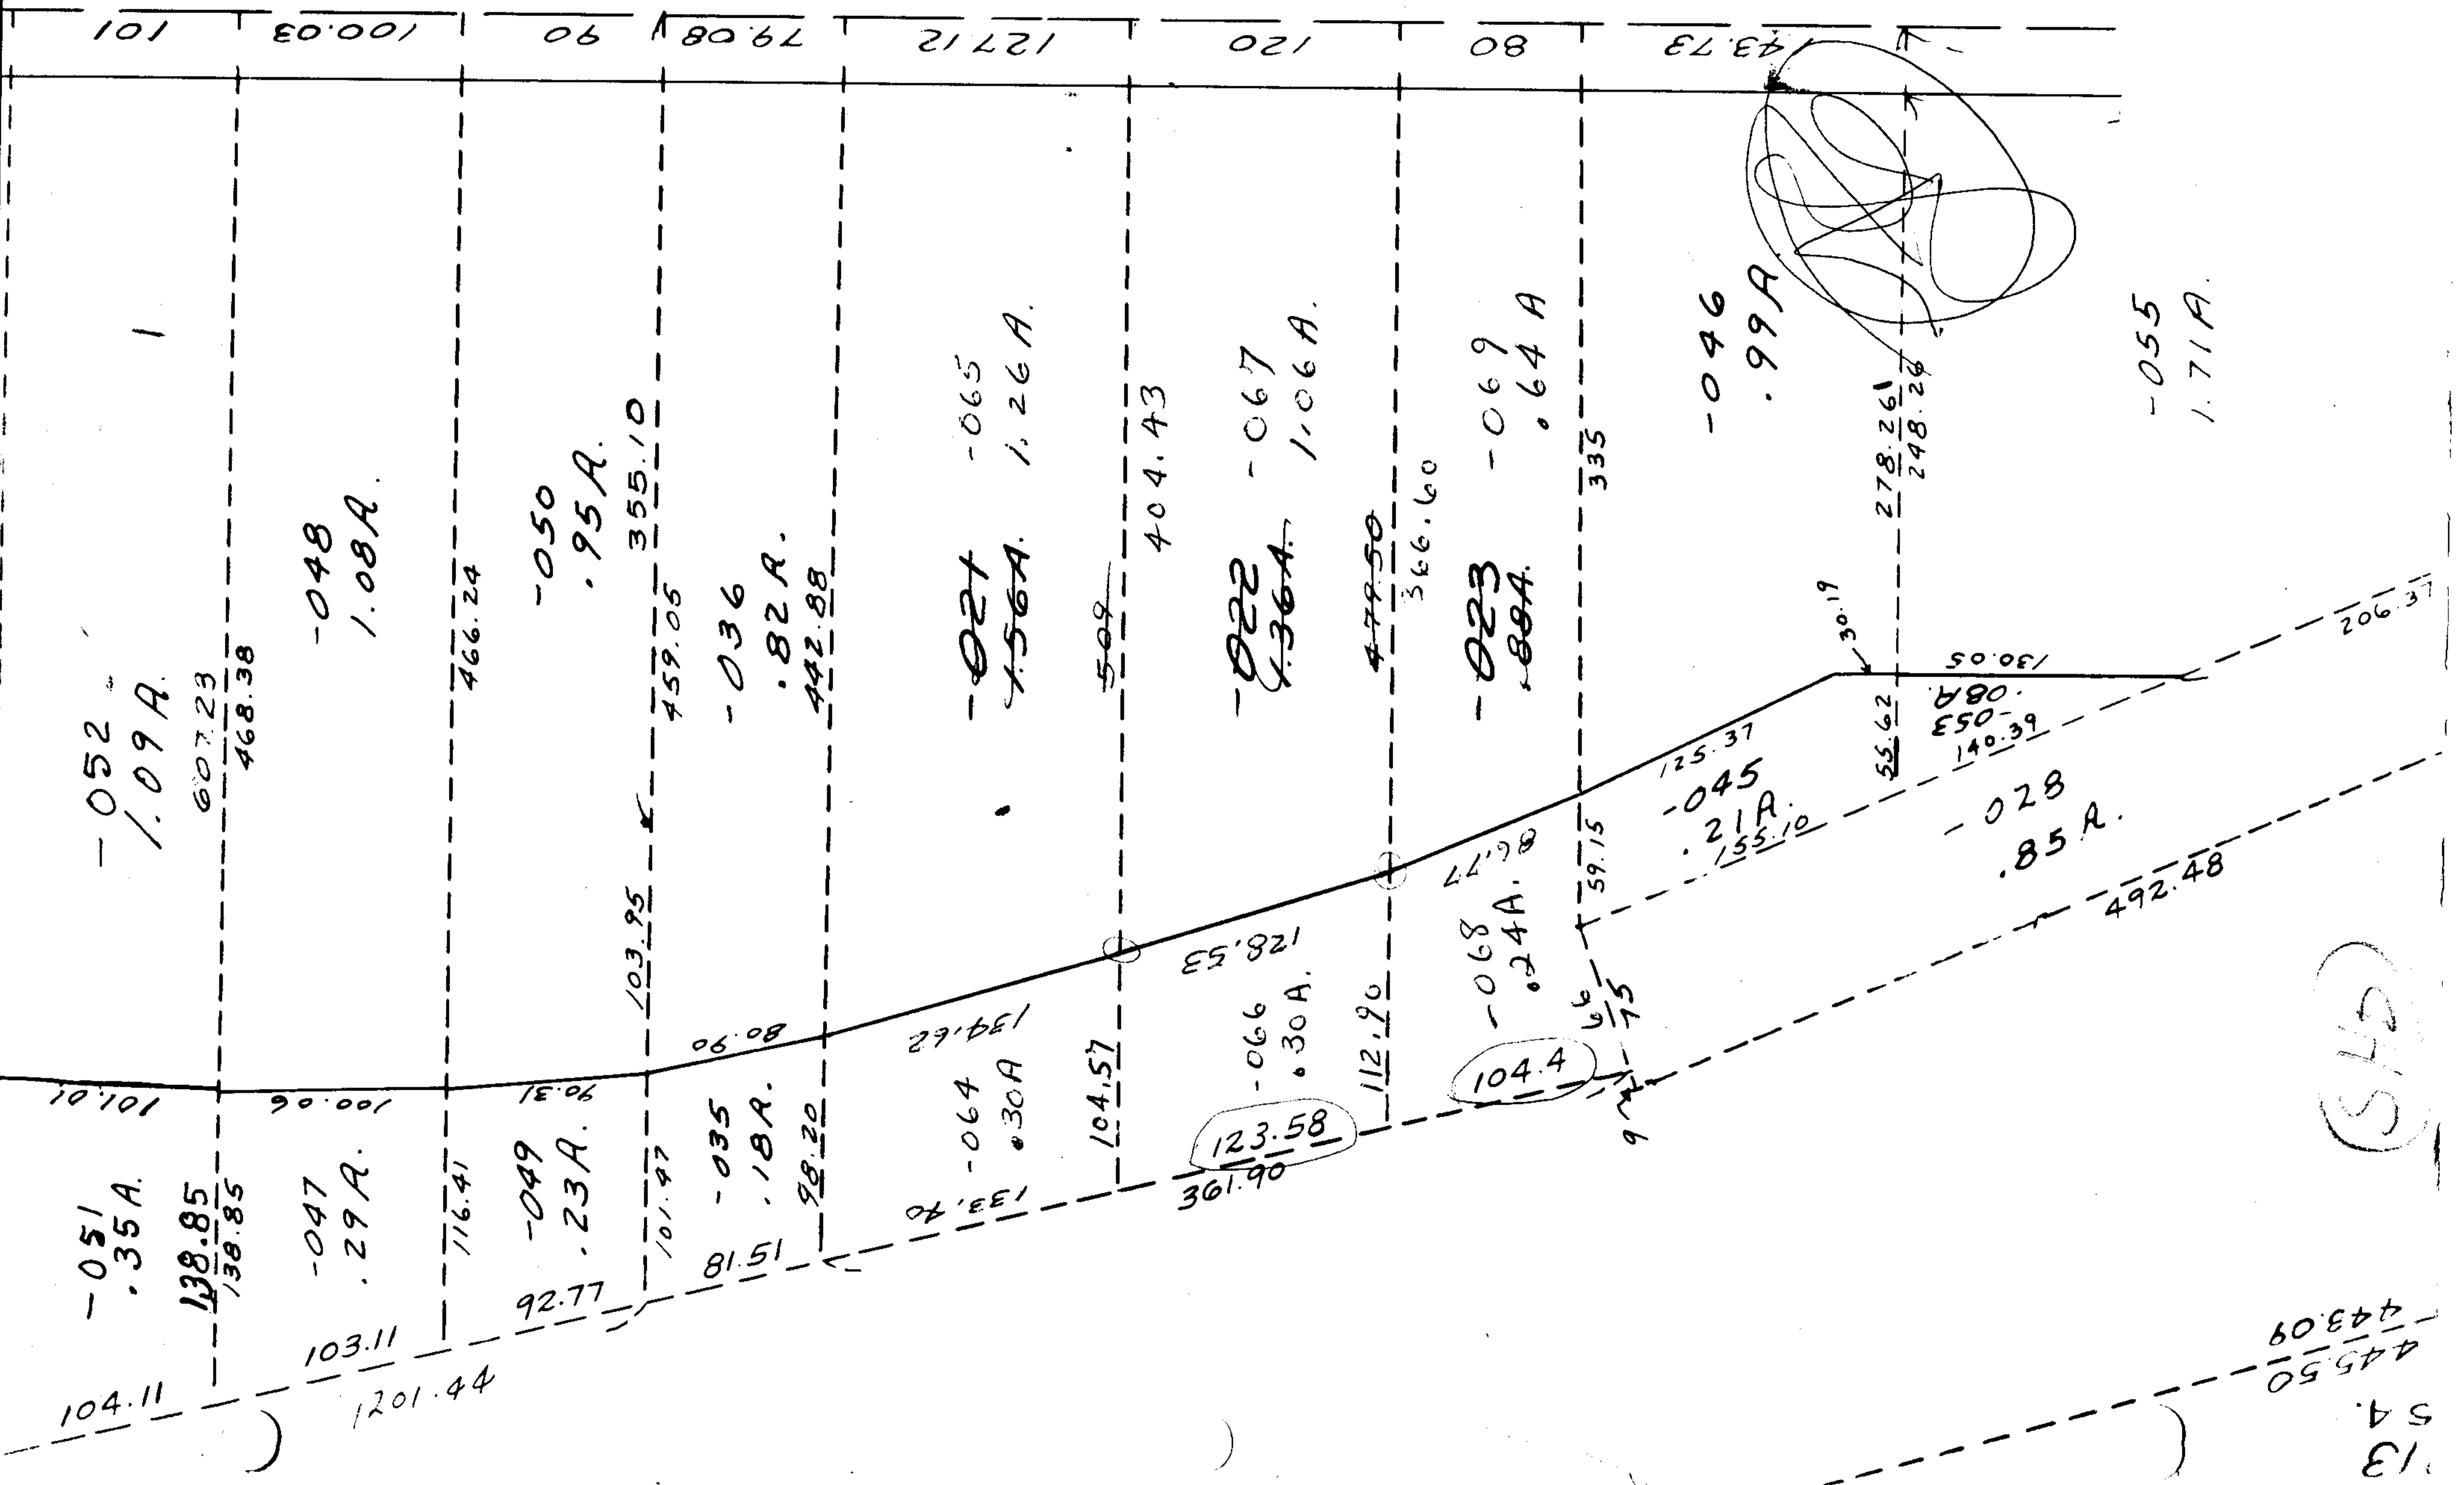

13
54.
445.50
443.09