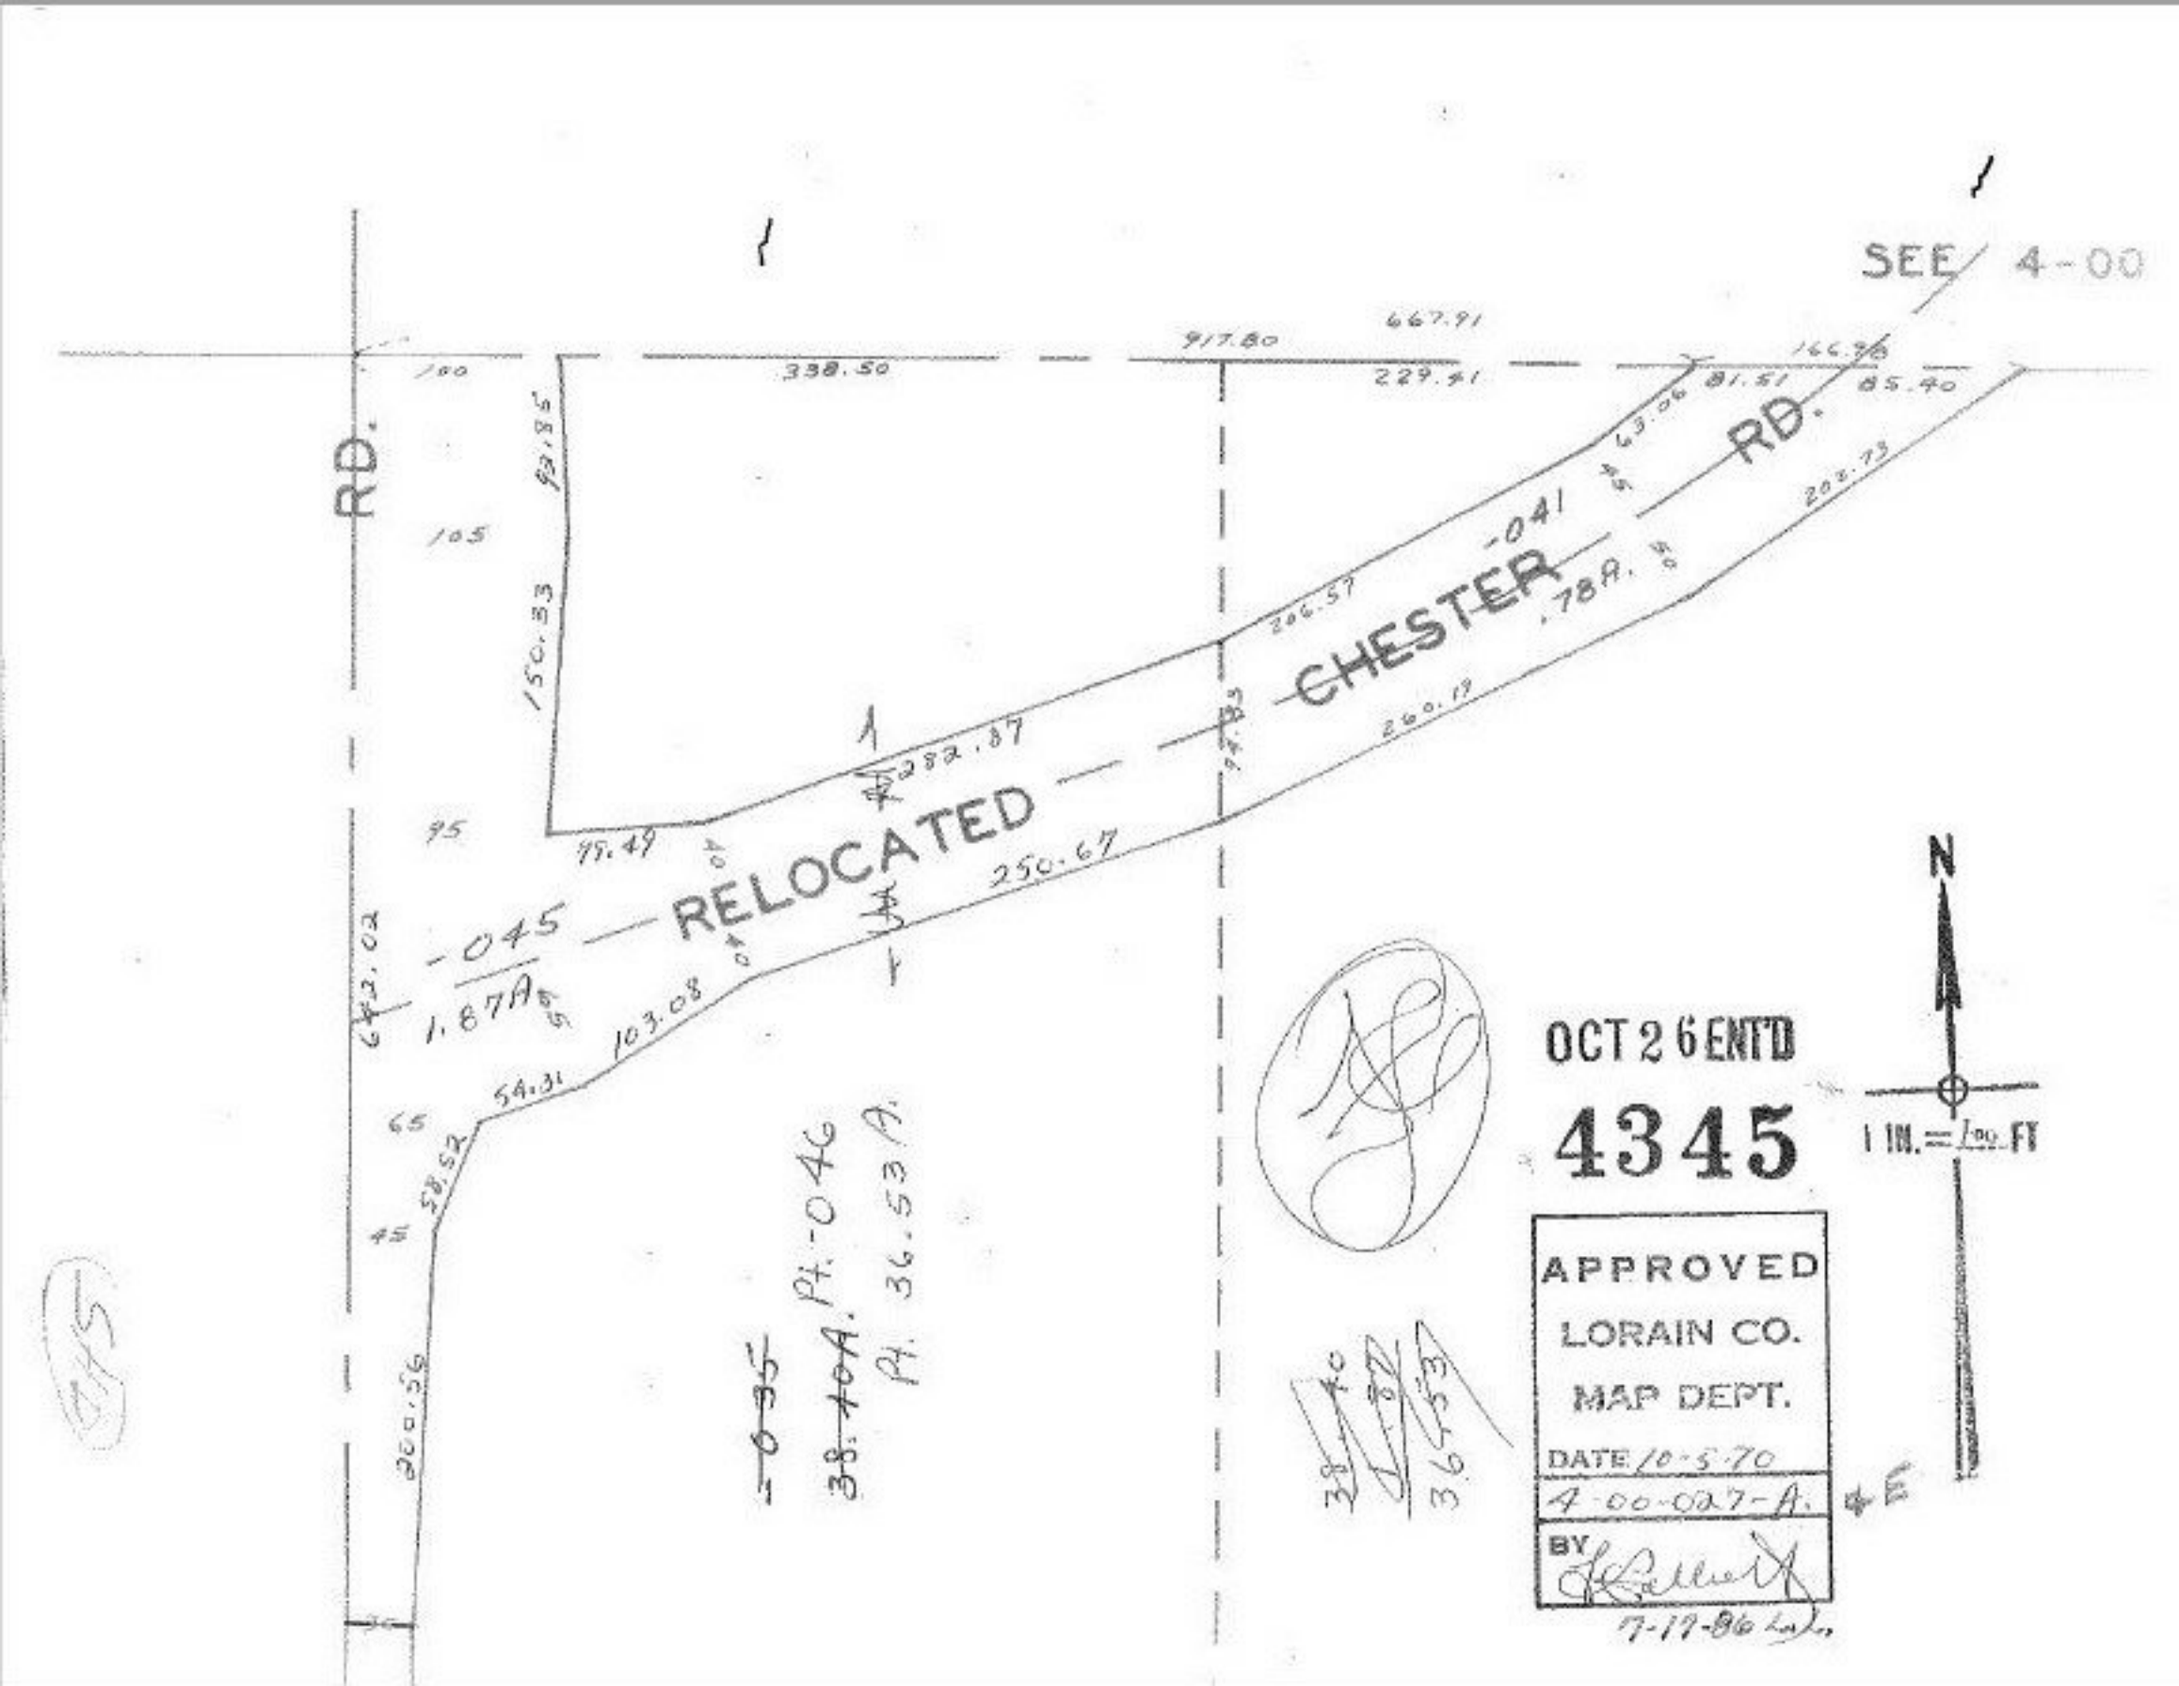
SEE 4-00
RD.
RD.
CHESTER
RELOCATED
-041
.78A.
-045
1.87A
-035
38.40A.
Pt. -046
Pt. 36.53 A.
667.91
917.80
338.50
229.91
166.36
81.51
85.40
63.06
206.57
282.87
250.67
200.19
202.73
150.33
89.85
100
105
95
75.49
642.02
103.08
54.31
58.52
200.36
N
1 IN. = 100 FT
OCT 26 ENT'D
4345
APPROVED
LORAIN CO.
MAP DEPT.
DATE 10-5-70
4-00-027-A.
BY
7-17-86 Lwk.