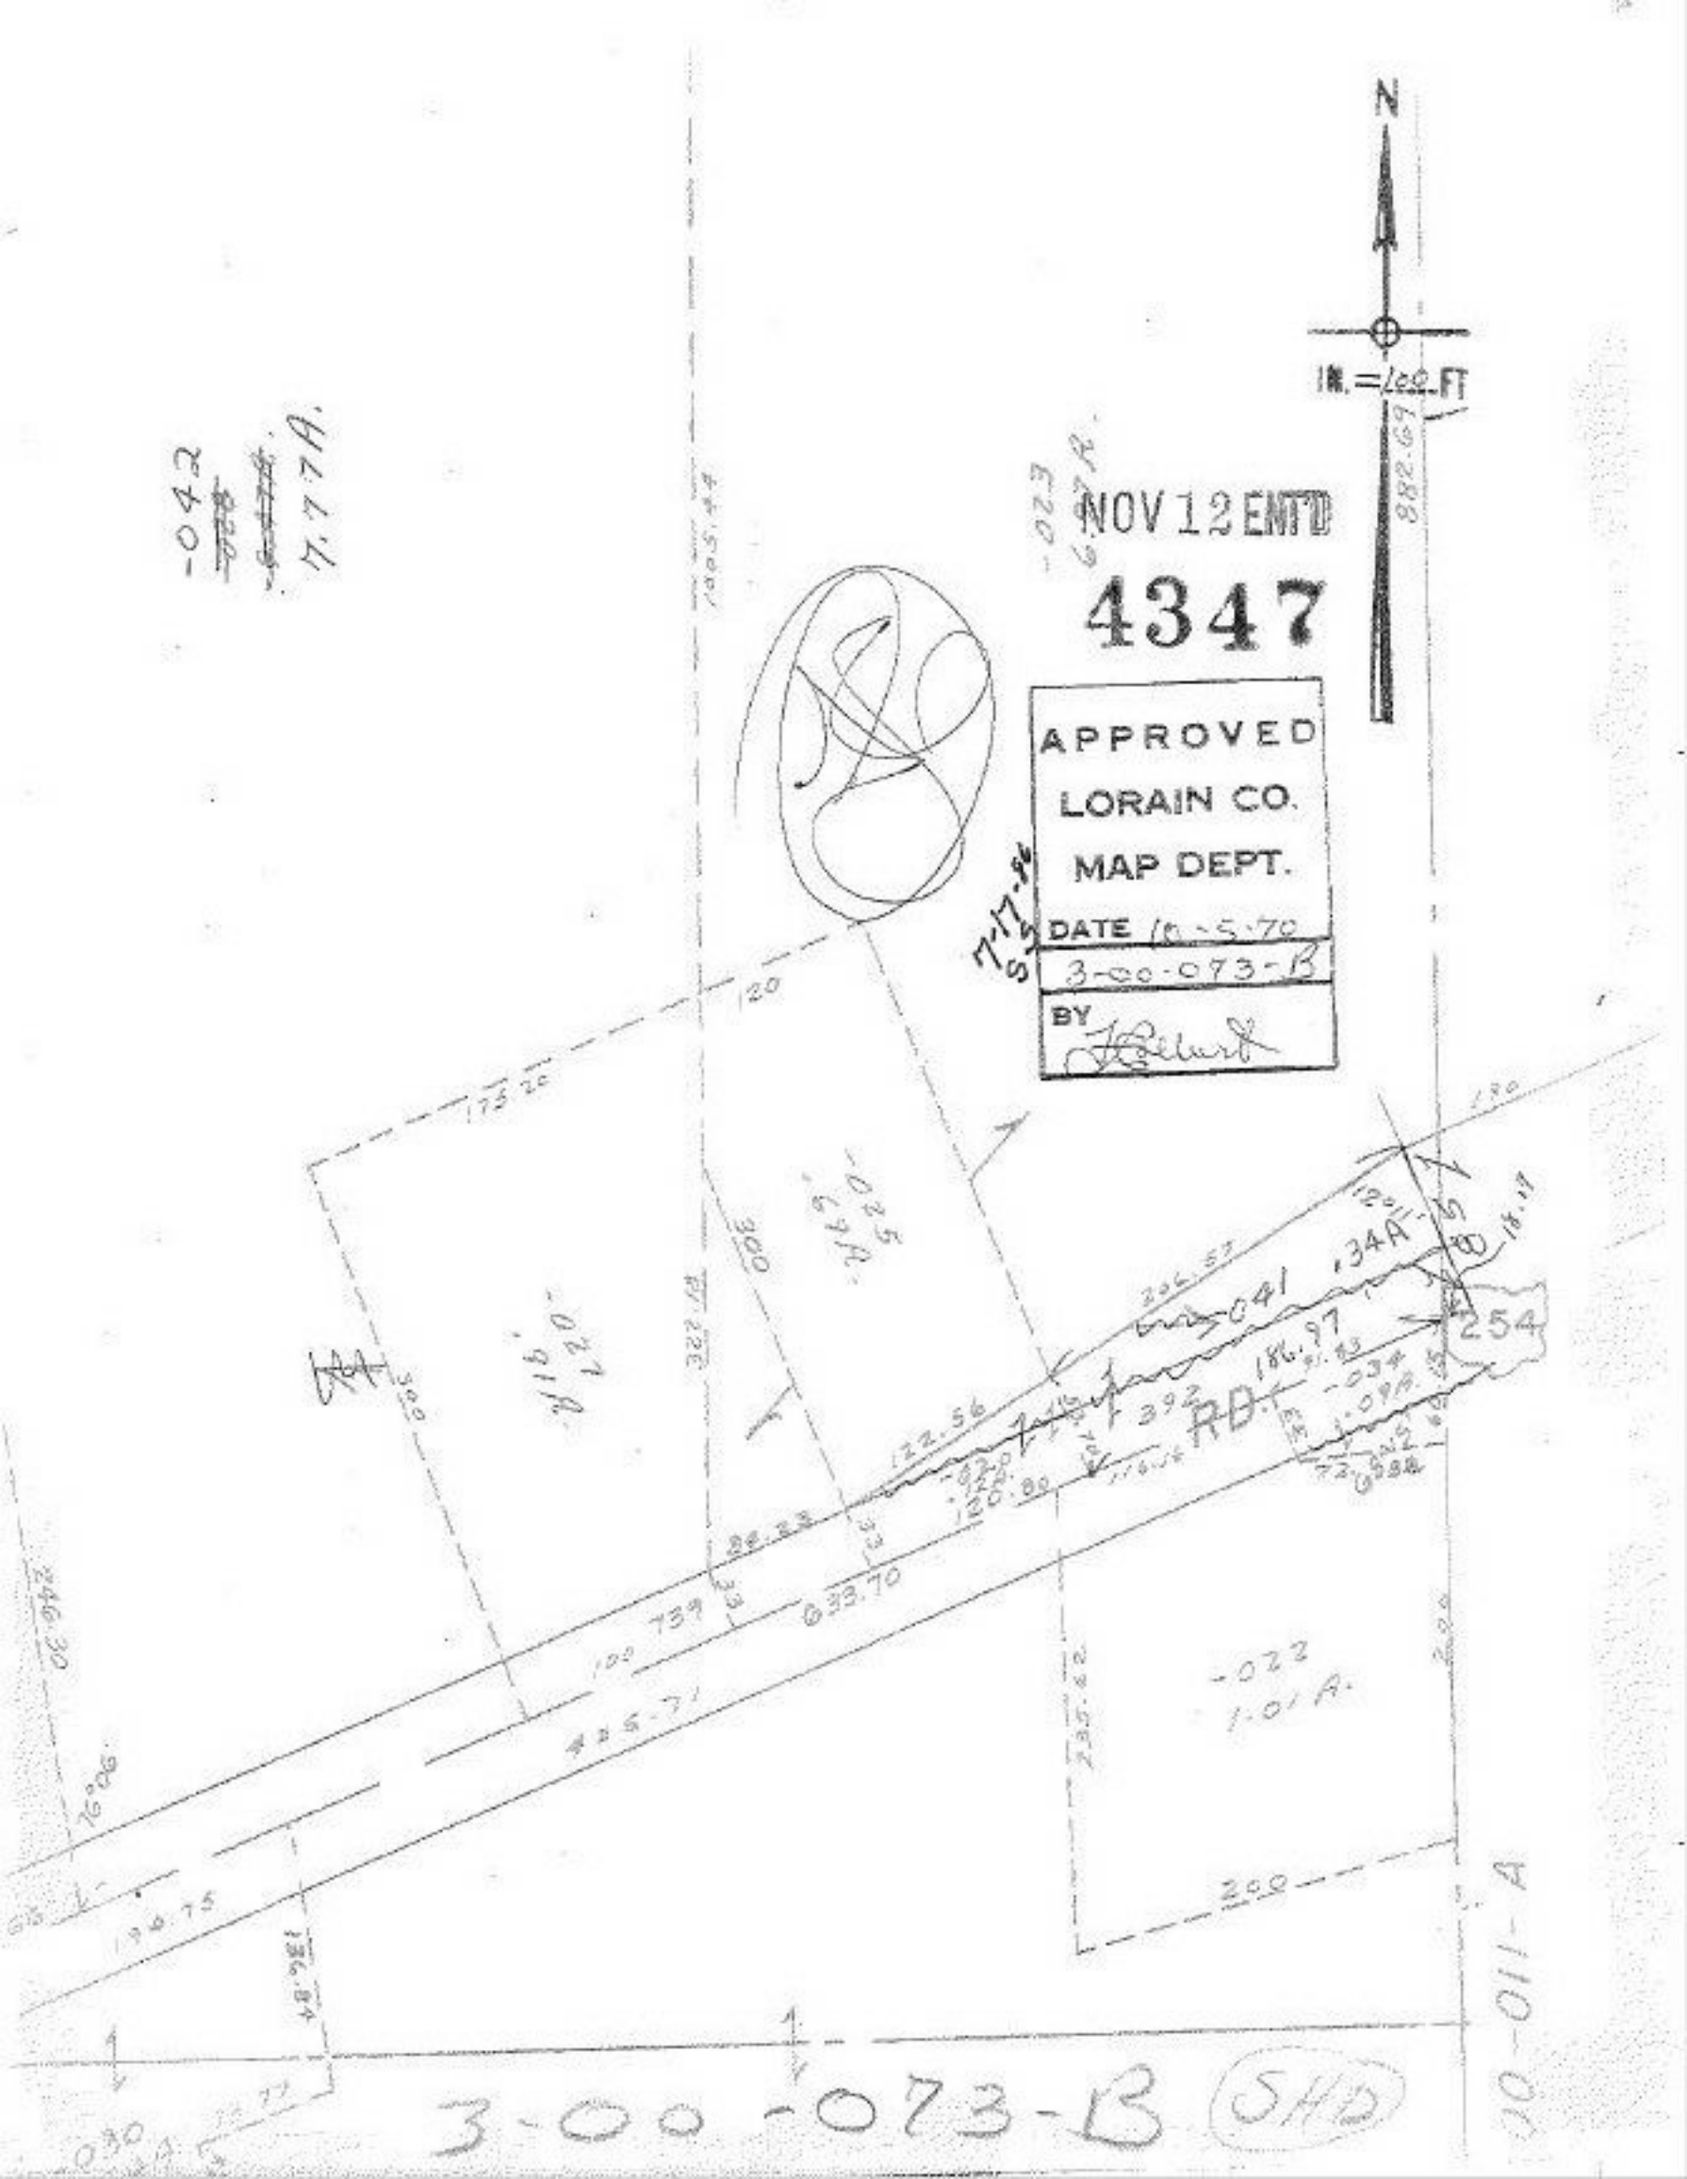
N
IN. = 100 FT
NOV 12 ENT'D
4347
APPROVED
LORAIN CO.
MAP DEPT.
DATE 10-5-70
3-00-073-B
BY
7-17-86
-042
7.77A.
-023
6.97A.
-025
.69A.
-027
.91A.
-041
.34A
254
RD.
-022
1.01 A.
3-00-073-B
SHD
10-011-A