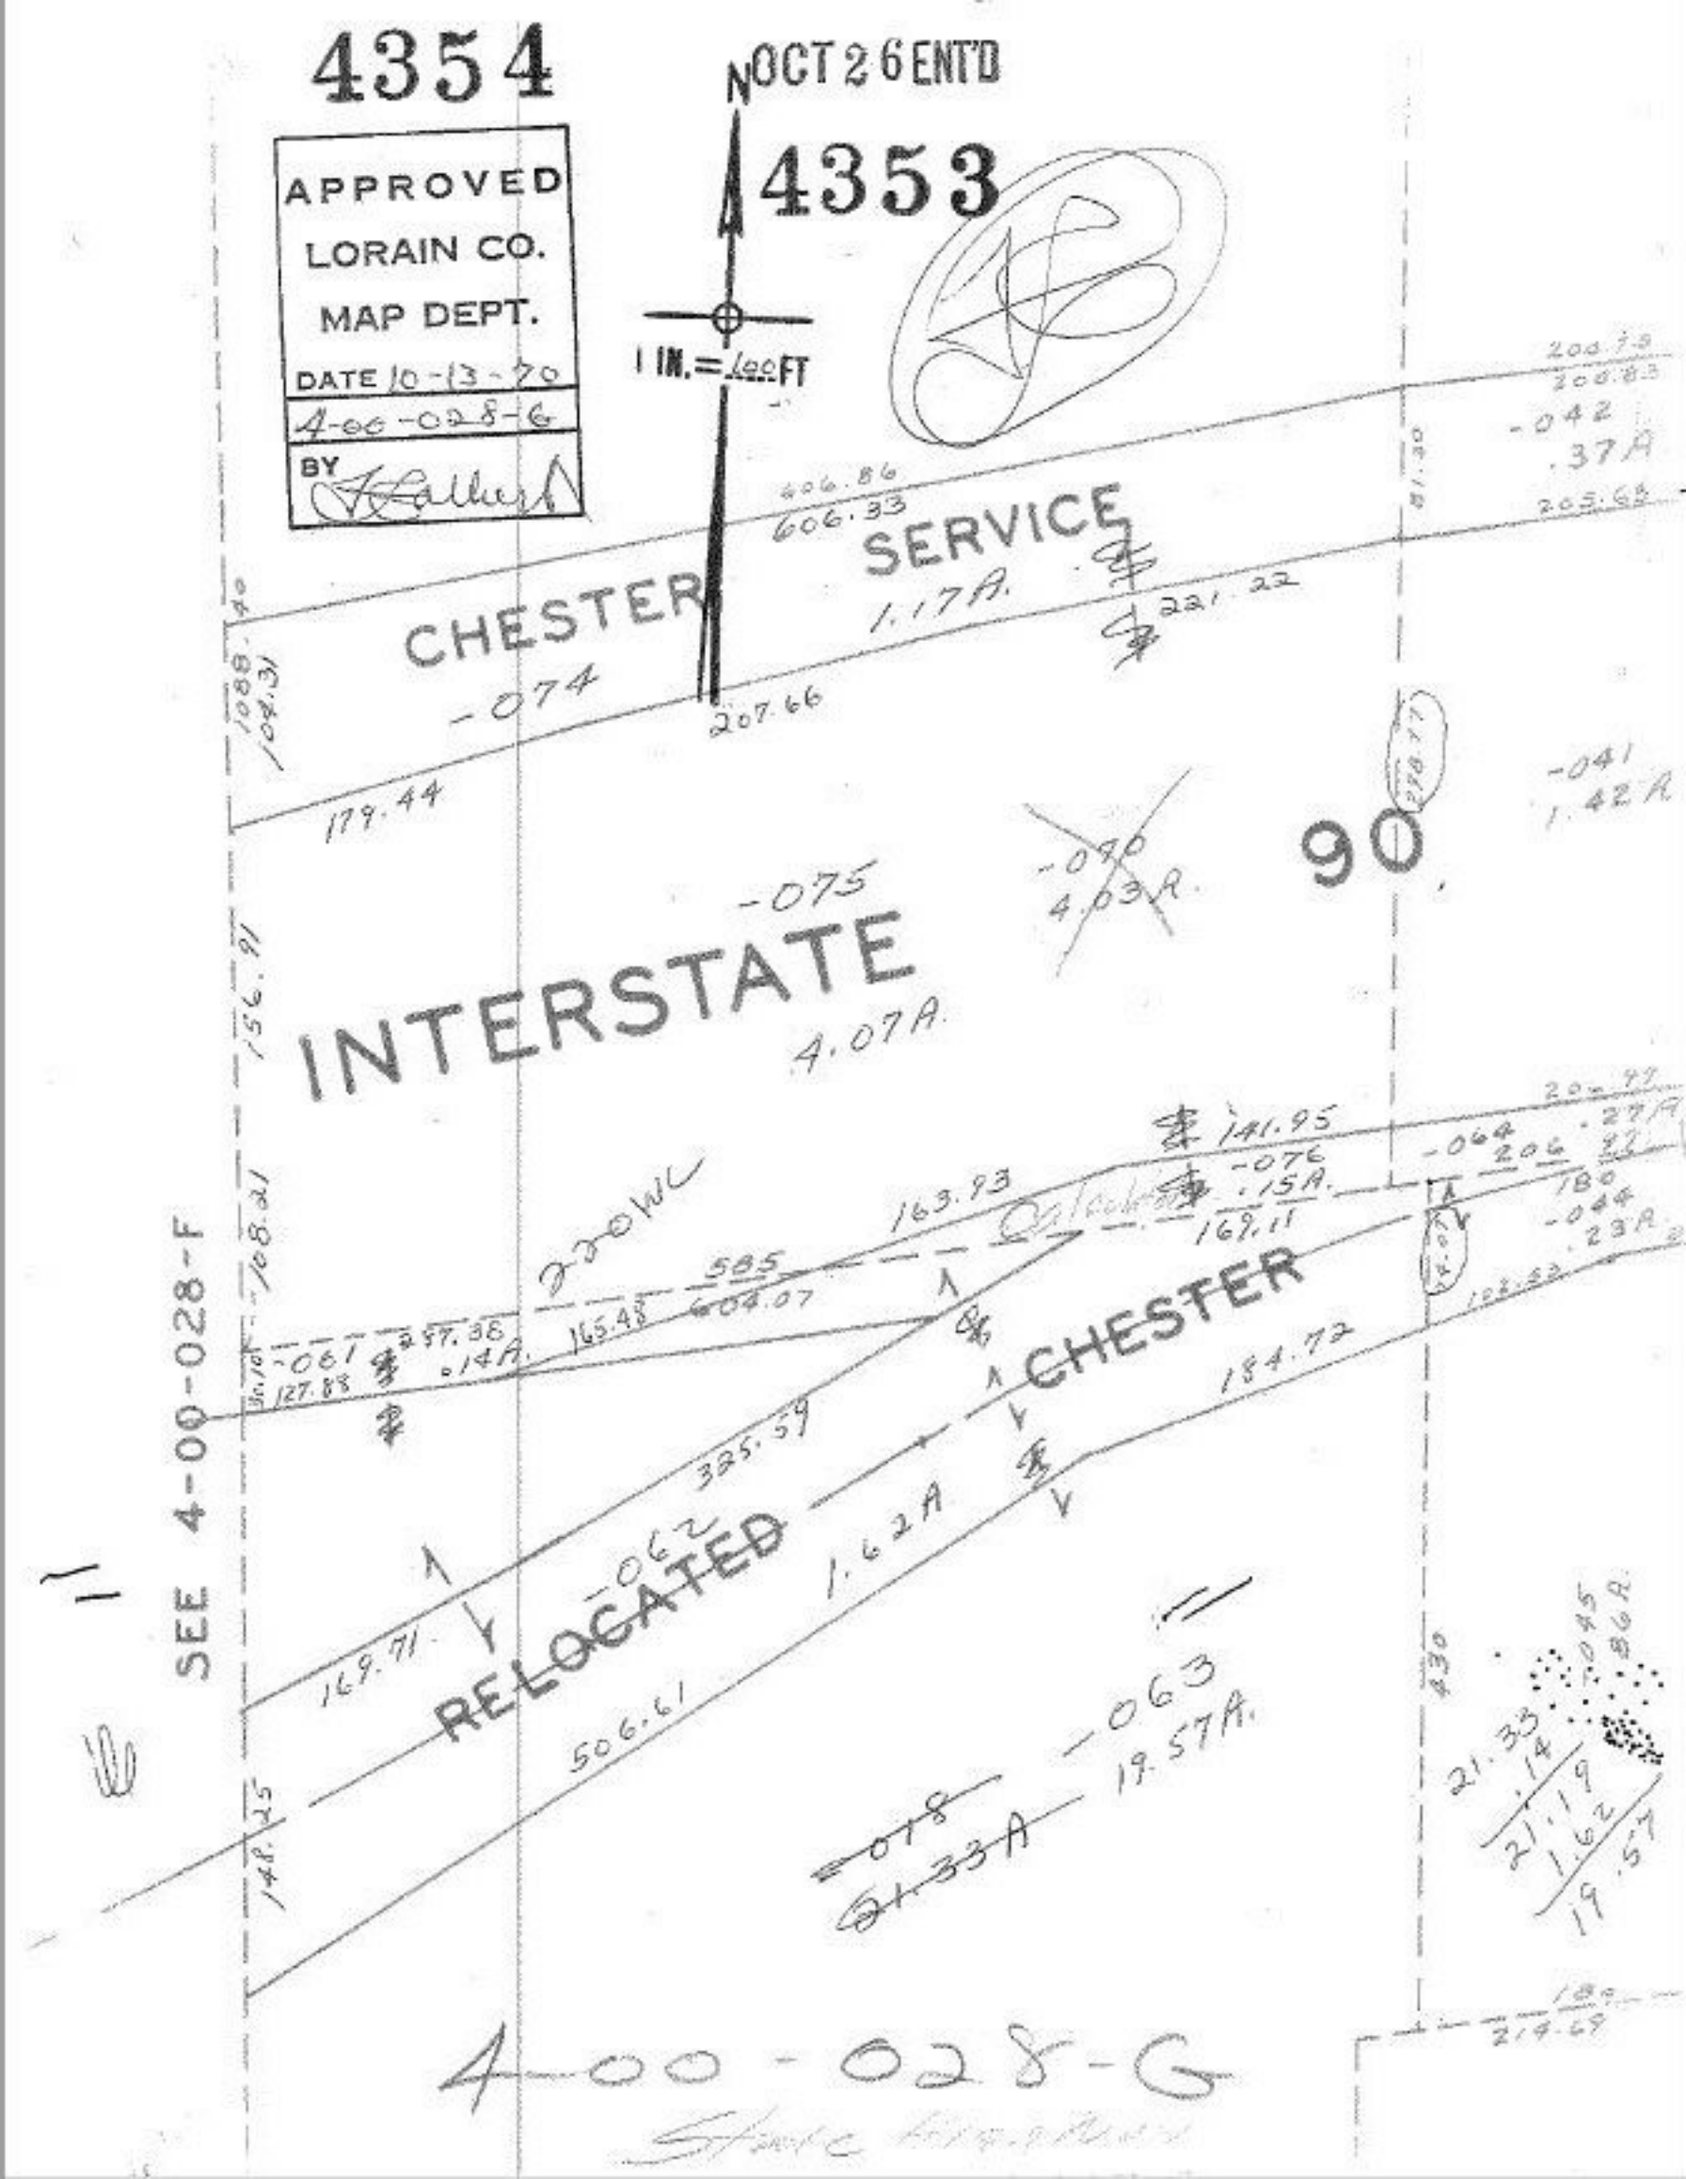
4354
OCT 26 ENT'D
4353
APPROVED
LORAIN CO.
MAP DEPT.
DATE 10-13-70
4-00-028-6
BY
N
1 IN. = 100 FT
CHESTER SERVICE
1.17A.
-074
INTERSTATE
4.07A.
-075
90
-070
4.03A.
-041
1.42A
RELOCATED CHESTER
1.62A
-062
-063
19.57A.
-018
21.33A
SEE 4-00-028-F
4-00-028-G