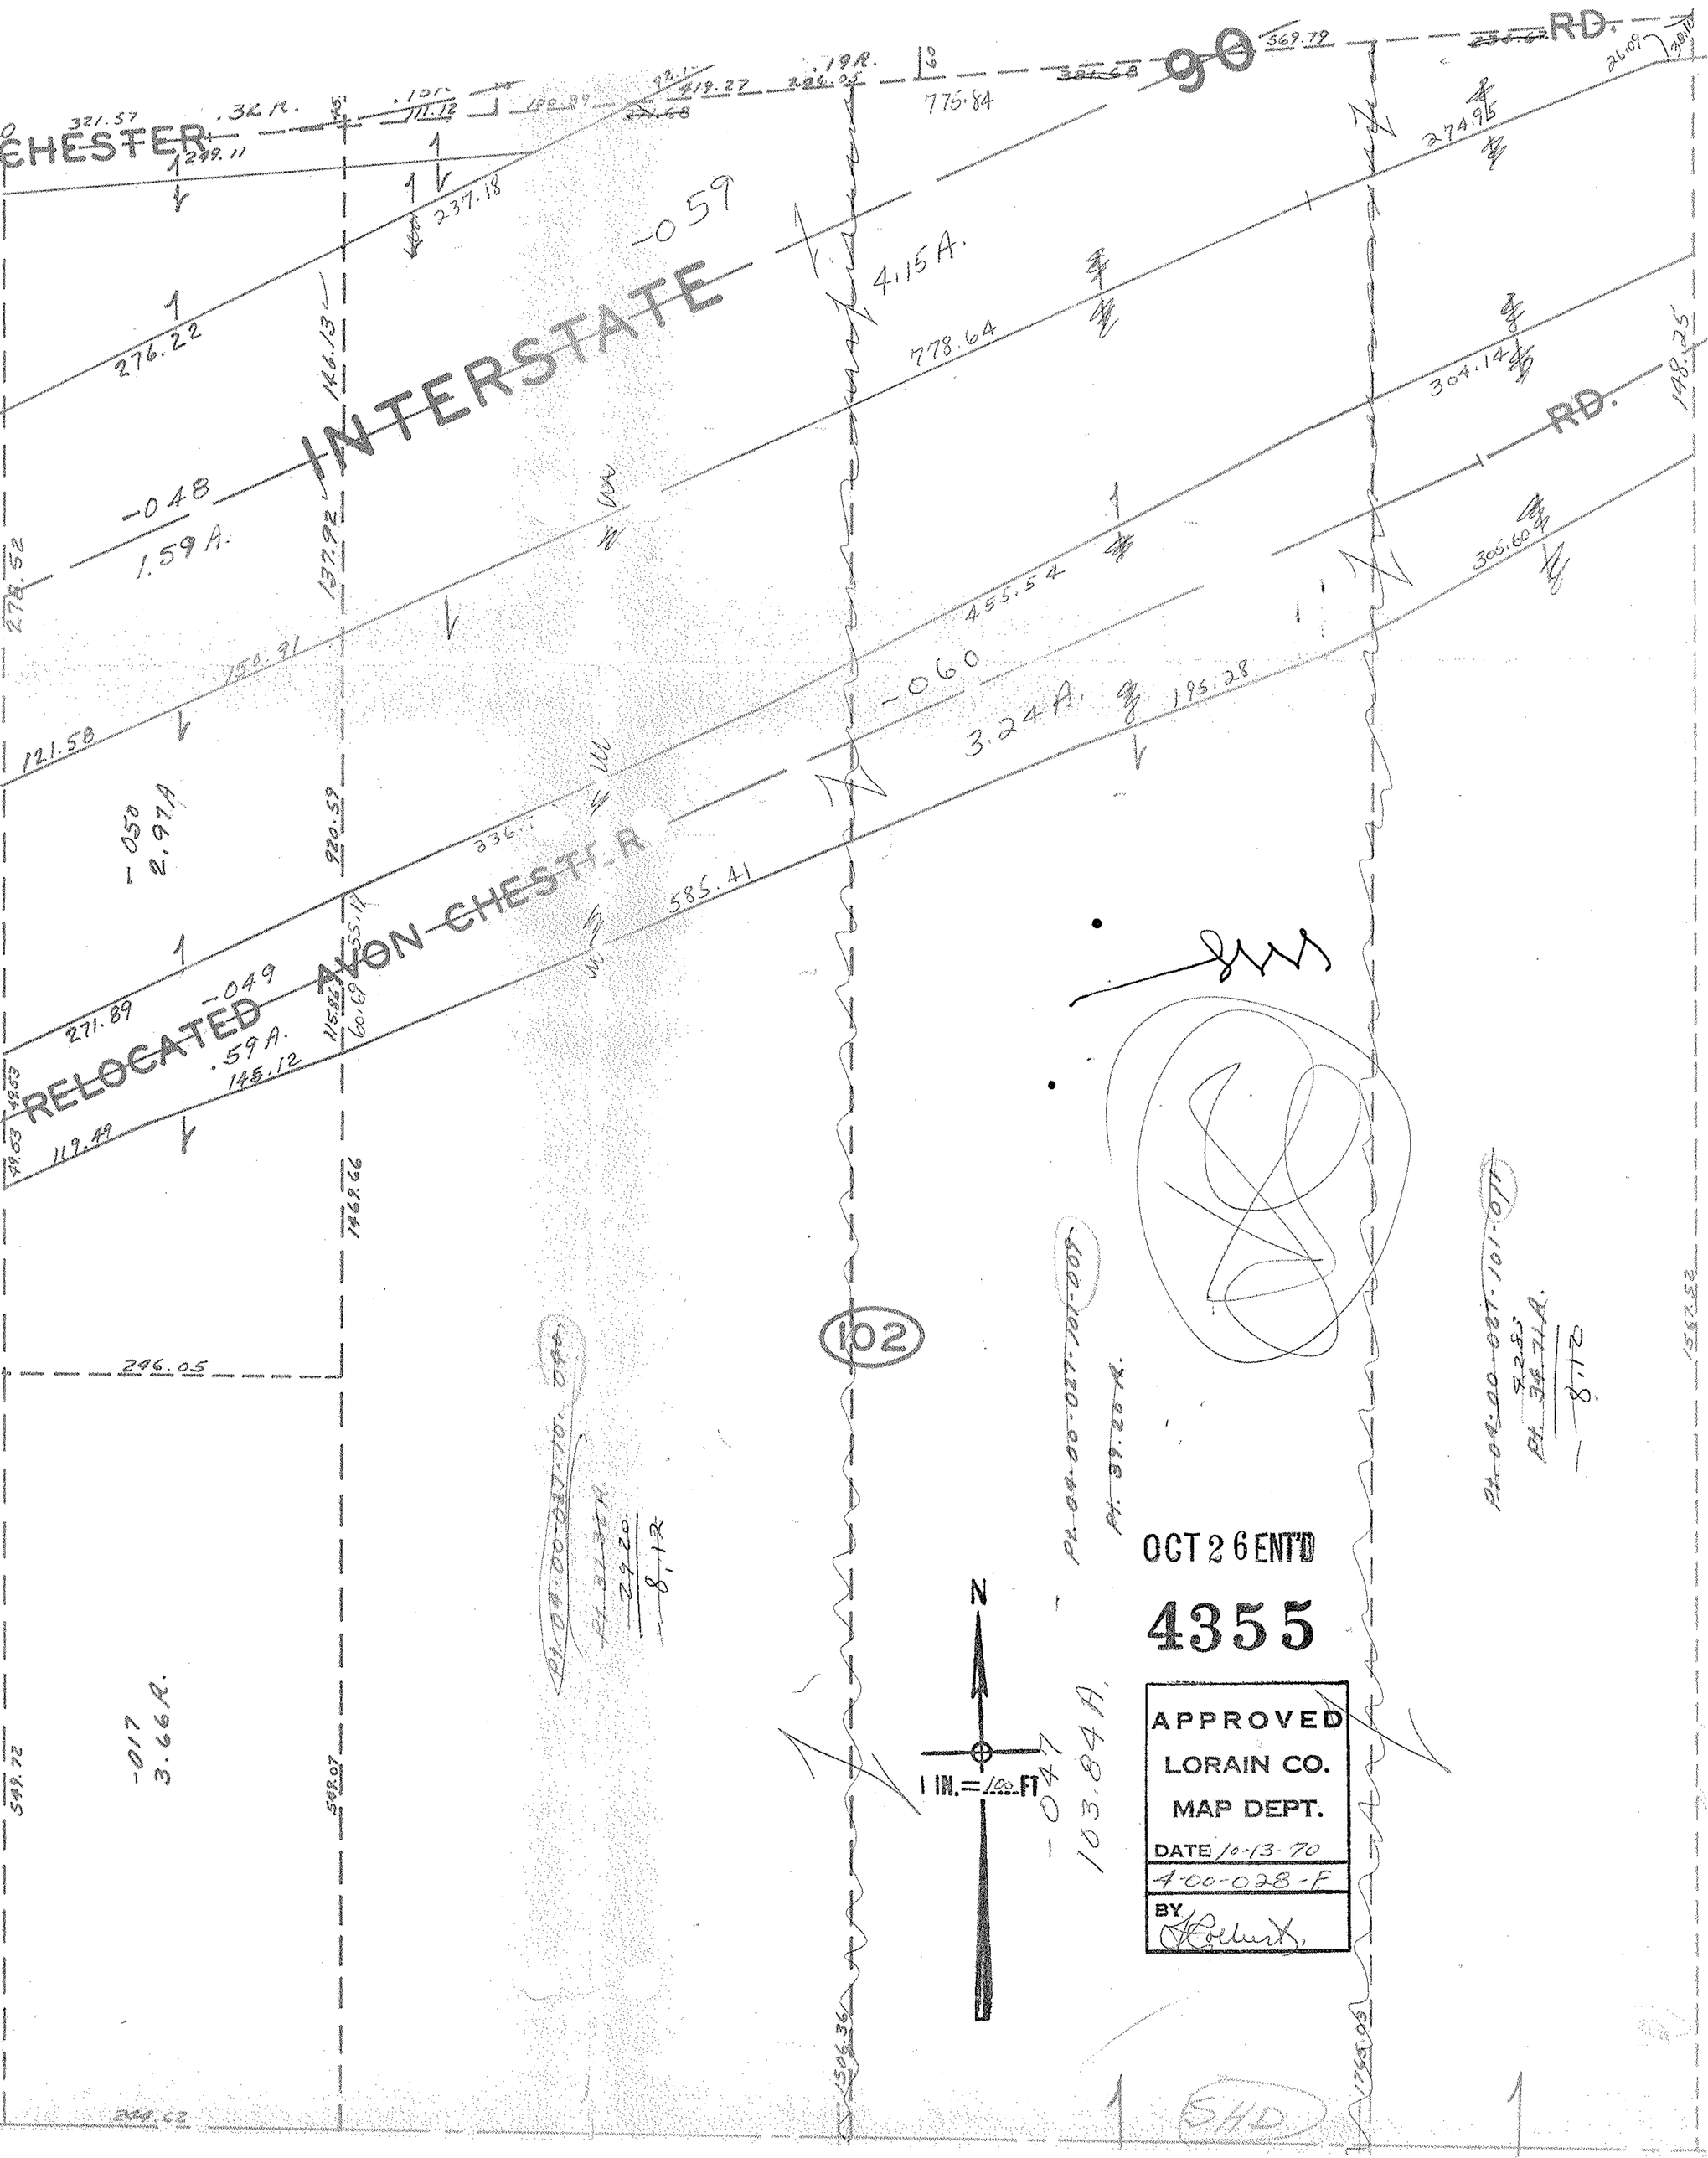

CHESTER
90
RD.
INTERSTATE
RD.
RELOCATED AVON CHESTER
-059
4.15 A.
-048
1.59 A.
-060
3.24 A.
-049
.59 A.
-050
2.97 A
-017
3.66 A.
-047
103.84 A.
102
N
1 IN. = 100 FT
OCT 26 ENT'D
4355
APPROVED
LORAIN CO.
MAP DEPT.
DATE 10-13-70
4-00-028-F
BY