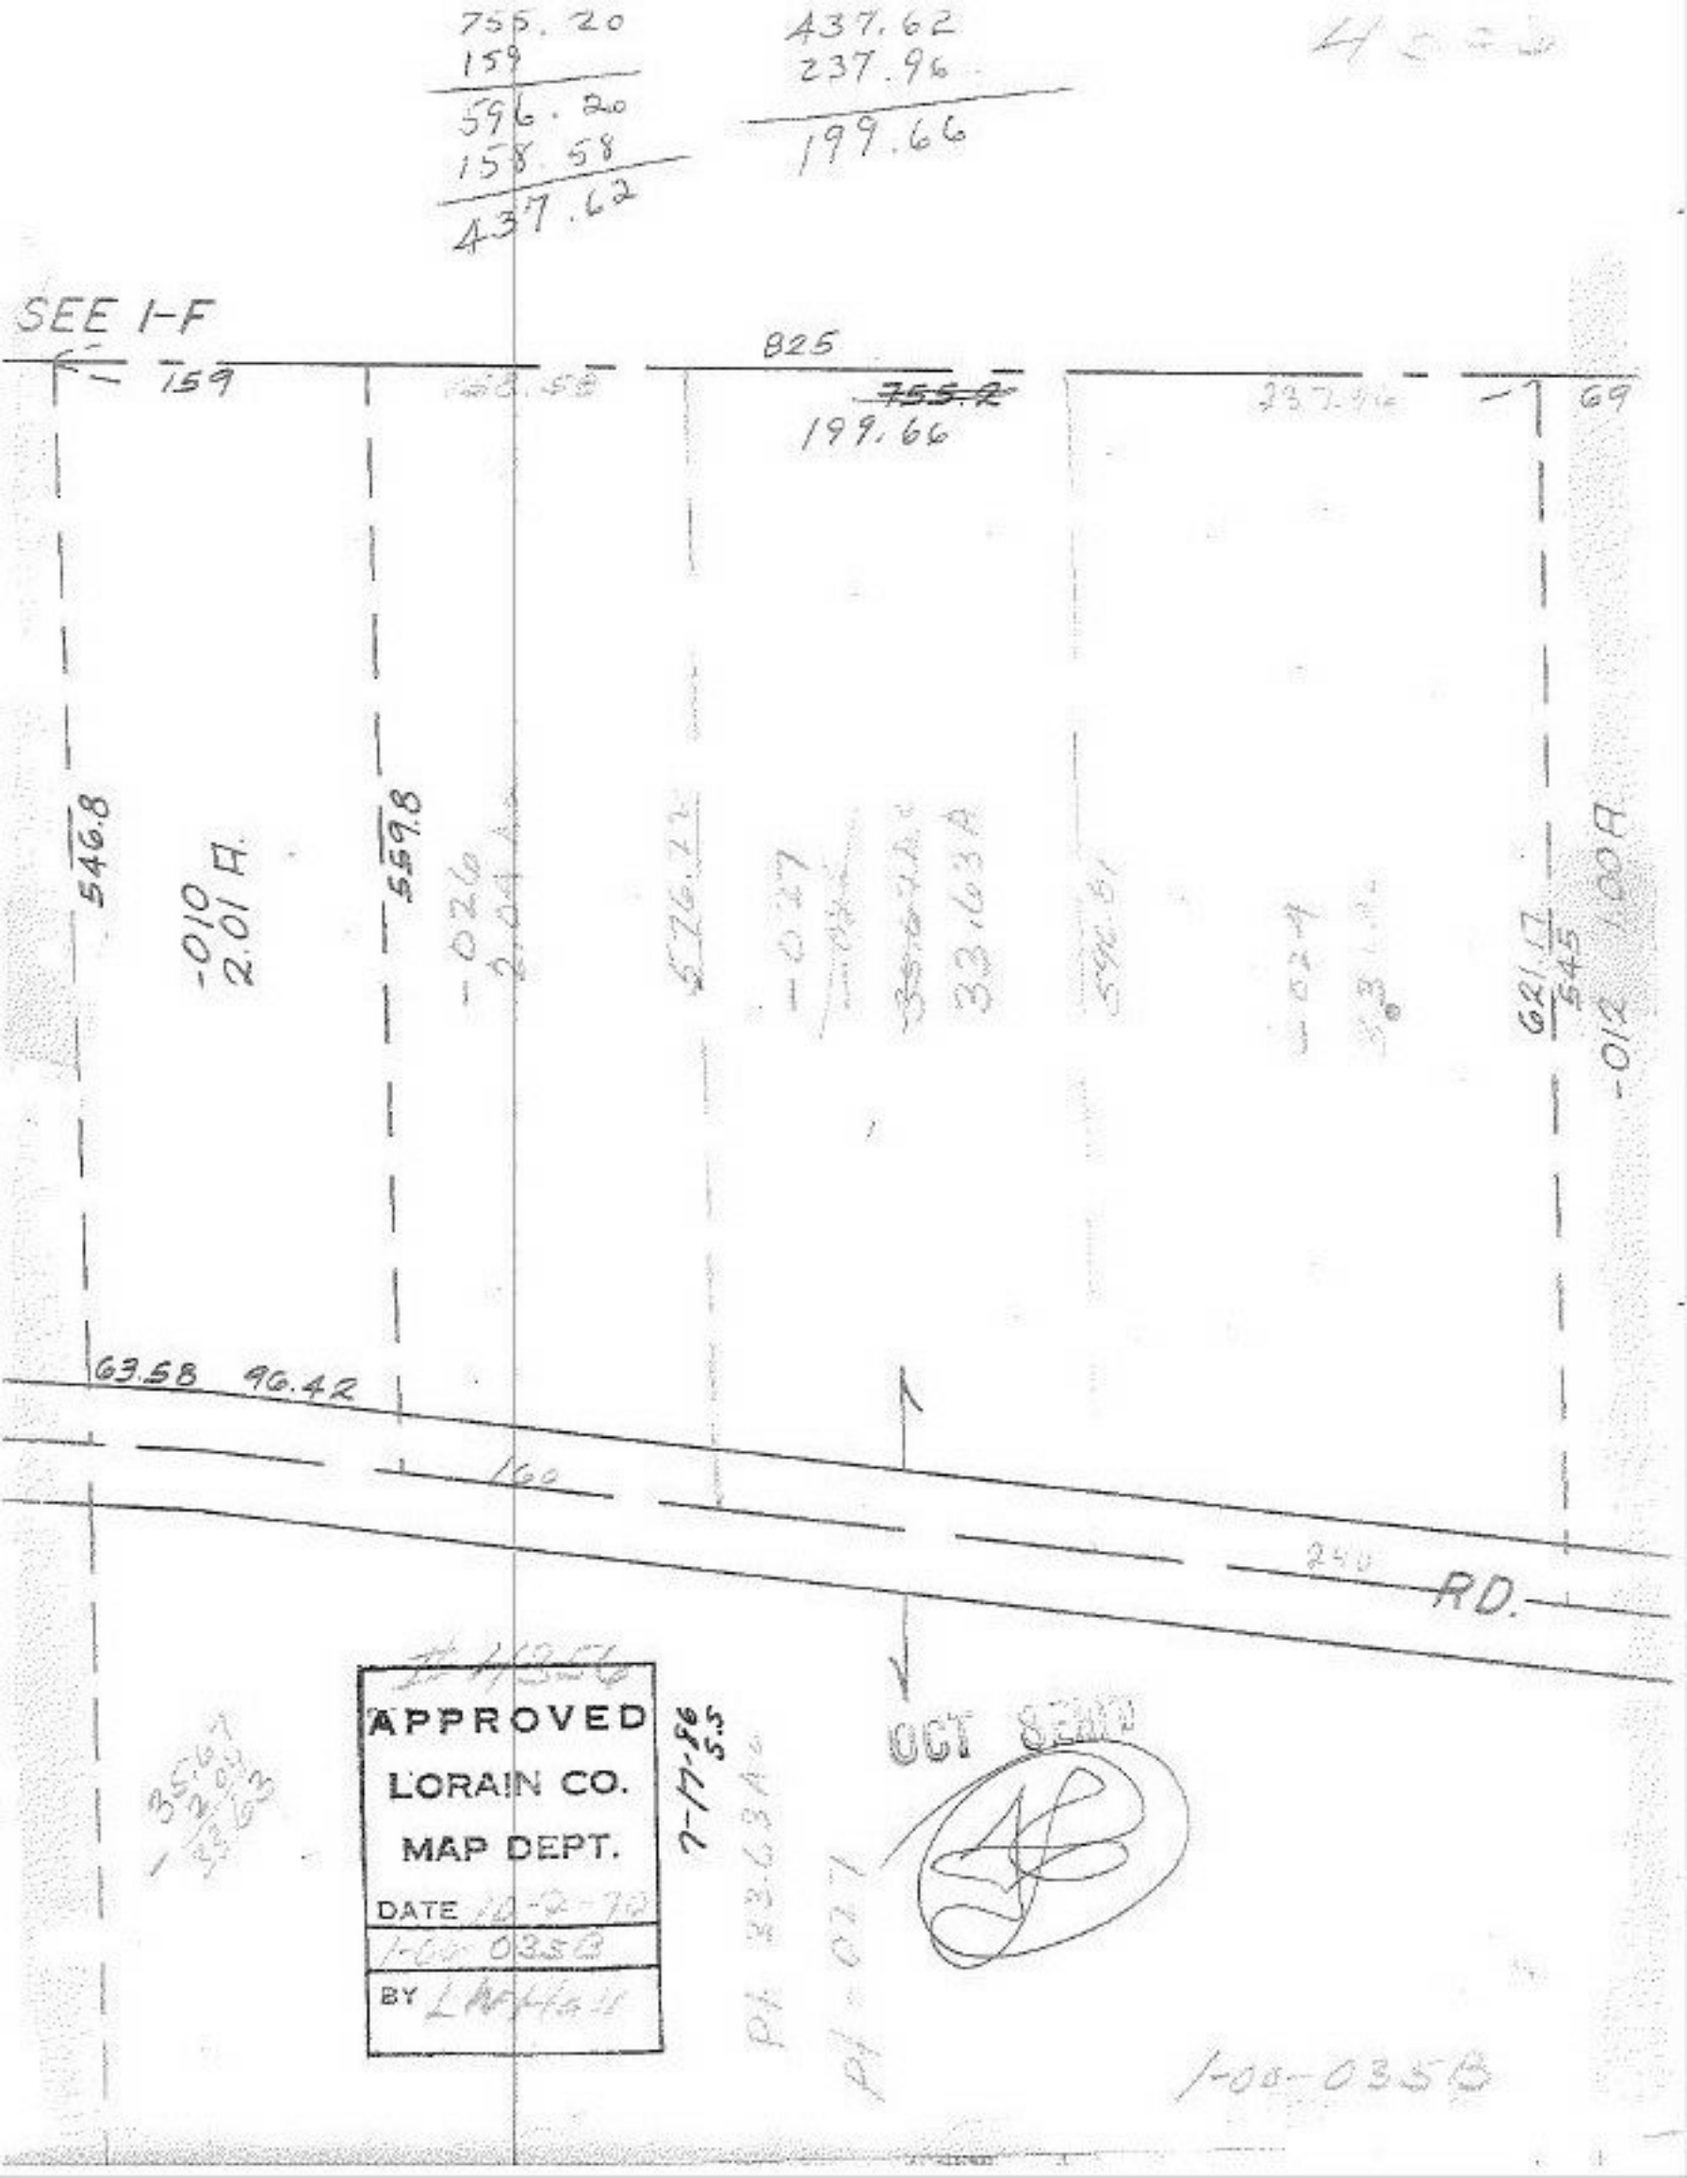

755.20
159
596.20
158.58
437.62
437.62
237.96
199.66
SEE 1-F
825
159
199.66
69
546.8
-010
2.01 A
559.8
-026
-027
33.63 A
621.17
545
-012
1.00 A
63.58
96.42
160
240
RD.
APPROVED
LORAIN CO.
MAP DEPT.
DATE 10-2-70
1-00-035B
BY
7-17-86
5.5
OCT SEND
1-00-035B