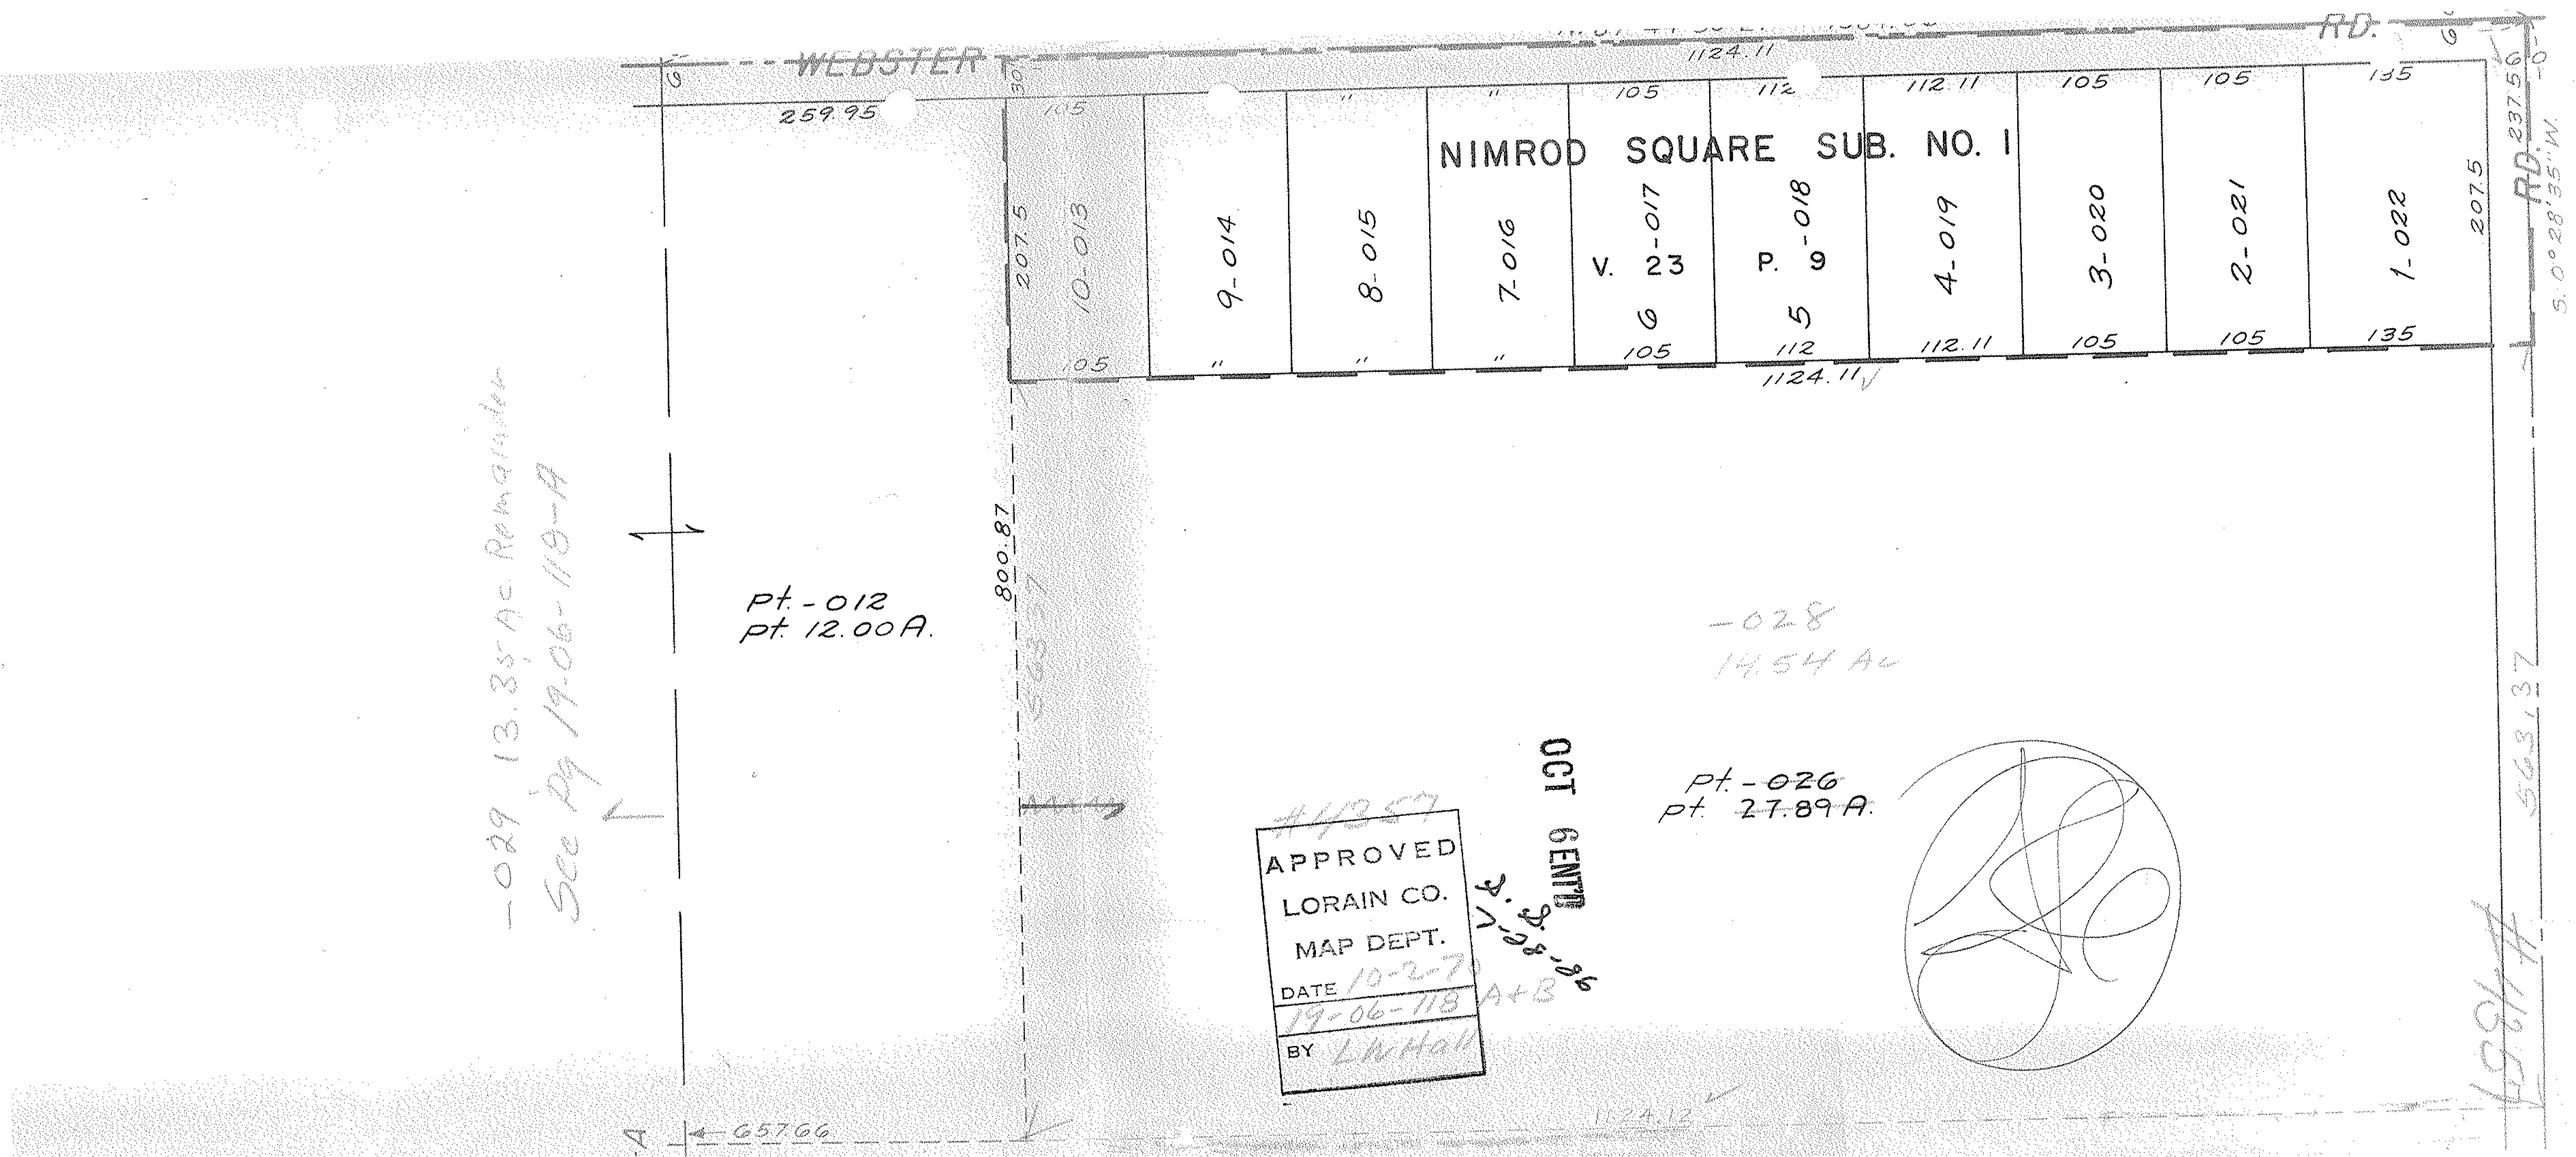
WEBSTER
RD.
259.95
1124.11
NIMROD SQUARE SUB. NO. 1
V. 23
P. 9
10-013
9-014
8-015
7-016
6-017
5-018
4-019
3-020
2-021
1-022
207.5
105
112
112.11
135
237.56
S. 0° 28' 35" W.
800.87
563.37
Pt.-012
pt. 12.00A.
-029 13.35 Ac Remainder
See Pg 19-06-118-A
-028
14.54 Ac
Pt.-026
pt. 27.89 A.
OCT 6 ENT'D
#4357
APPROVED
LORAIN CO.
MAP DEPT.
DATE 10-2-70
19-06-118 A+B
BY L.W. Hall
1124.12
657.66
563.37