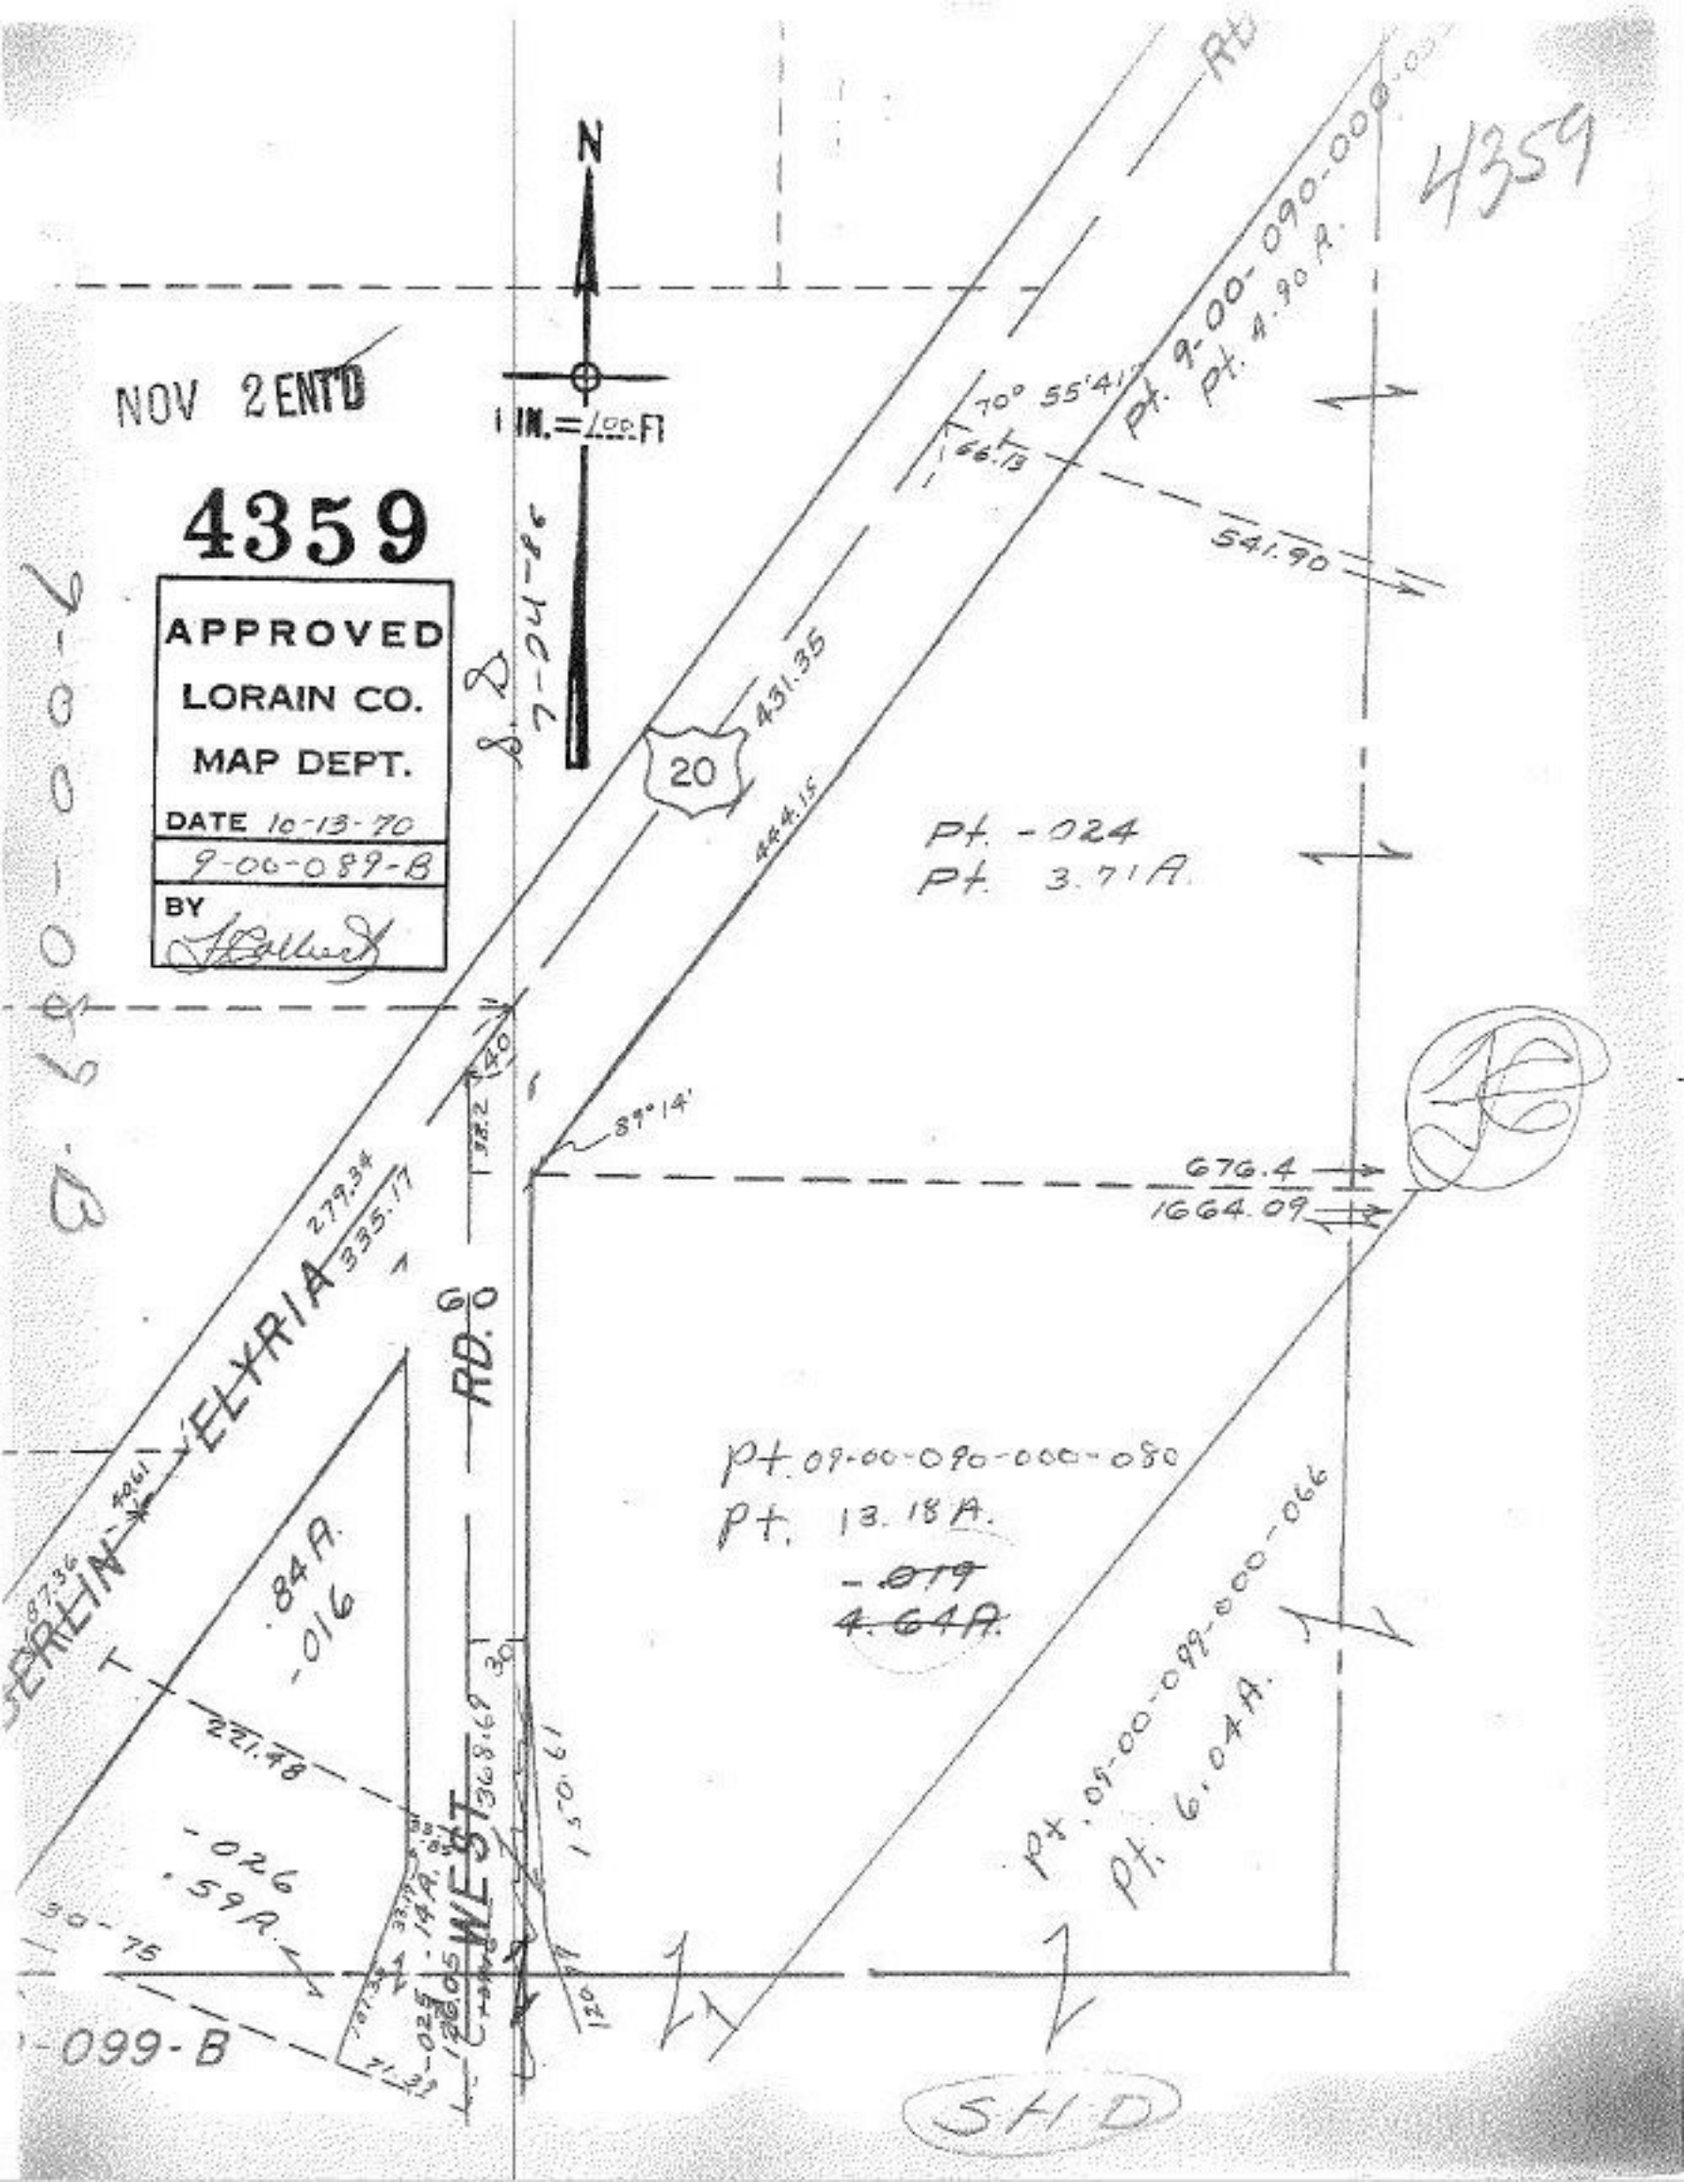

NOV 2 ENT'D
4359
APPROVED
LORAIN CO.
MAP DEPT.
DATE 10-13-70
9-00-089-B
BY
N
1 IN. = 100 FT
4359
Pt. 9-00-090-000-000
Pt. 4.90 A.
70° 55'41"
66.13
541.90
431.35
20
444.15
Pt. -024
Pt. 3.71 A.
89°14'
676.4
1664.09
279.34
335.17
ELYRIA
RD. 60
Pt. 09-00-090-000-080
Pt. 13.18 A.
-.019
4.64 A.
.84 A.
-.016
221.48
368.69
150.61
-.026
.59 A.
WEST
Pt. 09-00-099-000-066
Pt. 6.04 A.
-099-B
SHD