4359.

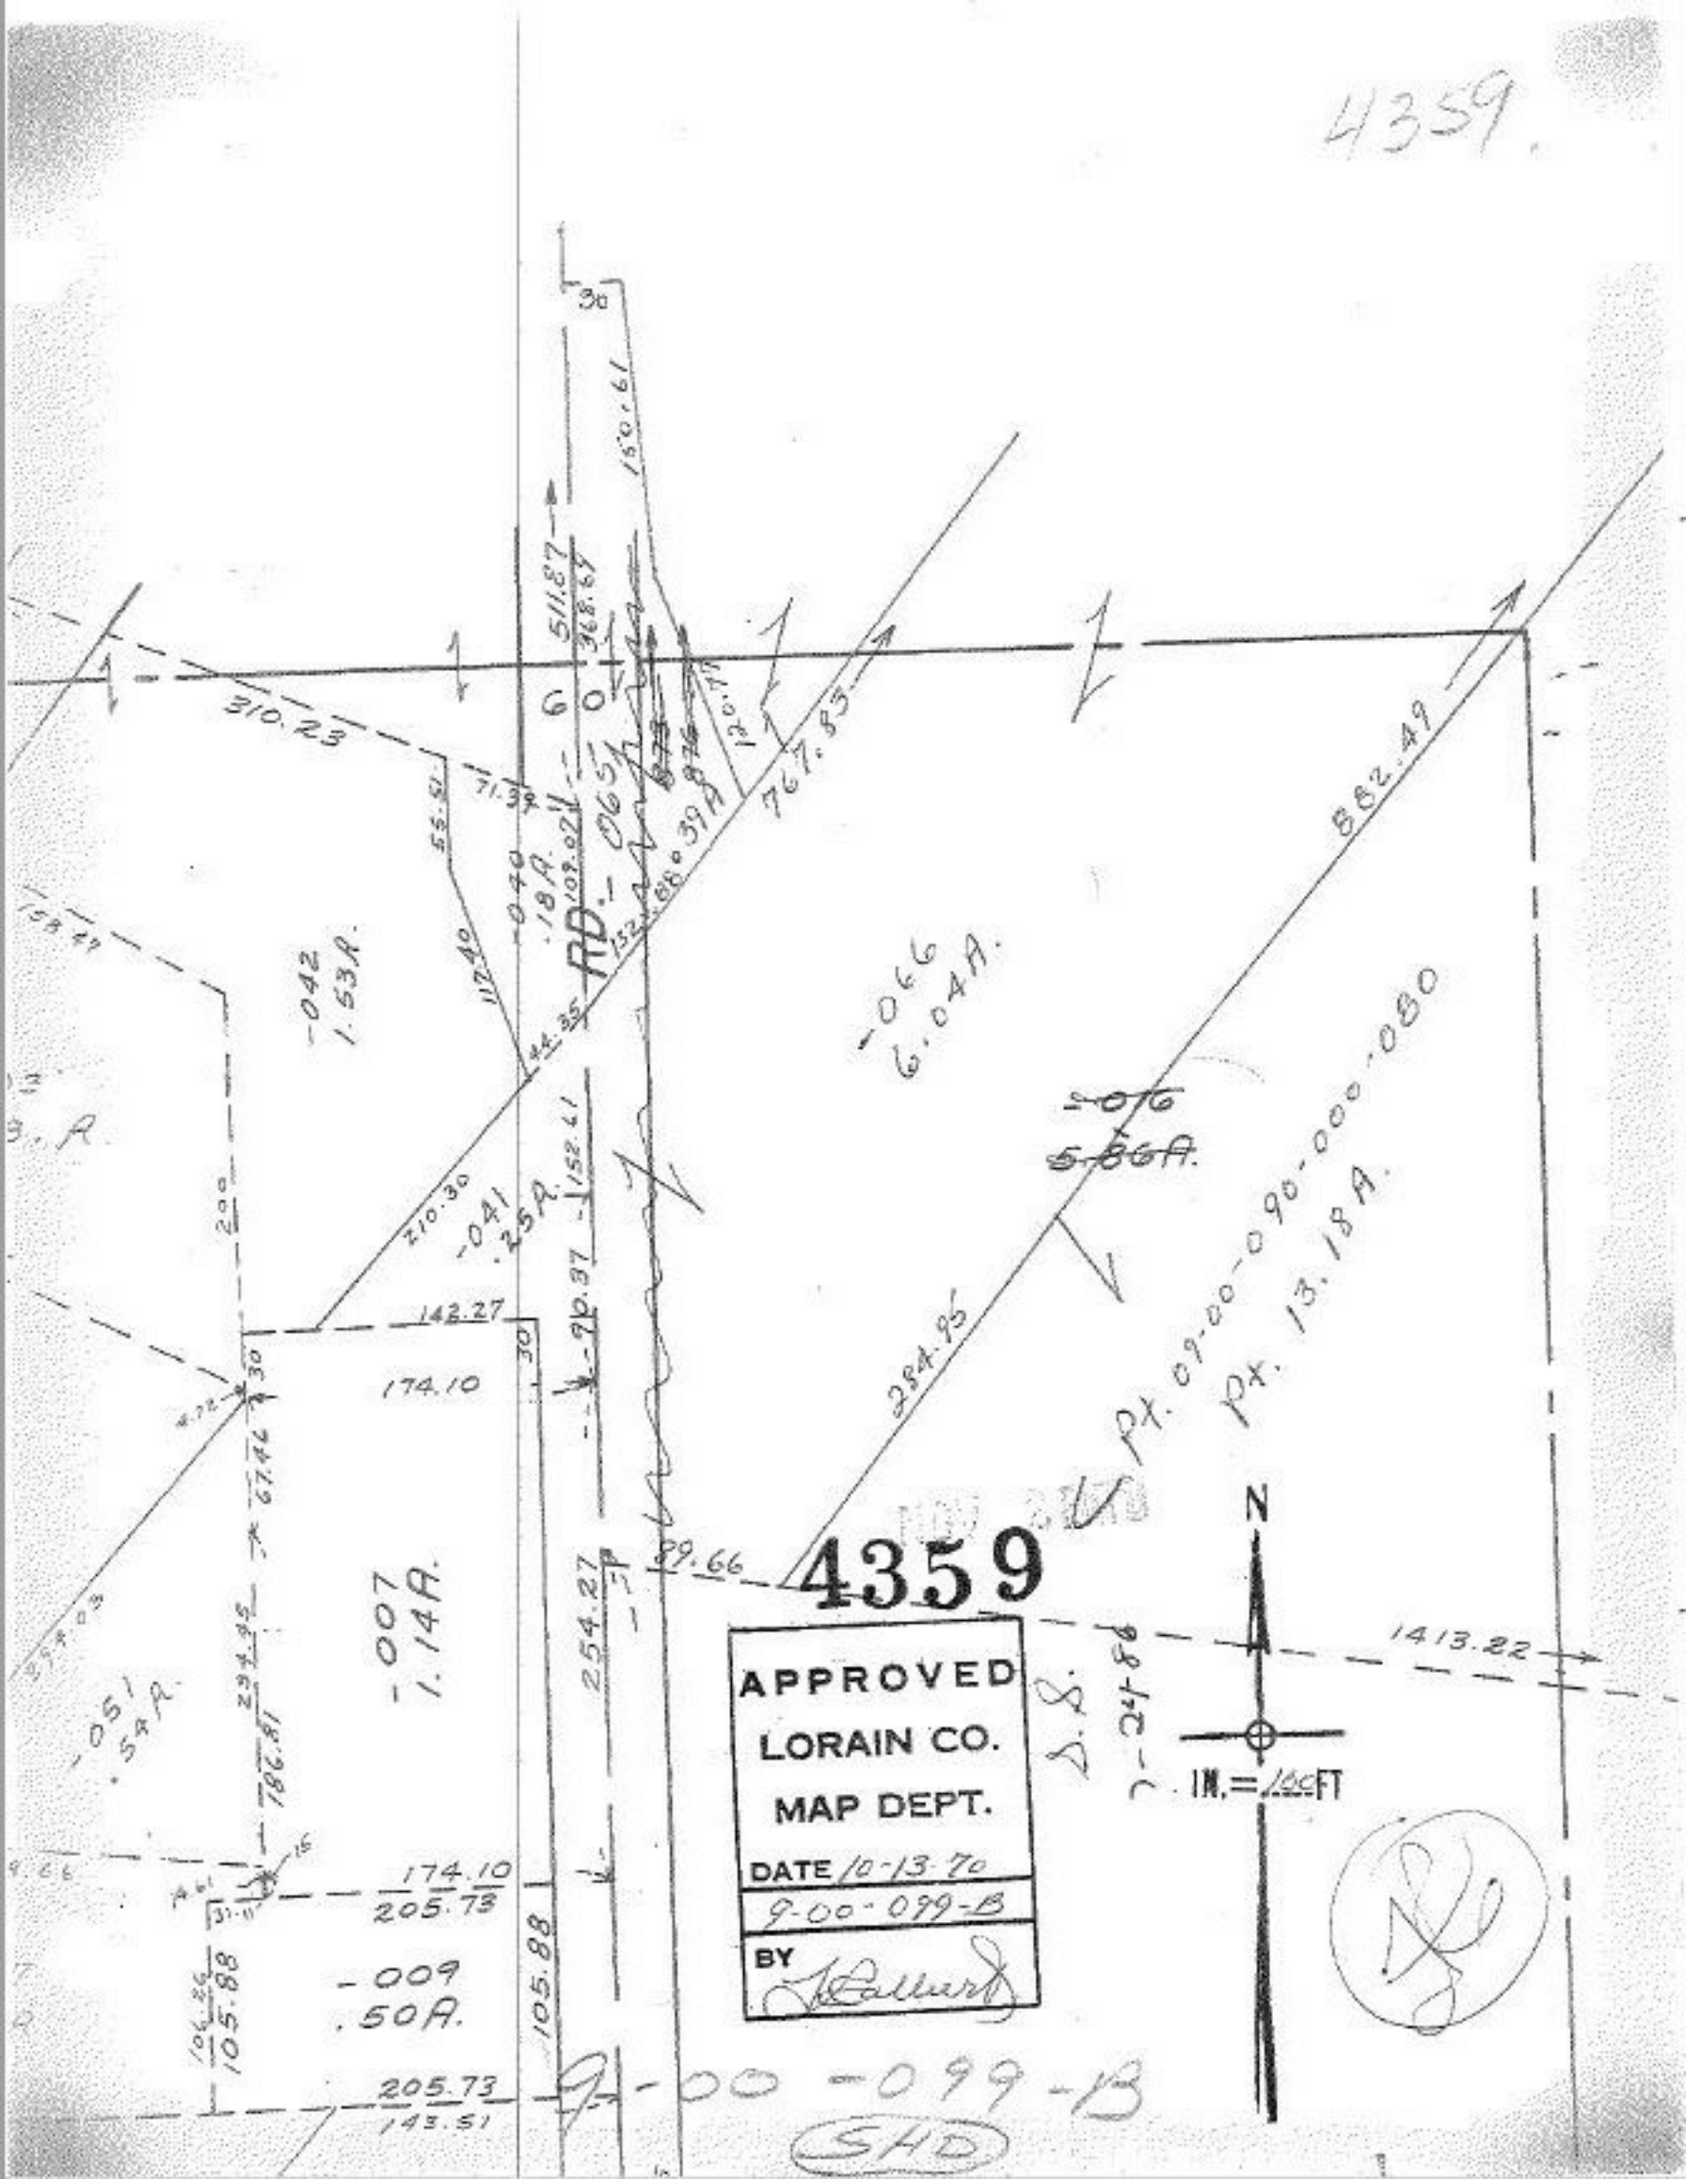
-042
1.53A.
-066
6.04A.
-076
5.86A.
-041
.25A.
-040
.18A.
-007
1.14A.
-051
.54A.
-009
.50A.
RD.
Pt. 09-00-090-000-080
Pt. 13.18A.
4359
APPROVED
LORAIN CO.
MAP DEPT.
DATE 10-13-70
9-00-099-B
BY
N
1 IN. = 100 FT
9-00-099-13
SAD