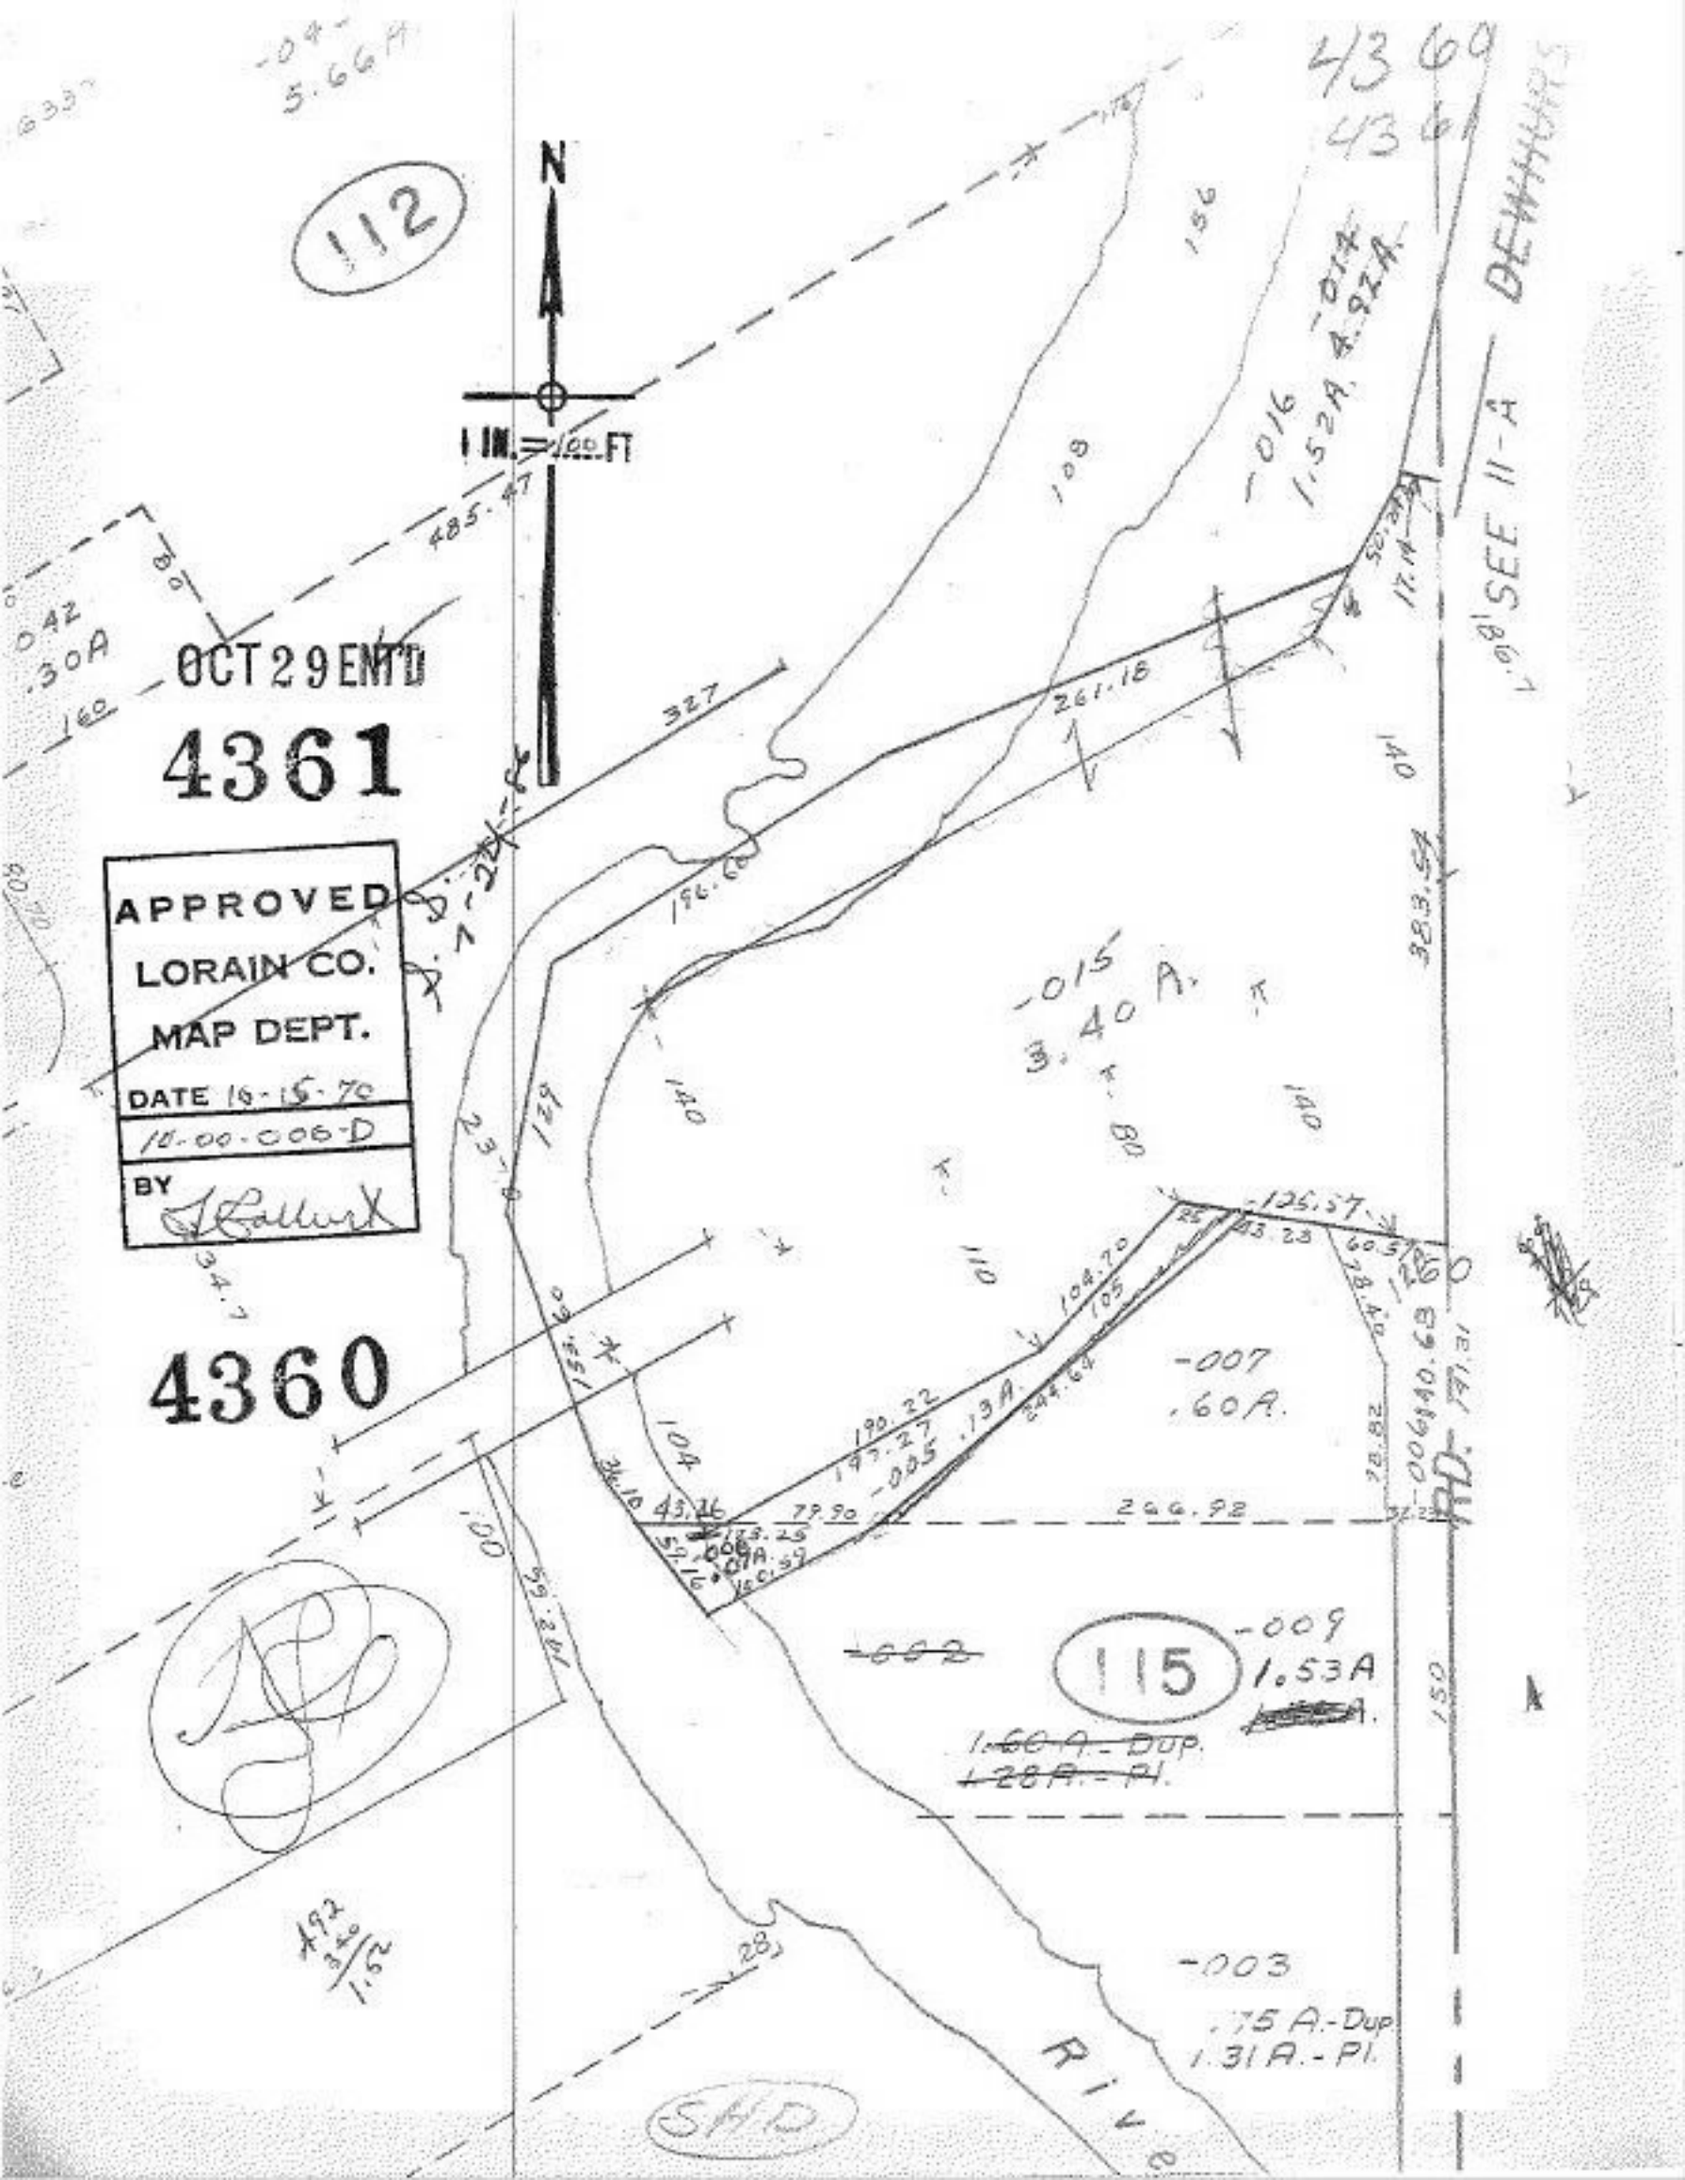

112
N
1 IN. = 100 FT
OCT 29 ENT'D
4361
APPROVED
LORAIN CO.
MAP DEPT.
DATE 10-15-70
10-00-006-D
BY
4360
-015
3.40 A.
-007
.60 A.
-009
1.53 A
115
1.60 A. - Dup.
1.28 A. - Pl.
-003
.75 A. - Dup.
1.31 A. - Pl.
SEE 11-A
DEWHURST
RD.
River
SHD