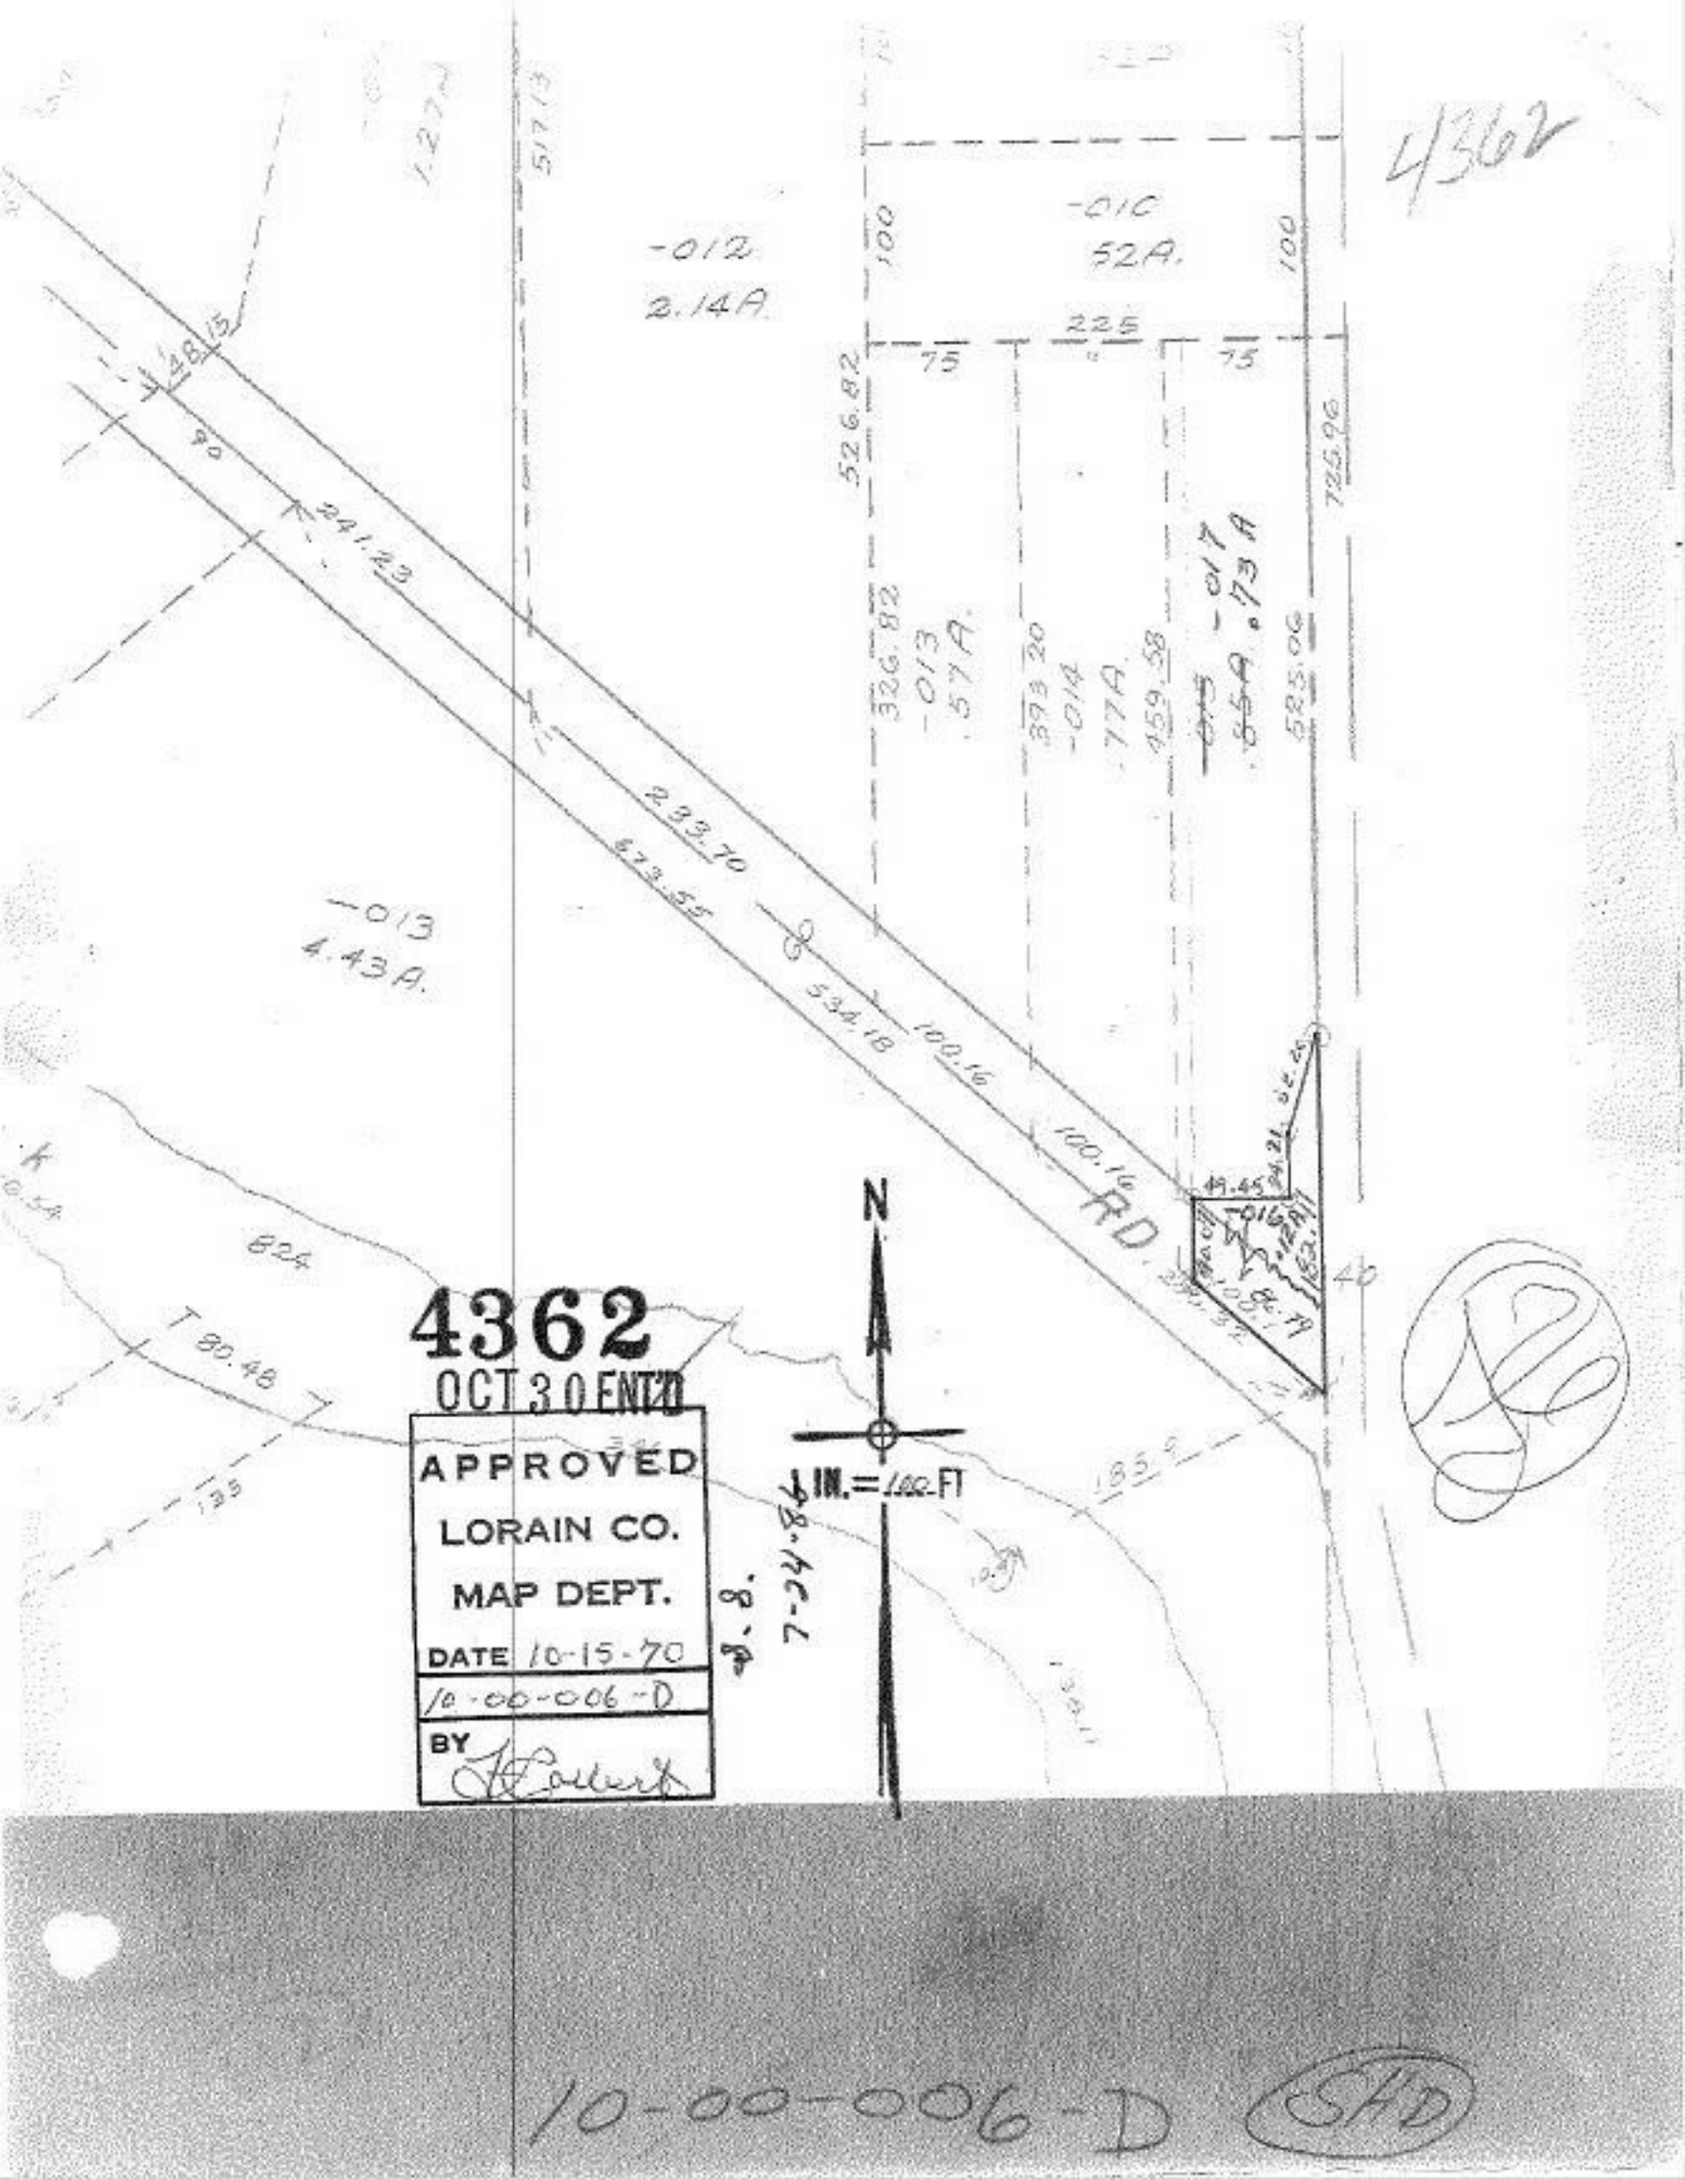
4362
-012
2.14A.
-013
4.43A.
-016
52A.
-017
.173A
-013
.57A.
-014
.77A.
100
225
75
526.82
326.82
393.20
459.58
525.06
725.96
241.23
233.70
473.52
534.18
100.16
100.16
RD.
824
T 80.48
135
185
49.45
N
1 IN. = 100 FT
7-24-84
4362
OCT 30 ENT'D
APPROVED
LORAIN CO.
MAP DEPT.
DATE 10-15-70
10-00-006-D
BY
10-00-006-D
SFD