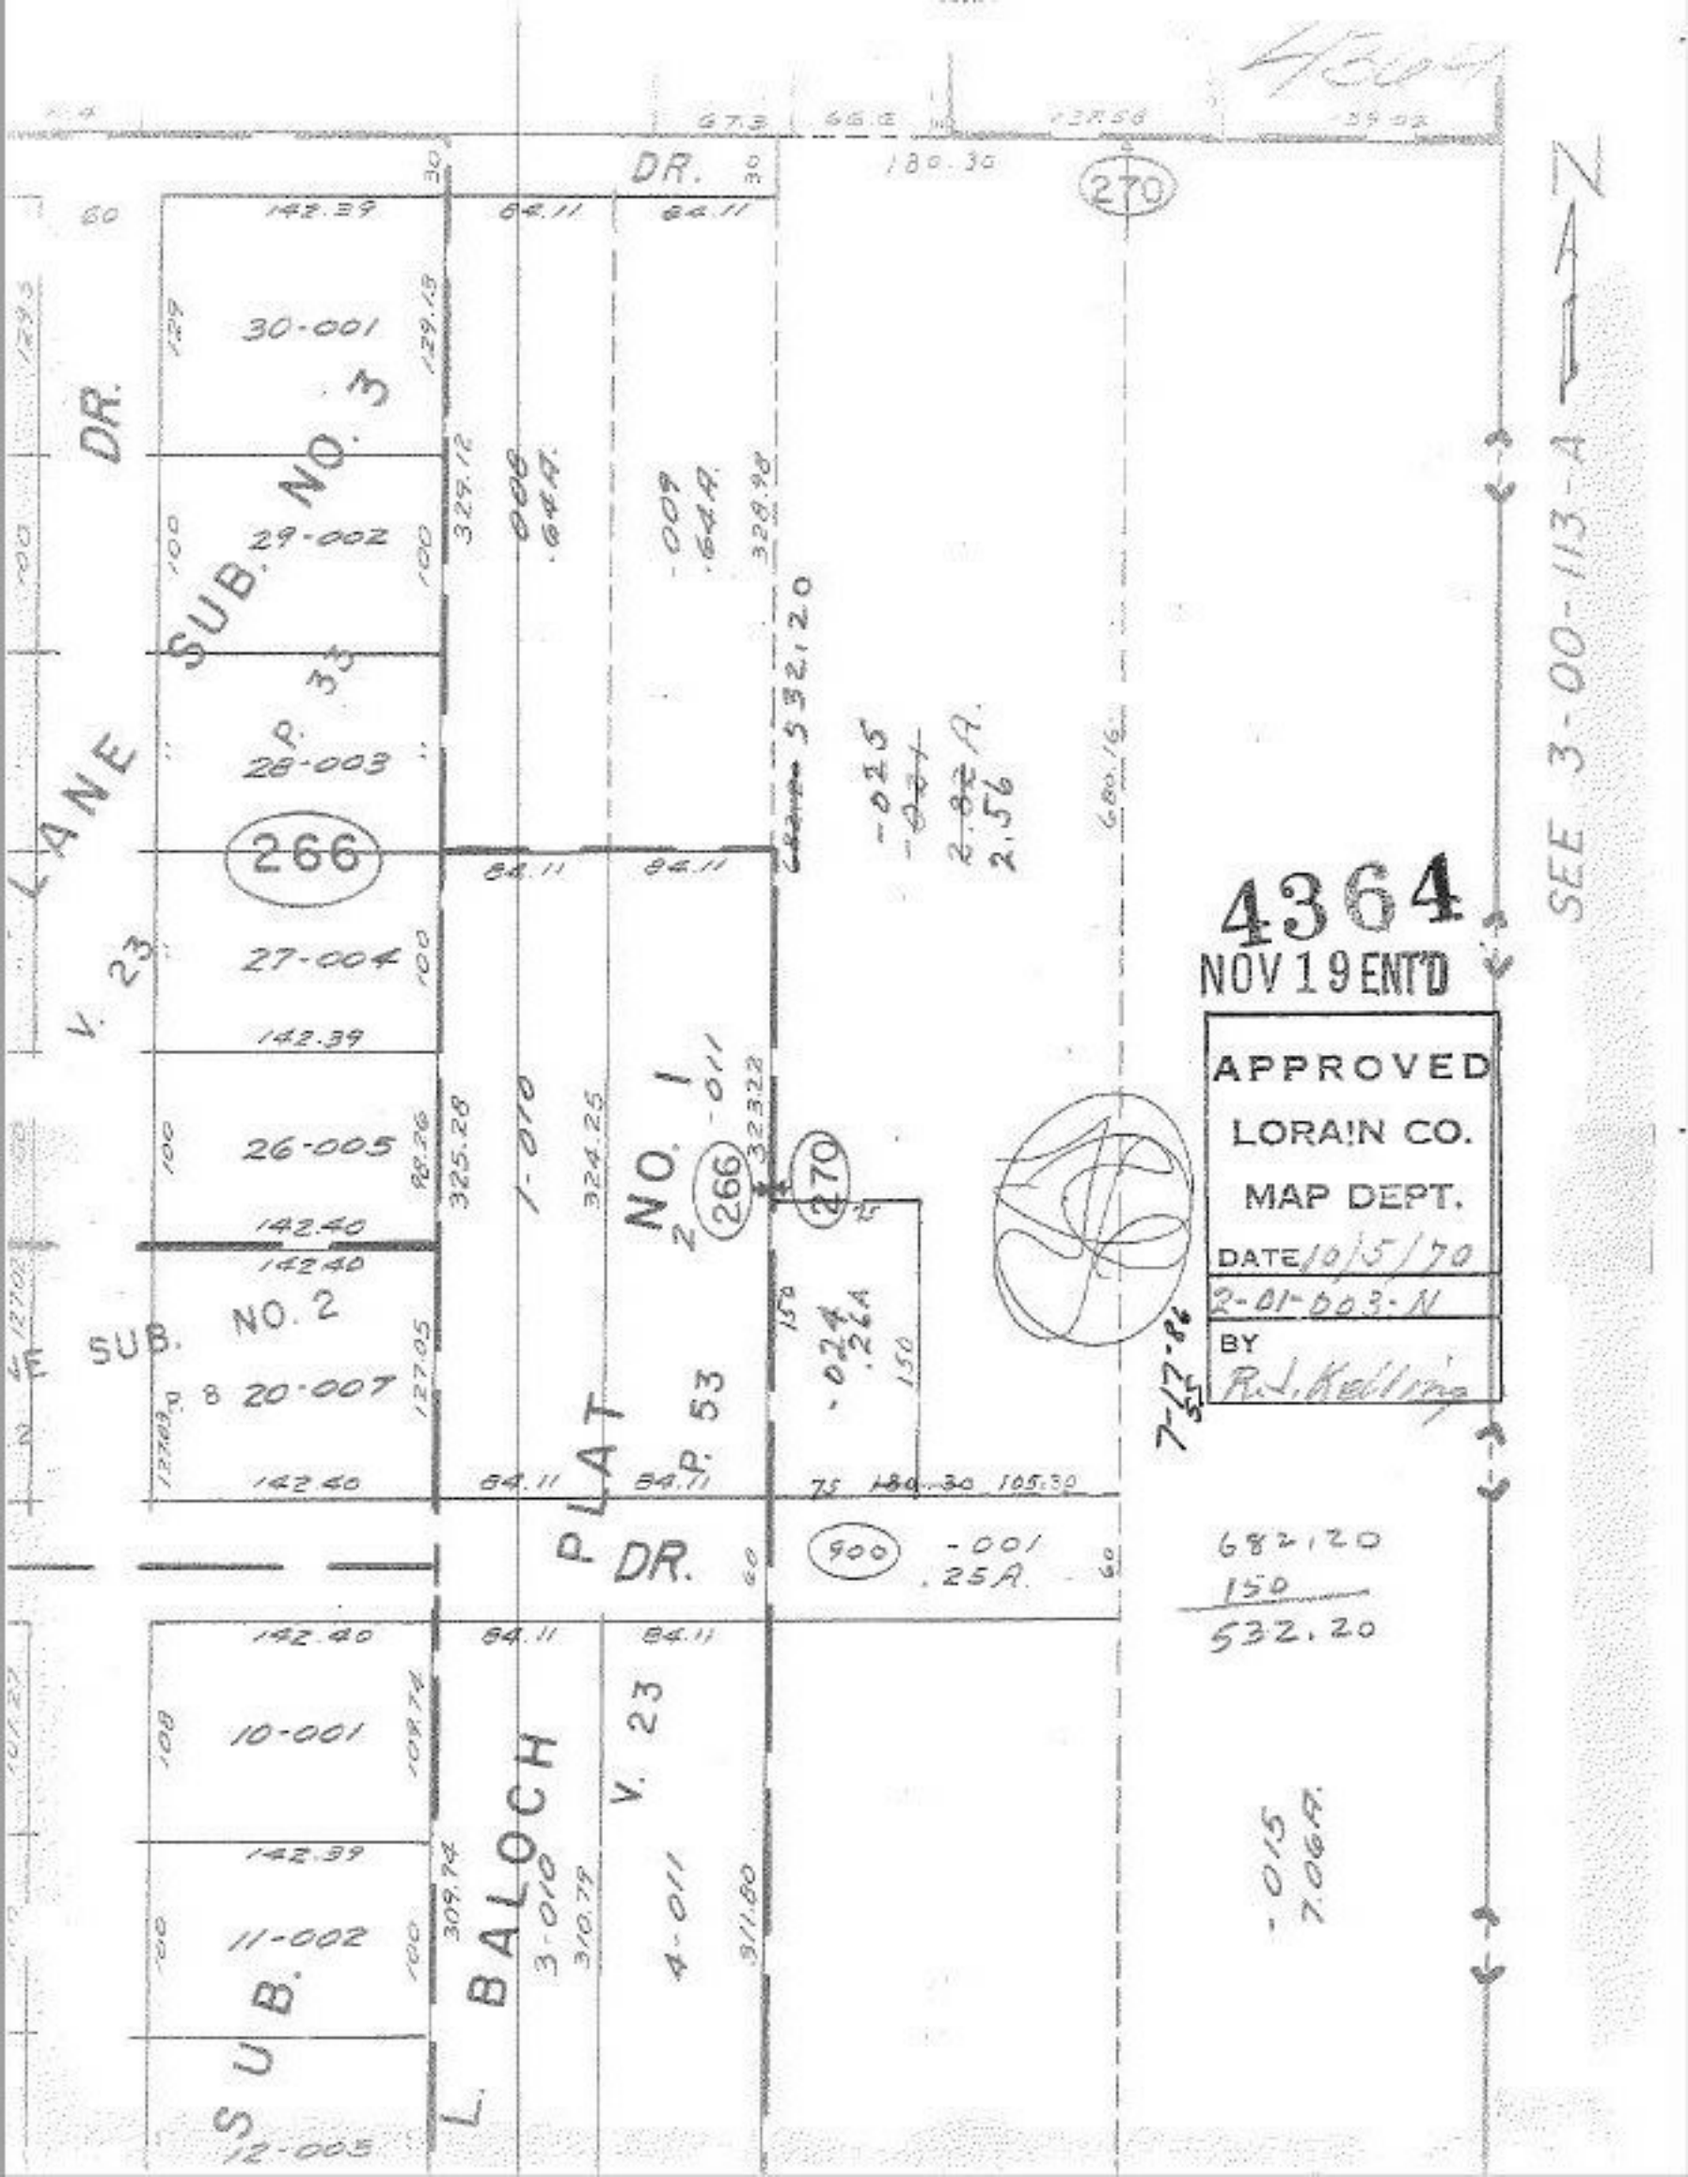

4364
NOV 19 ENT'D
APPROVED
LORAIN CO.
MAP DEPT.
DATE 10/5/70
2-01-003-N
BY R.J. Kelling
SEE 3-00-113-A
N
DR.
LANE SUB. NO. 3
V. 23
P. 33
30-001
29-002
28-003
266
27-004
26-005
SUB. NO. 2
20-007
PLAT NO. 1
P. 53
DR.
900
-001
.25A.
10-001
11-002
12-003
SUB.
L. BALOCH
V. 23
3-010
4-011
-015
7.06A.
682.20
150
532.20
-025
2.56
-024
.26A
-011
-009
.64A.
-008
.64A.
-010
1-010
532.20
680.16
180.30
142.39
84.11
129.13
329.12
328.98
325.28
324.25
323.22
127.05
105.30
309.74
310.79
311.80