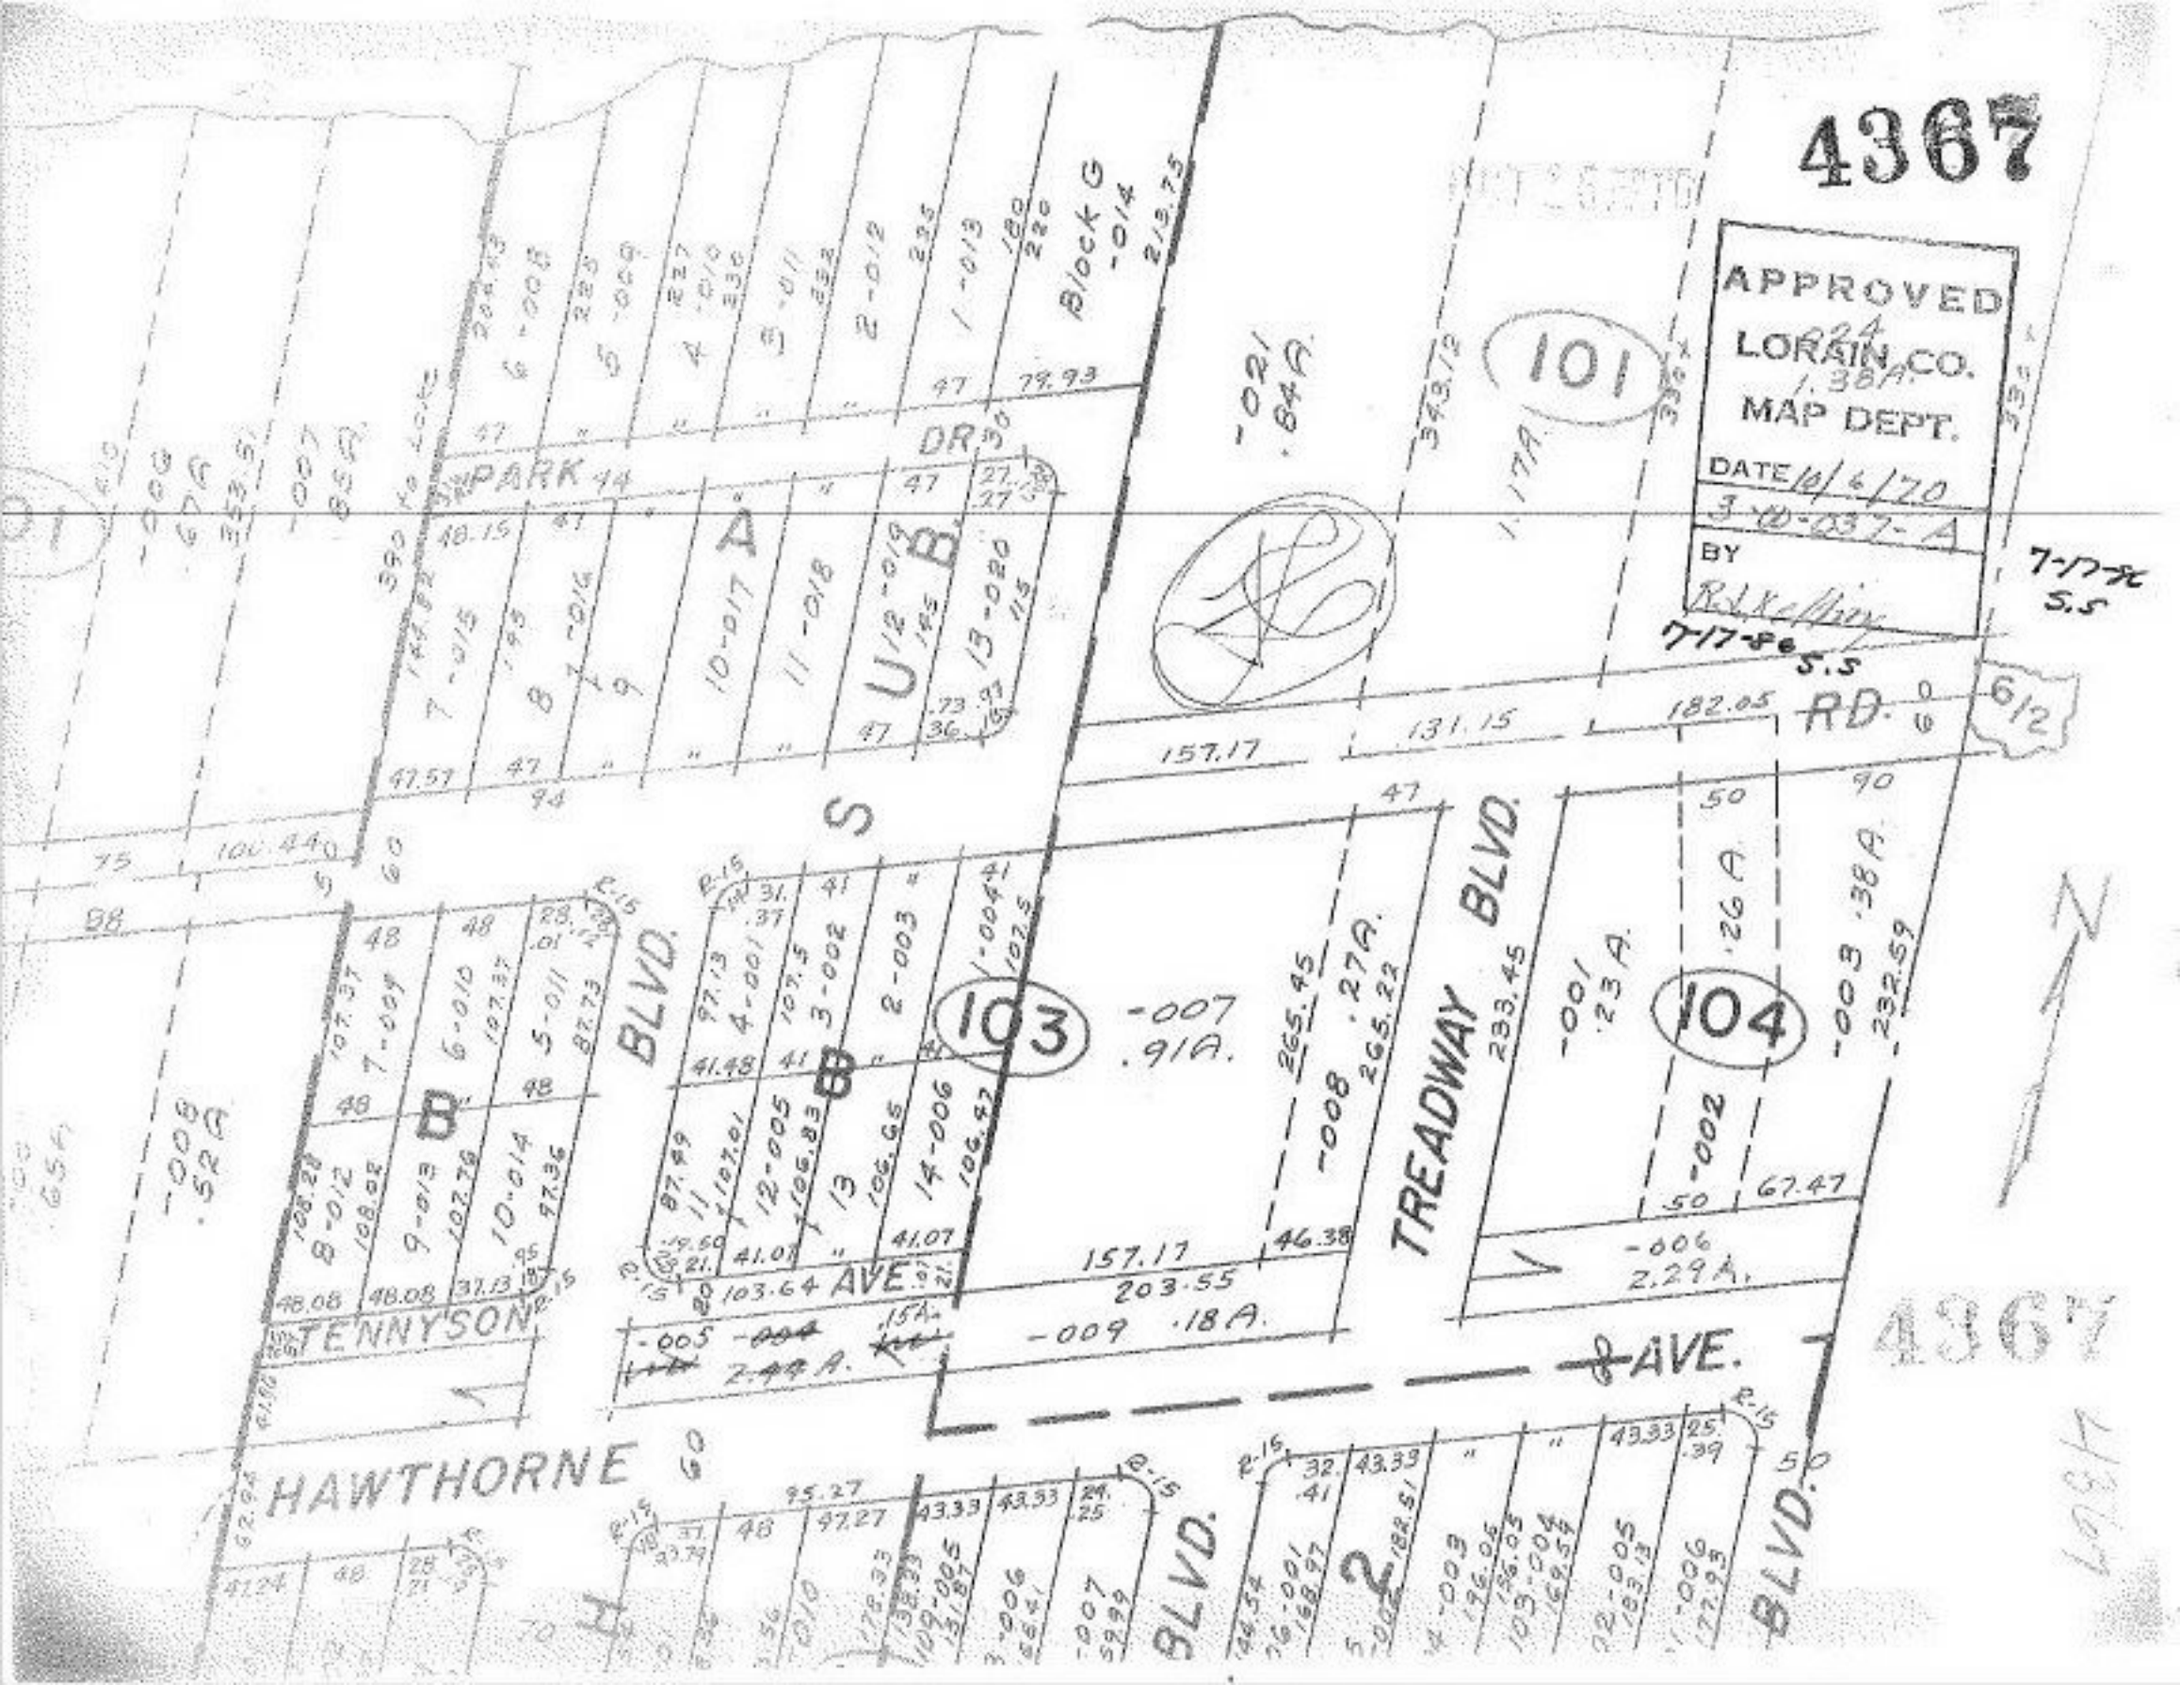
4367
APPROVED
LORAIN CO.
MAP DEPT.
DATE 10/6/70
BY
PARK
DR
BLVD.
TREADWAY BLVD.
AVE.
TENNYSON
HAWTHORNE
101
103
104
Block G
Block A
Block B
Block H
-021 .64A.
-007 .91A.
-008 .52A.
-009 .18A.
-001 .23A.
-003 .38A.
-006 2.29A.
-005 2.44A.
-002 .26A.
-008 .27A.
1.38A.
1.17A.
7-17-70 5.5
7-17-70 5.5
4367