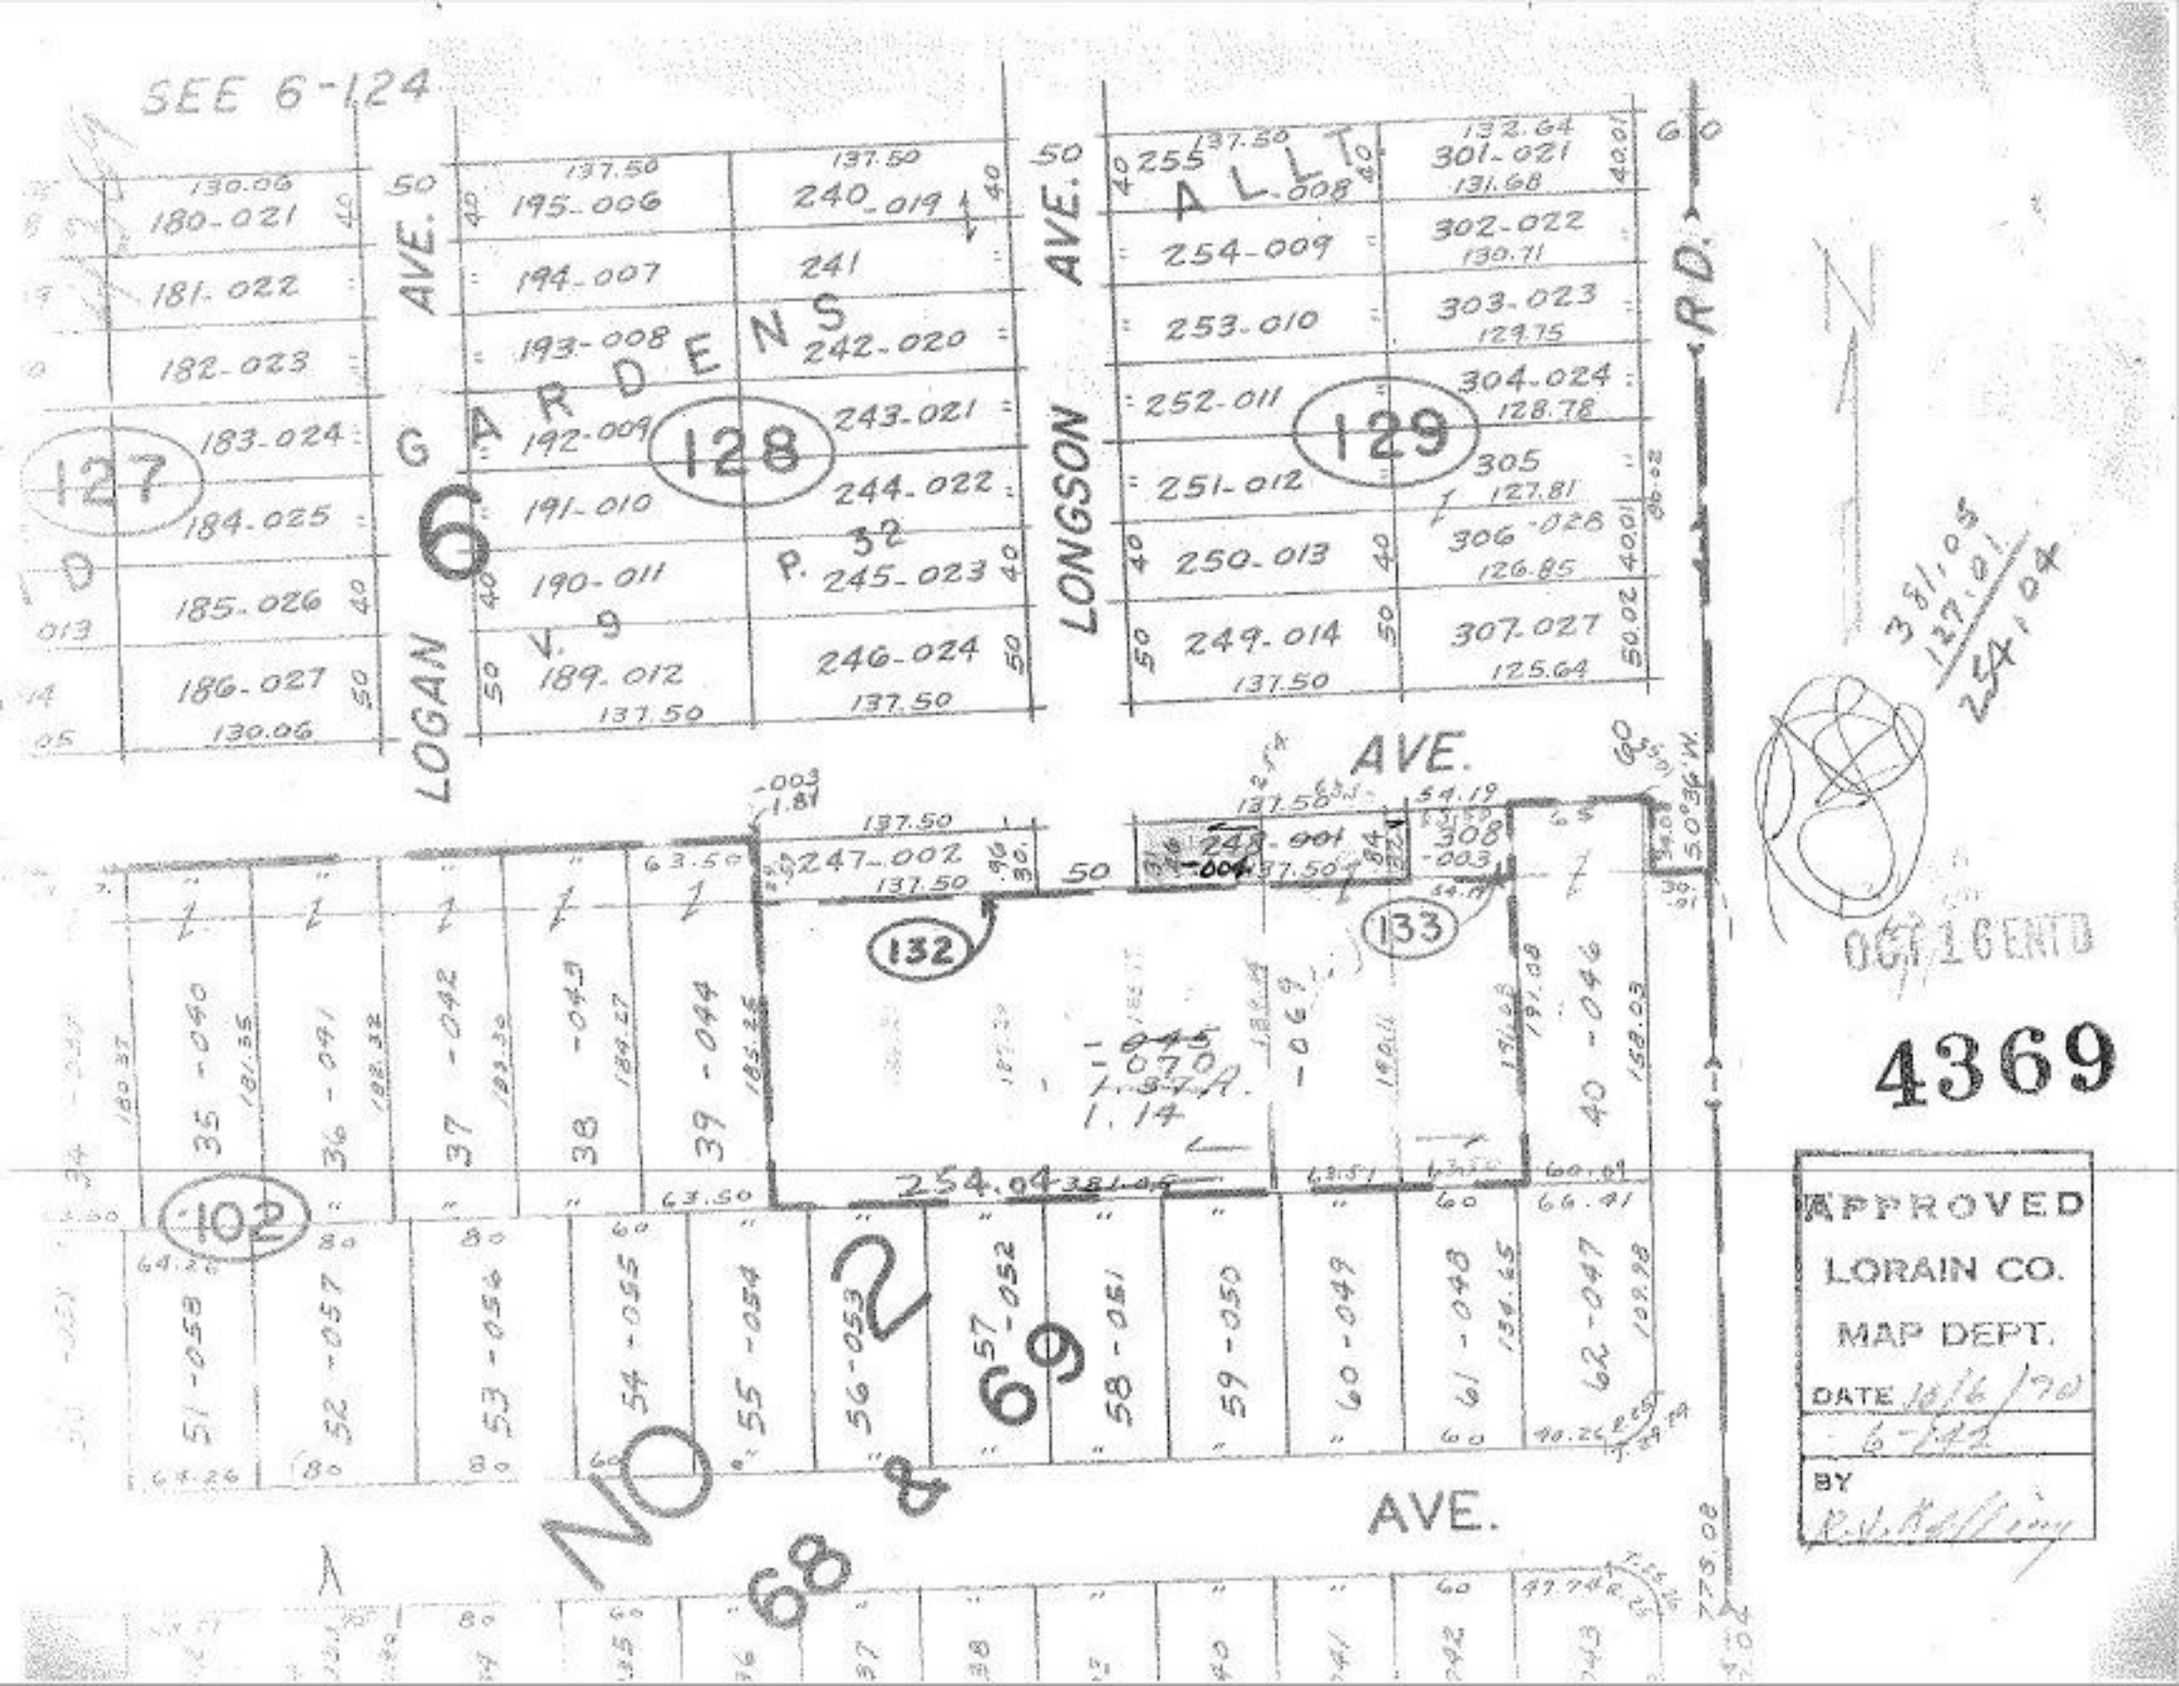
SEE 6-124
LOGAN AVE.
LONGSON AVE.
GARDENS
ALLT.
6
127
128
129
132
133
102
NO 68 & 69
AVE.
R.D.
N
381.05
127.01
254.04
OCT 16 ENTD
4369
APPROVED
LORAIN CO.
MAP DEPT.
DATE 10/6/70
6-142
BY