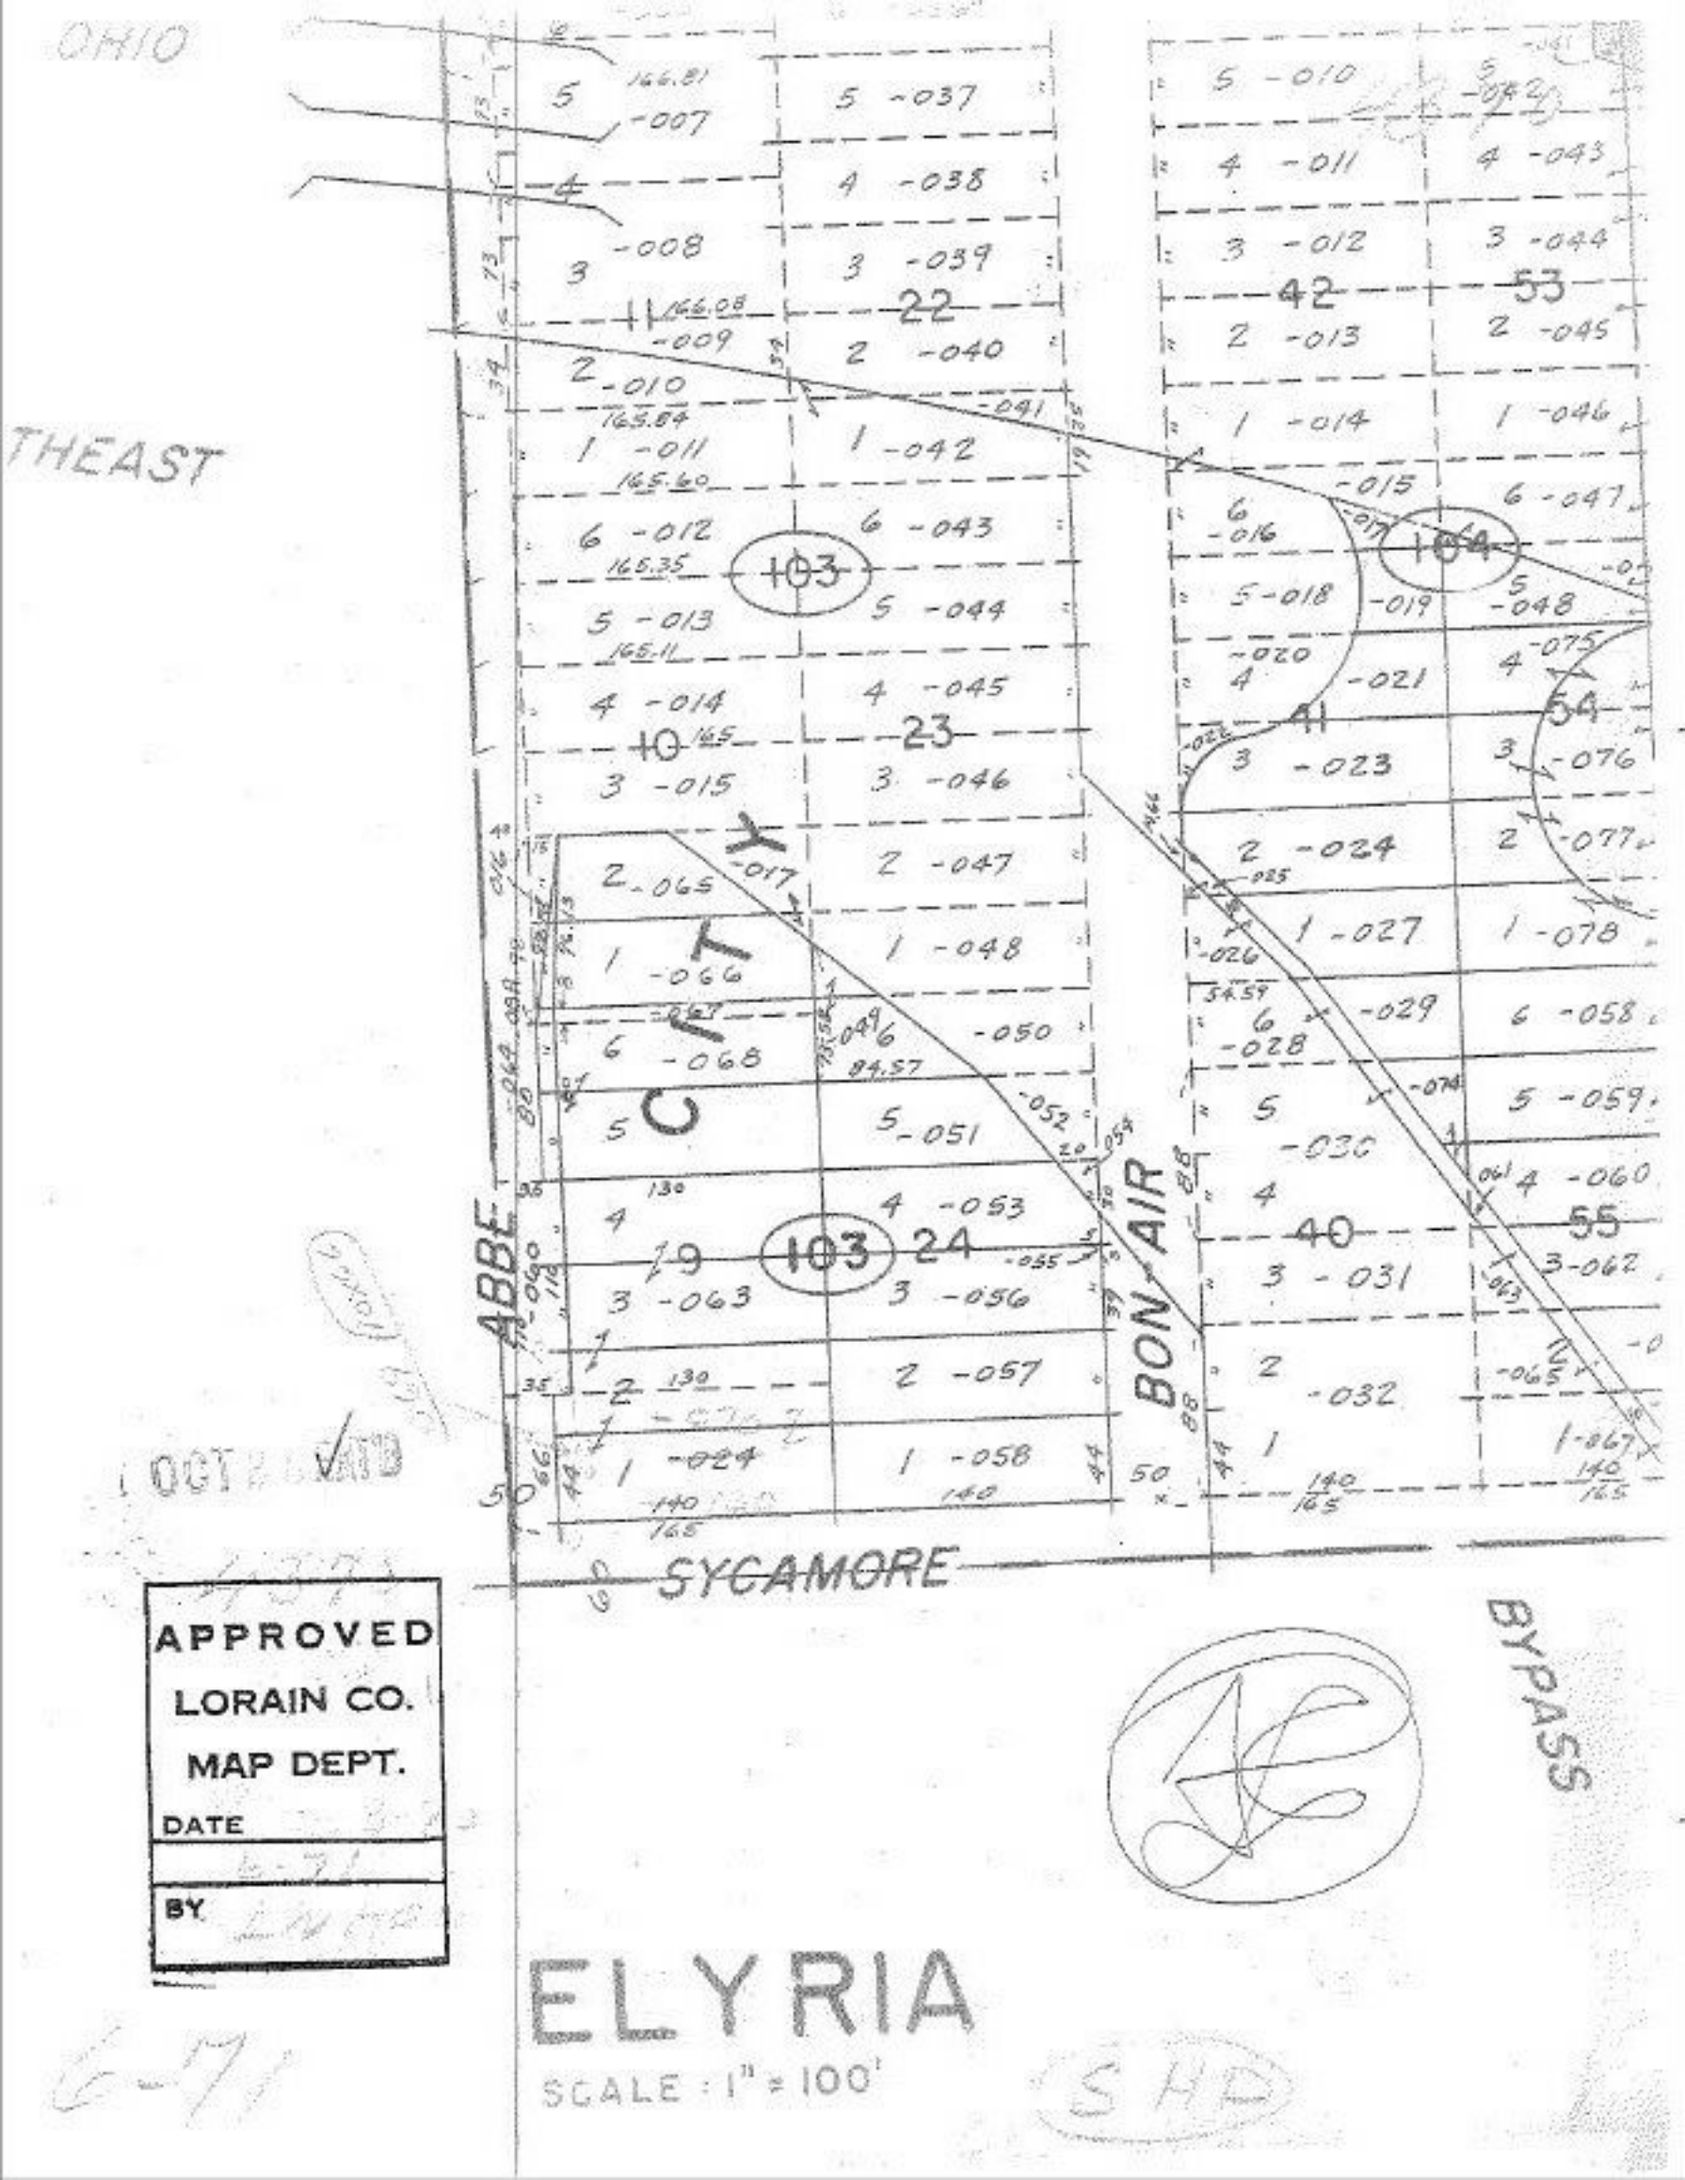
OHIO
THEAST
ABBE
BON AIR
SYCAMORE
BYPASS
CITY
103
104
22
23
24
41
42
40
53
54
55
APPROVED
LORAIN CO.
MAP DEPT.
DATE
BY
ELYRIA
SCALE : 1" = 100'