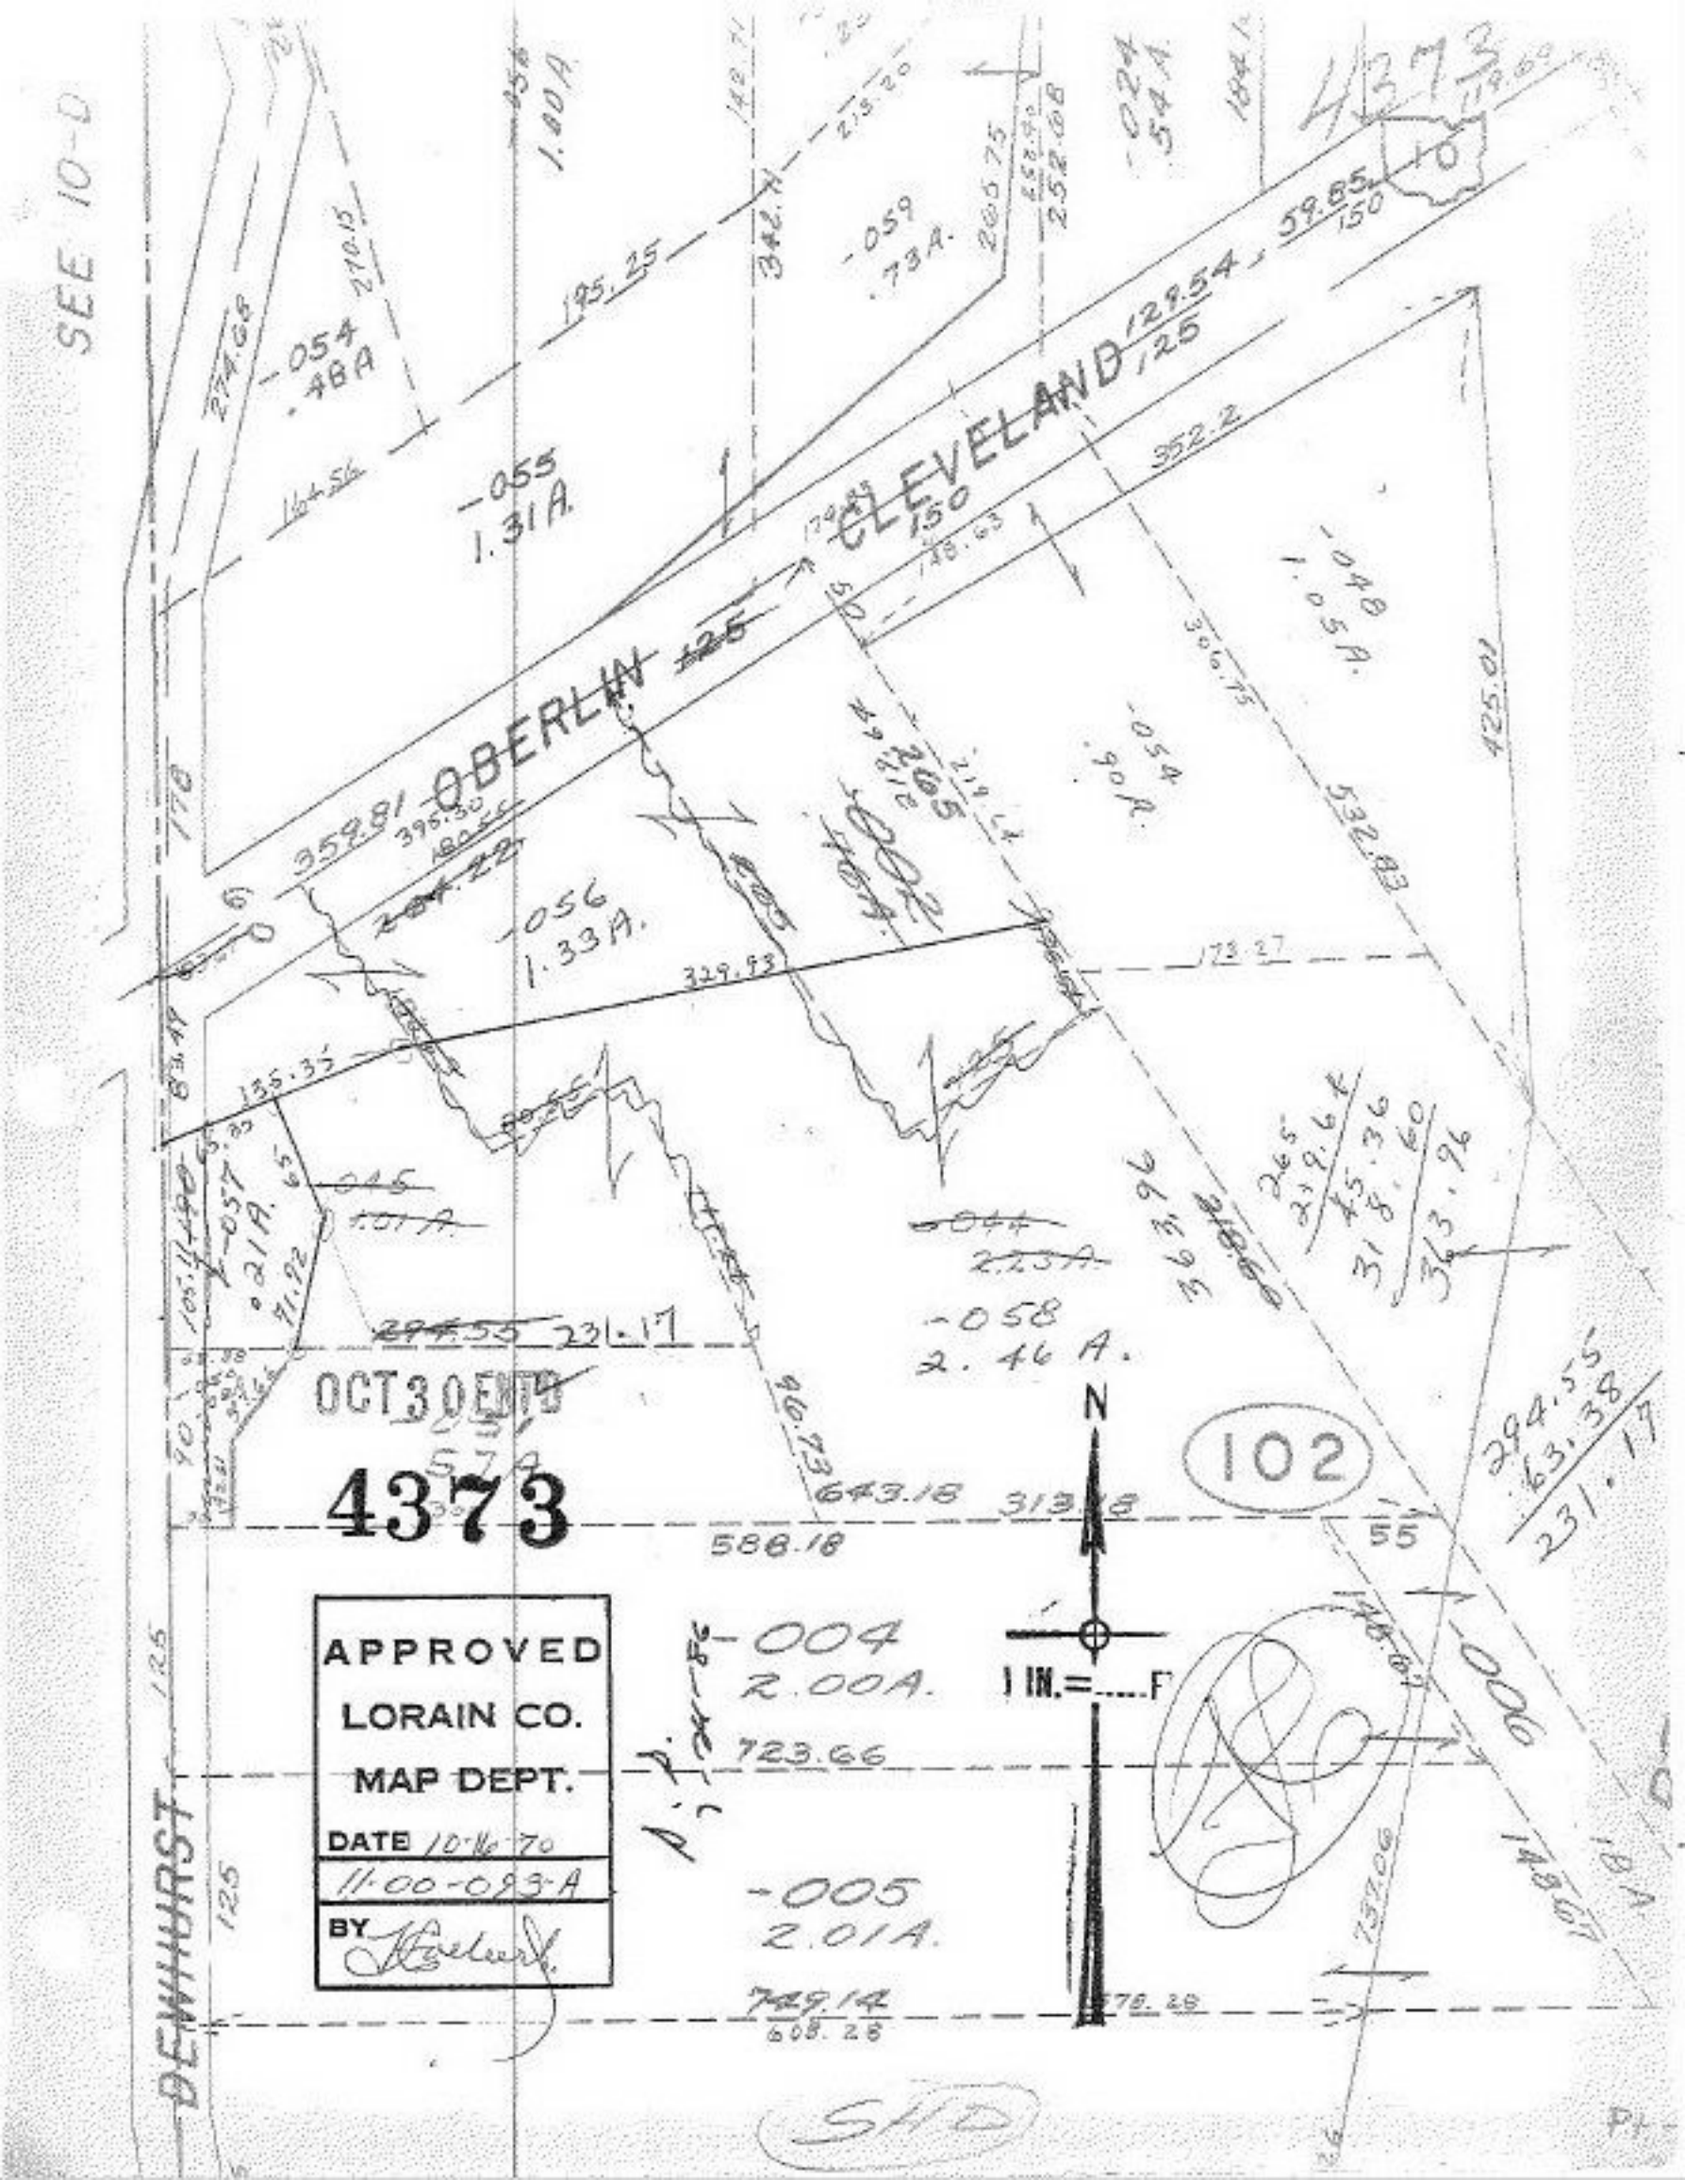
SEE 10-D
4373
10
OBERLIN
CLEVELAND
DEWHURST
-054
.48A
-055
1.31A.
-059
.73A.
-056
1.33A.
-048
1.05A.
-054
.90A.
-058
2.46 A.
-004
2.00A.
-005
2.01A.
-057
.21A.
-044
2.23A.
-006
OCT 30 ENTD
4373
APPROVED
LORAIN CO.
MAP DEPT.
DATE 10-16-70
11-00-093-A
BY
N
1 IN.=.....FT
102
SHD