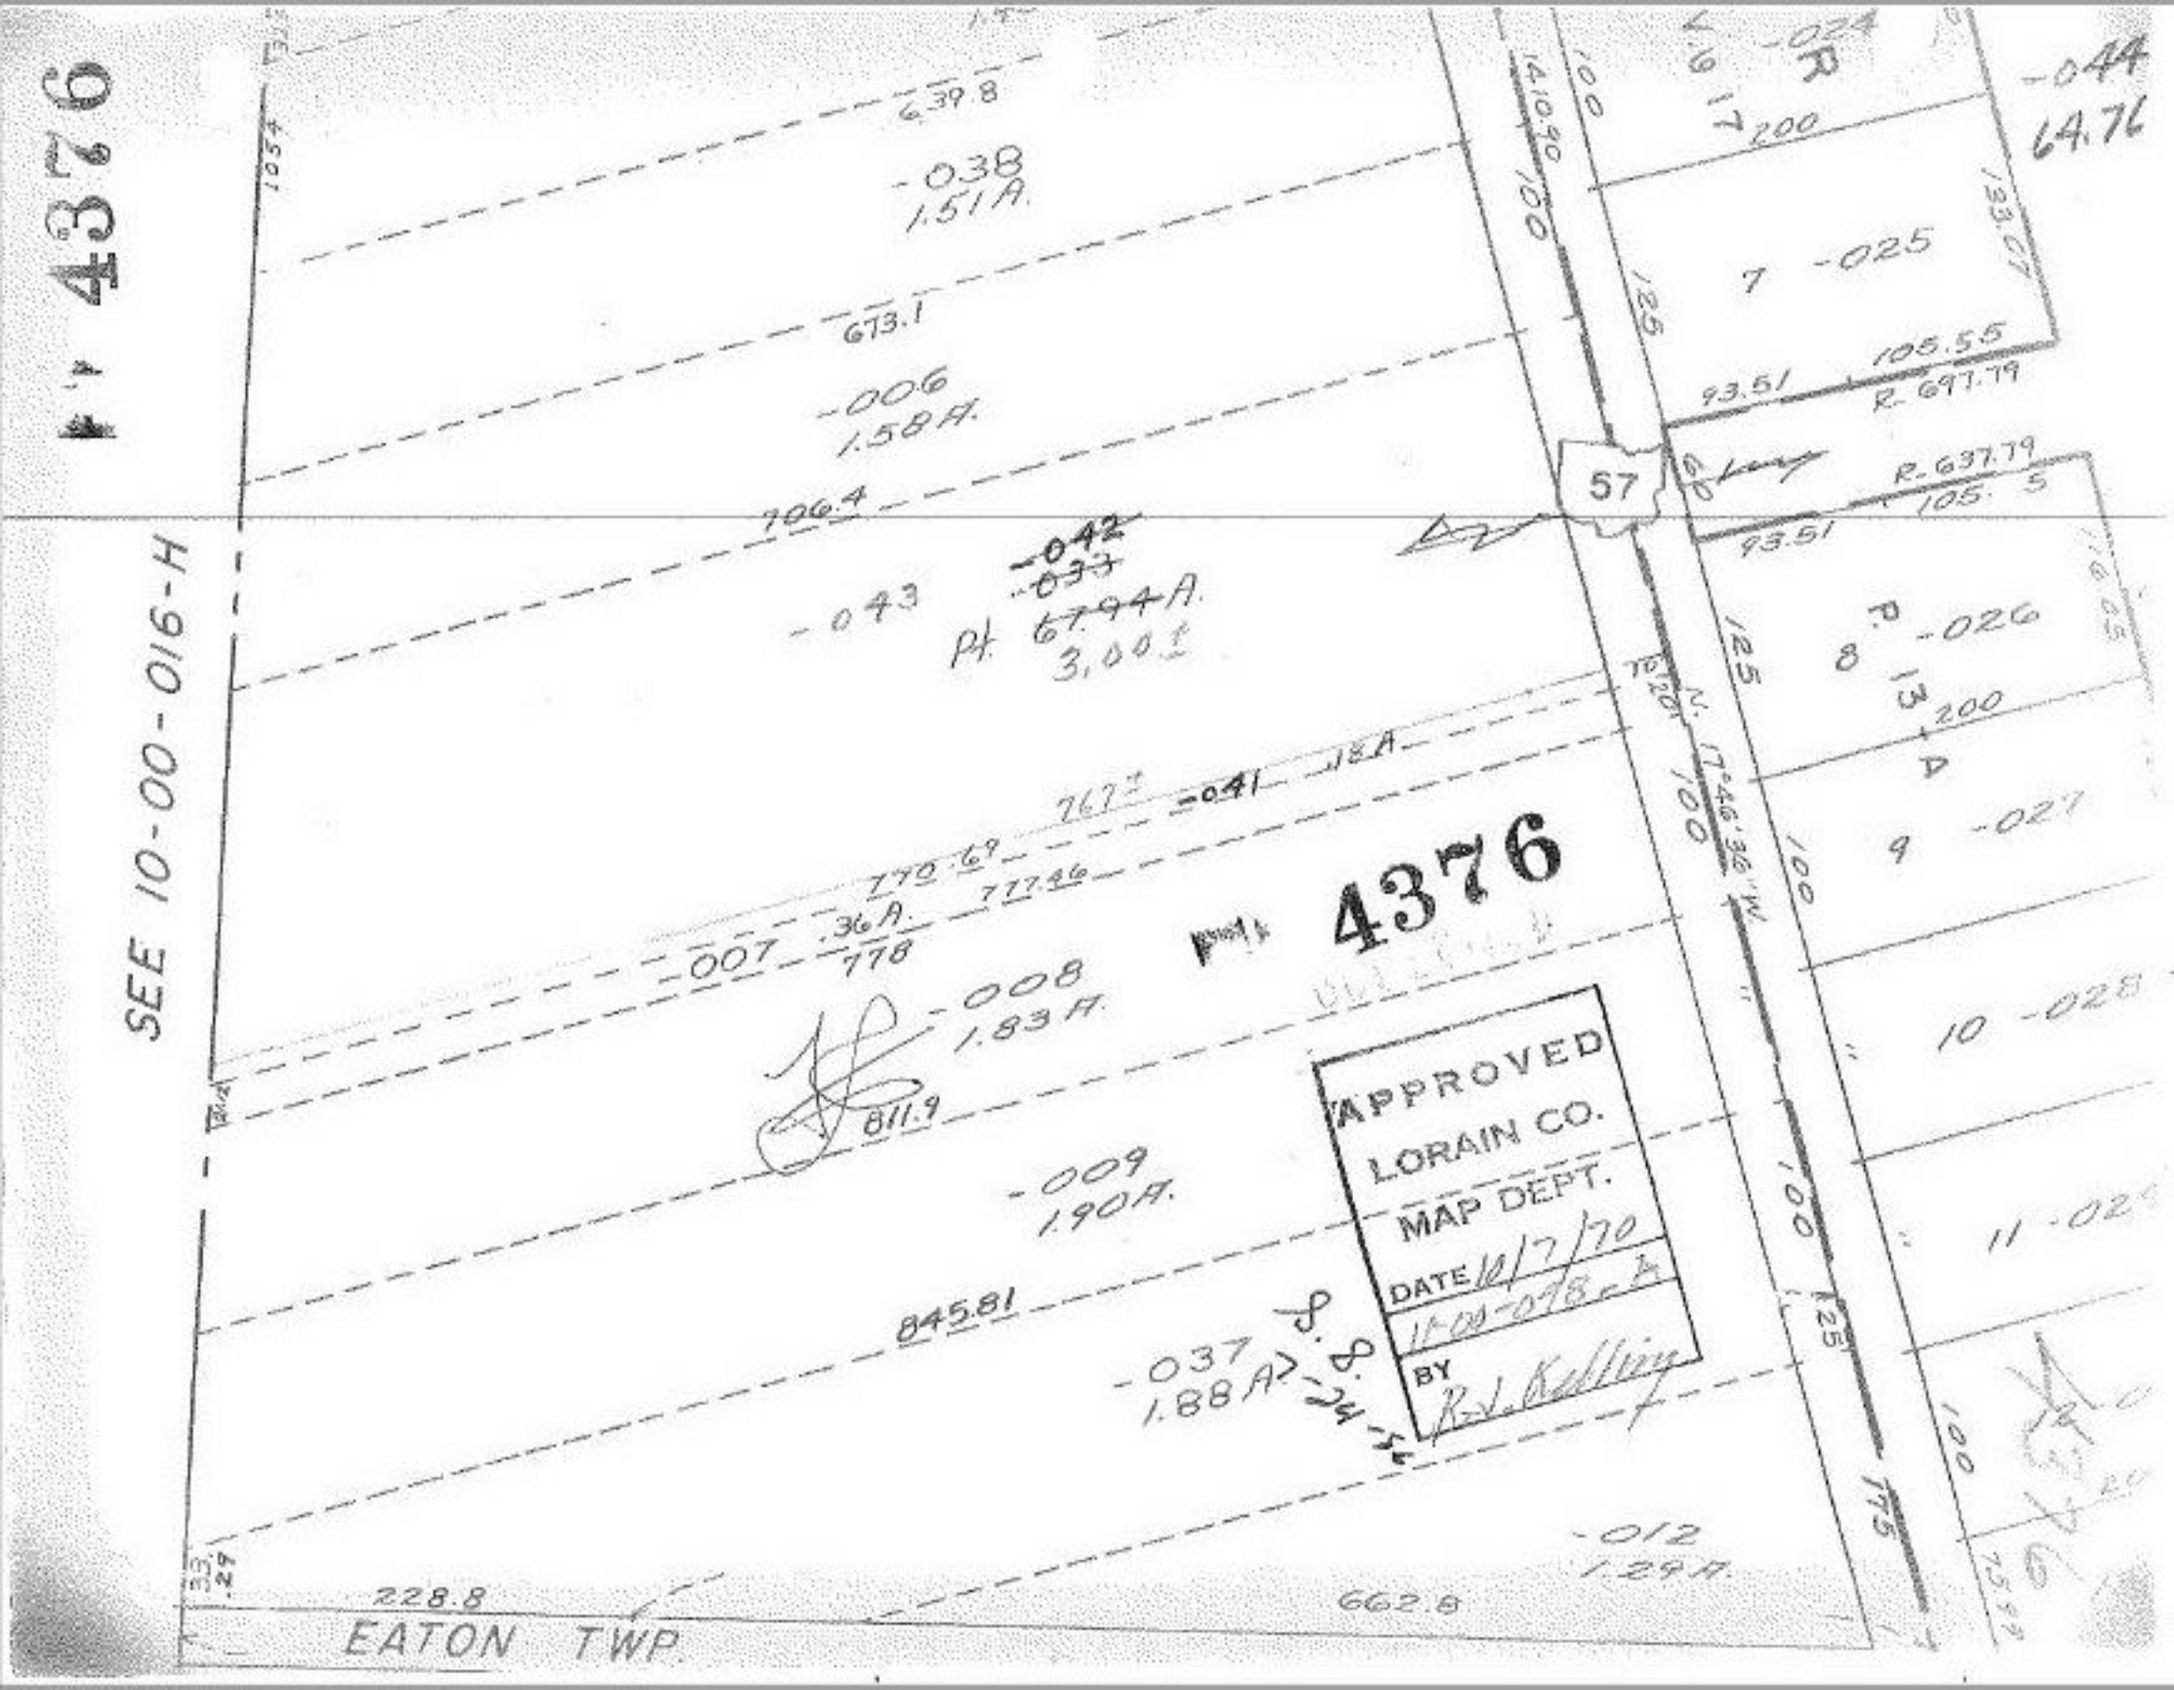

4376
SEE 10-00-016-H
EATON TWP.
57
APPROVED
LORAIN CO.
MAP DEPT.
DATE 10/7/70
BY
-038
1.51 A.
-006
1.58 A.
-043
Pt. 67.94 A.
3.00±
-041
-007
-008
1.83 A.
-009
1.90 A.
-037
1.88 A.
-012
1.29 A.
-024
-044
64.76
-025
-026
-027
-028
7
8
9
10
11
R. 697.79
R. 637.79
105.55
93.51
639.8
673.1
706.4
811.9
845.81
228.8
662.8