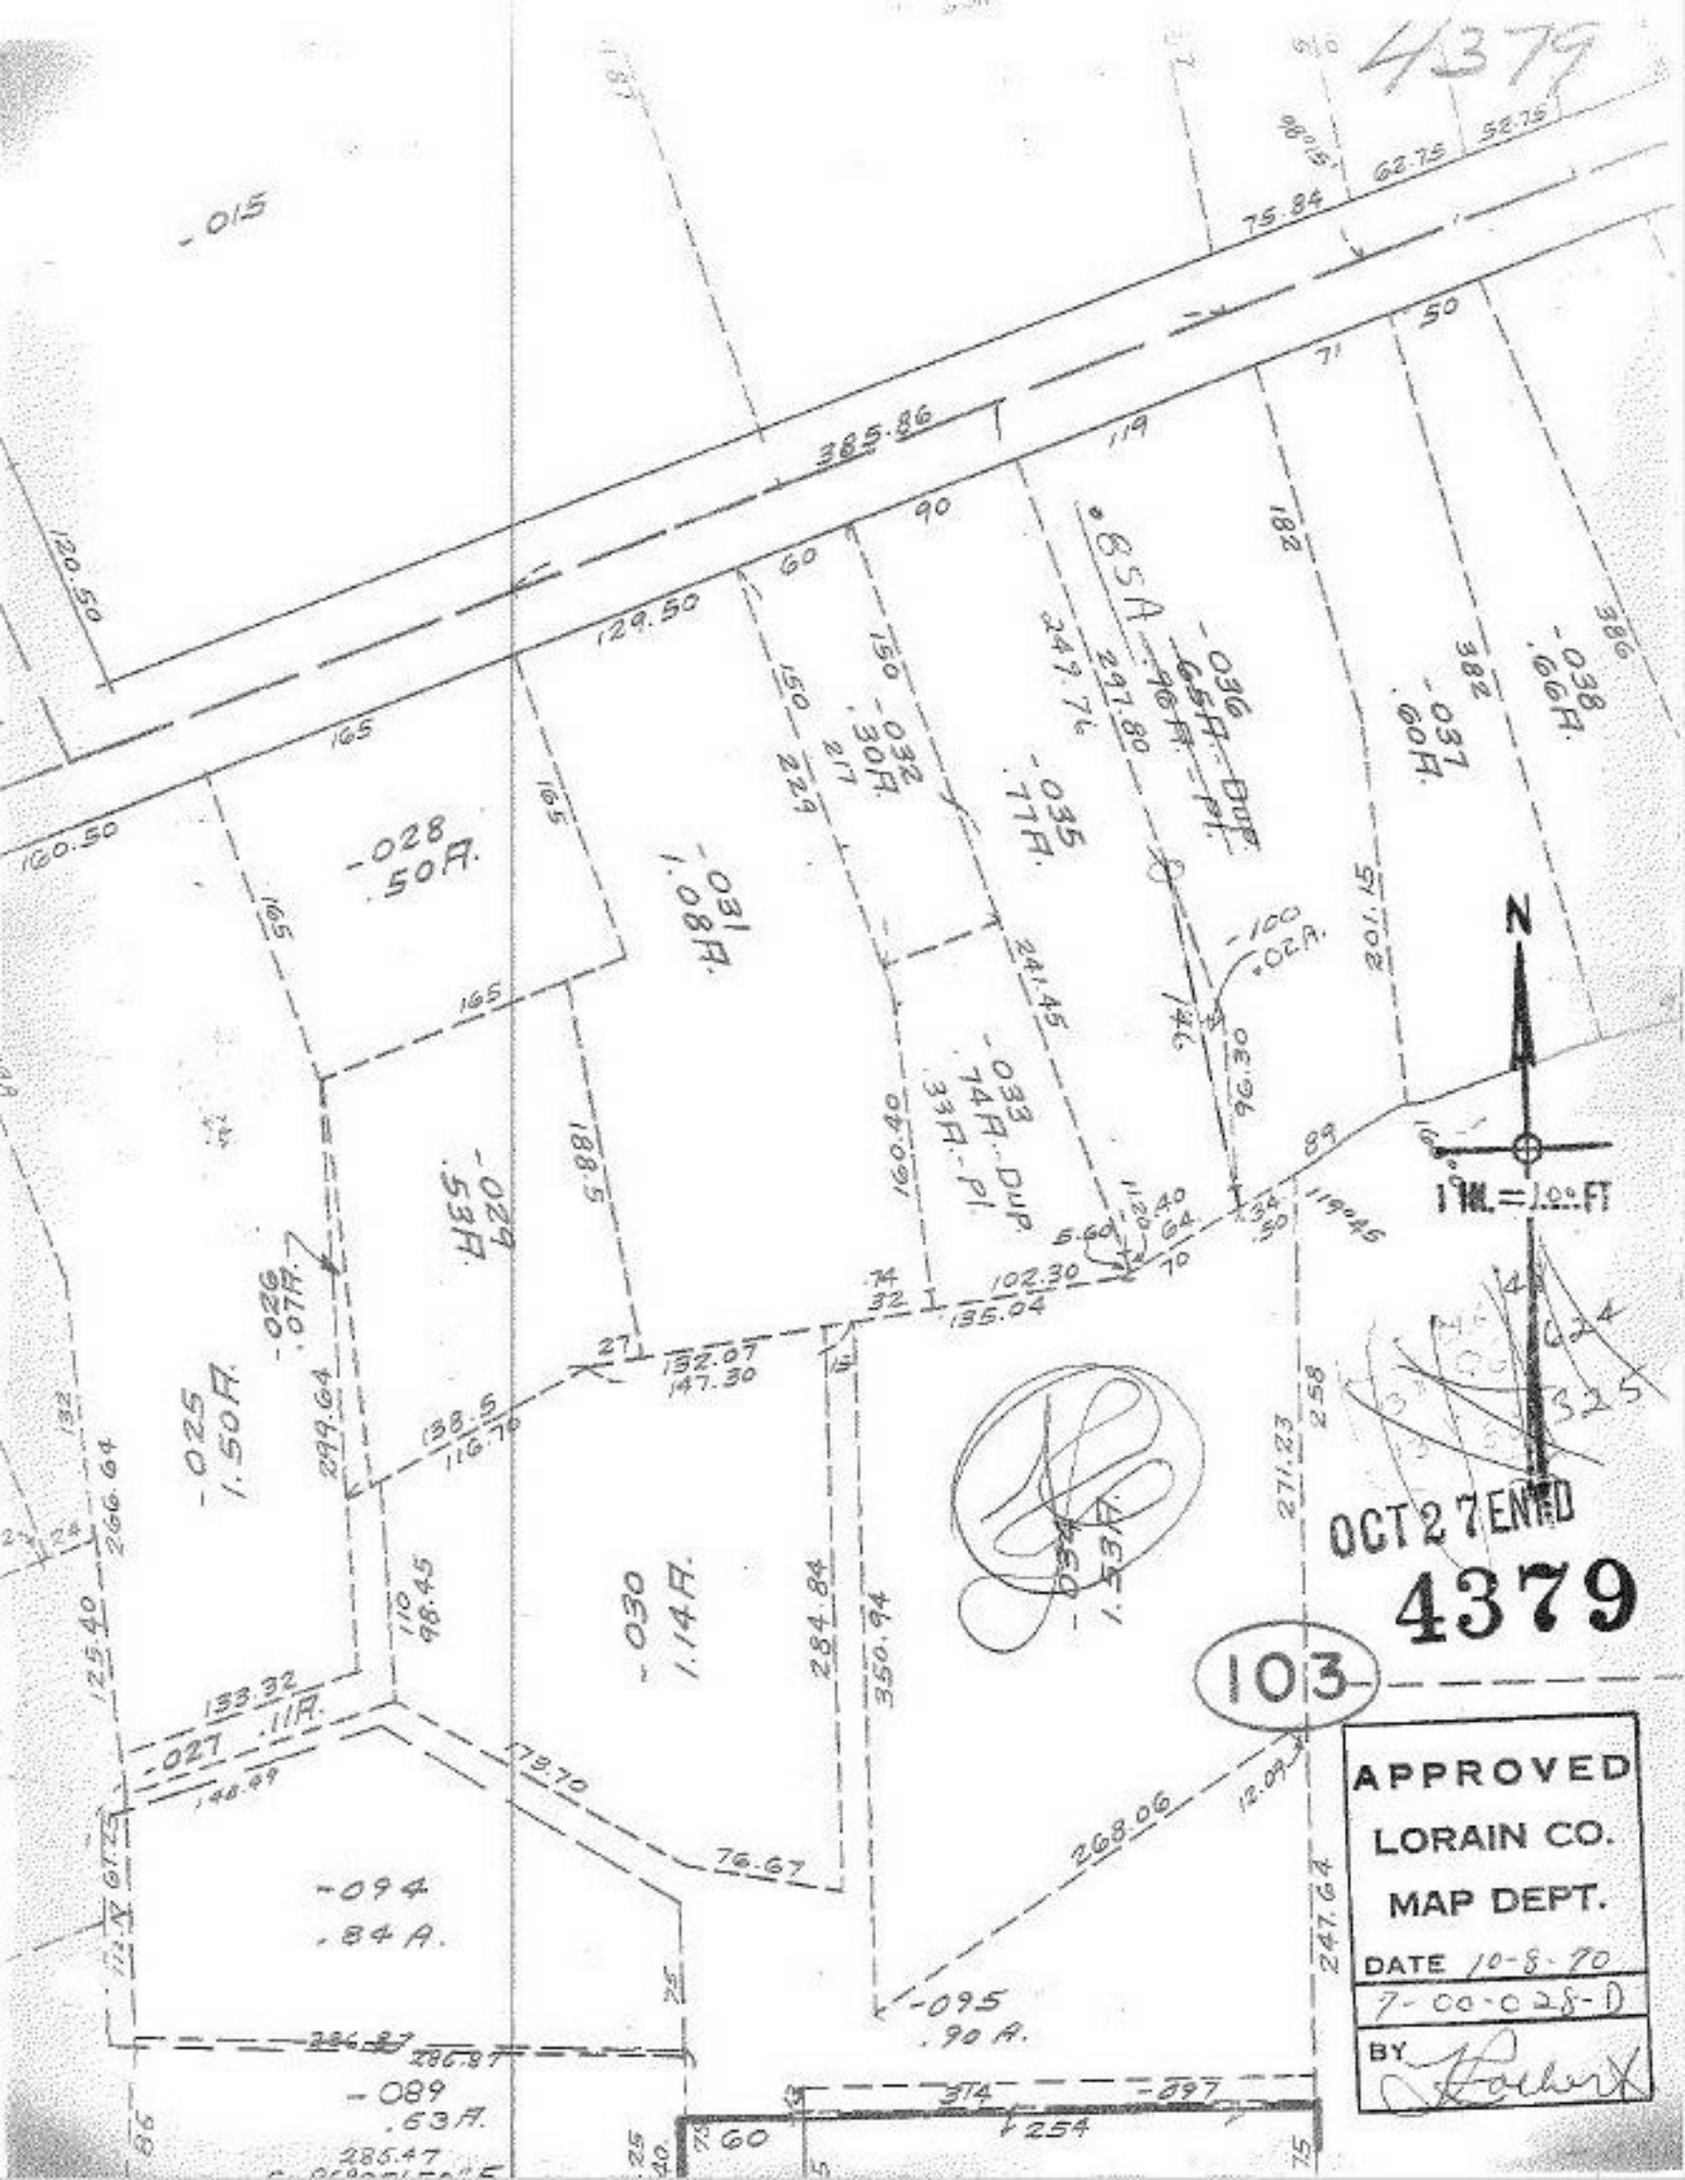
4379
-015
385.86
129.50
160.50
-028
.50A.
-031
1.08A.
-032
.30A.
-035
.77A.
-036
.65A.-Dup.
.96A.-Pl.
-037
.60A.
-038
.66A.
-033
.74A.-Dup.
.33A.-Pl.
-100
.02A.
-029
.53A.
-026
.07A.
-025
1.50A.
-030
1.14A.
-034
1.53A.
-027
.11A.
-094
.84A.
-095
.90A.
-089
.63A.
-097
N
1 IN. = 100 FT
OCT 27 ENTD
4379
103
APPROVED
LORAIN CO.
MAP DEPT.
DATE 10-8-70
7-00-028-D
BY