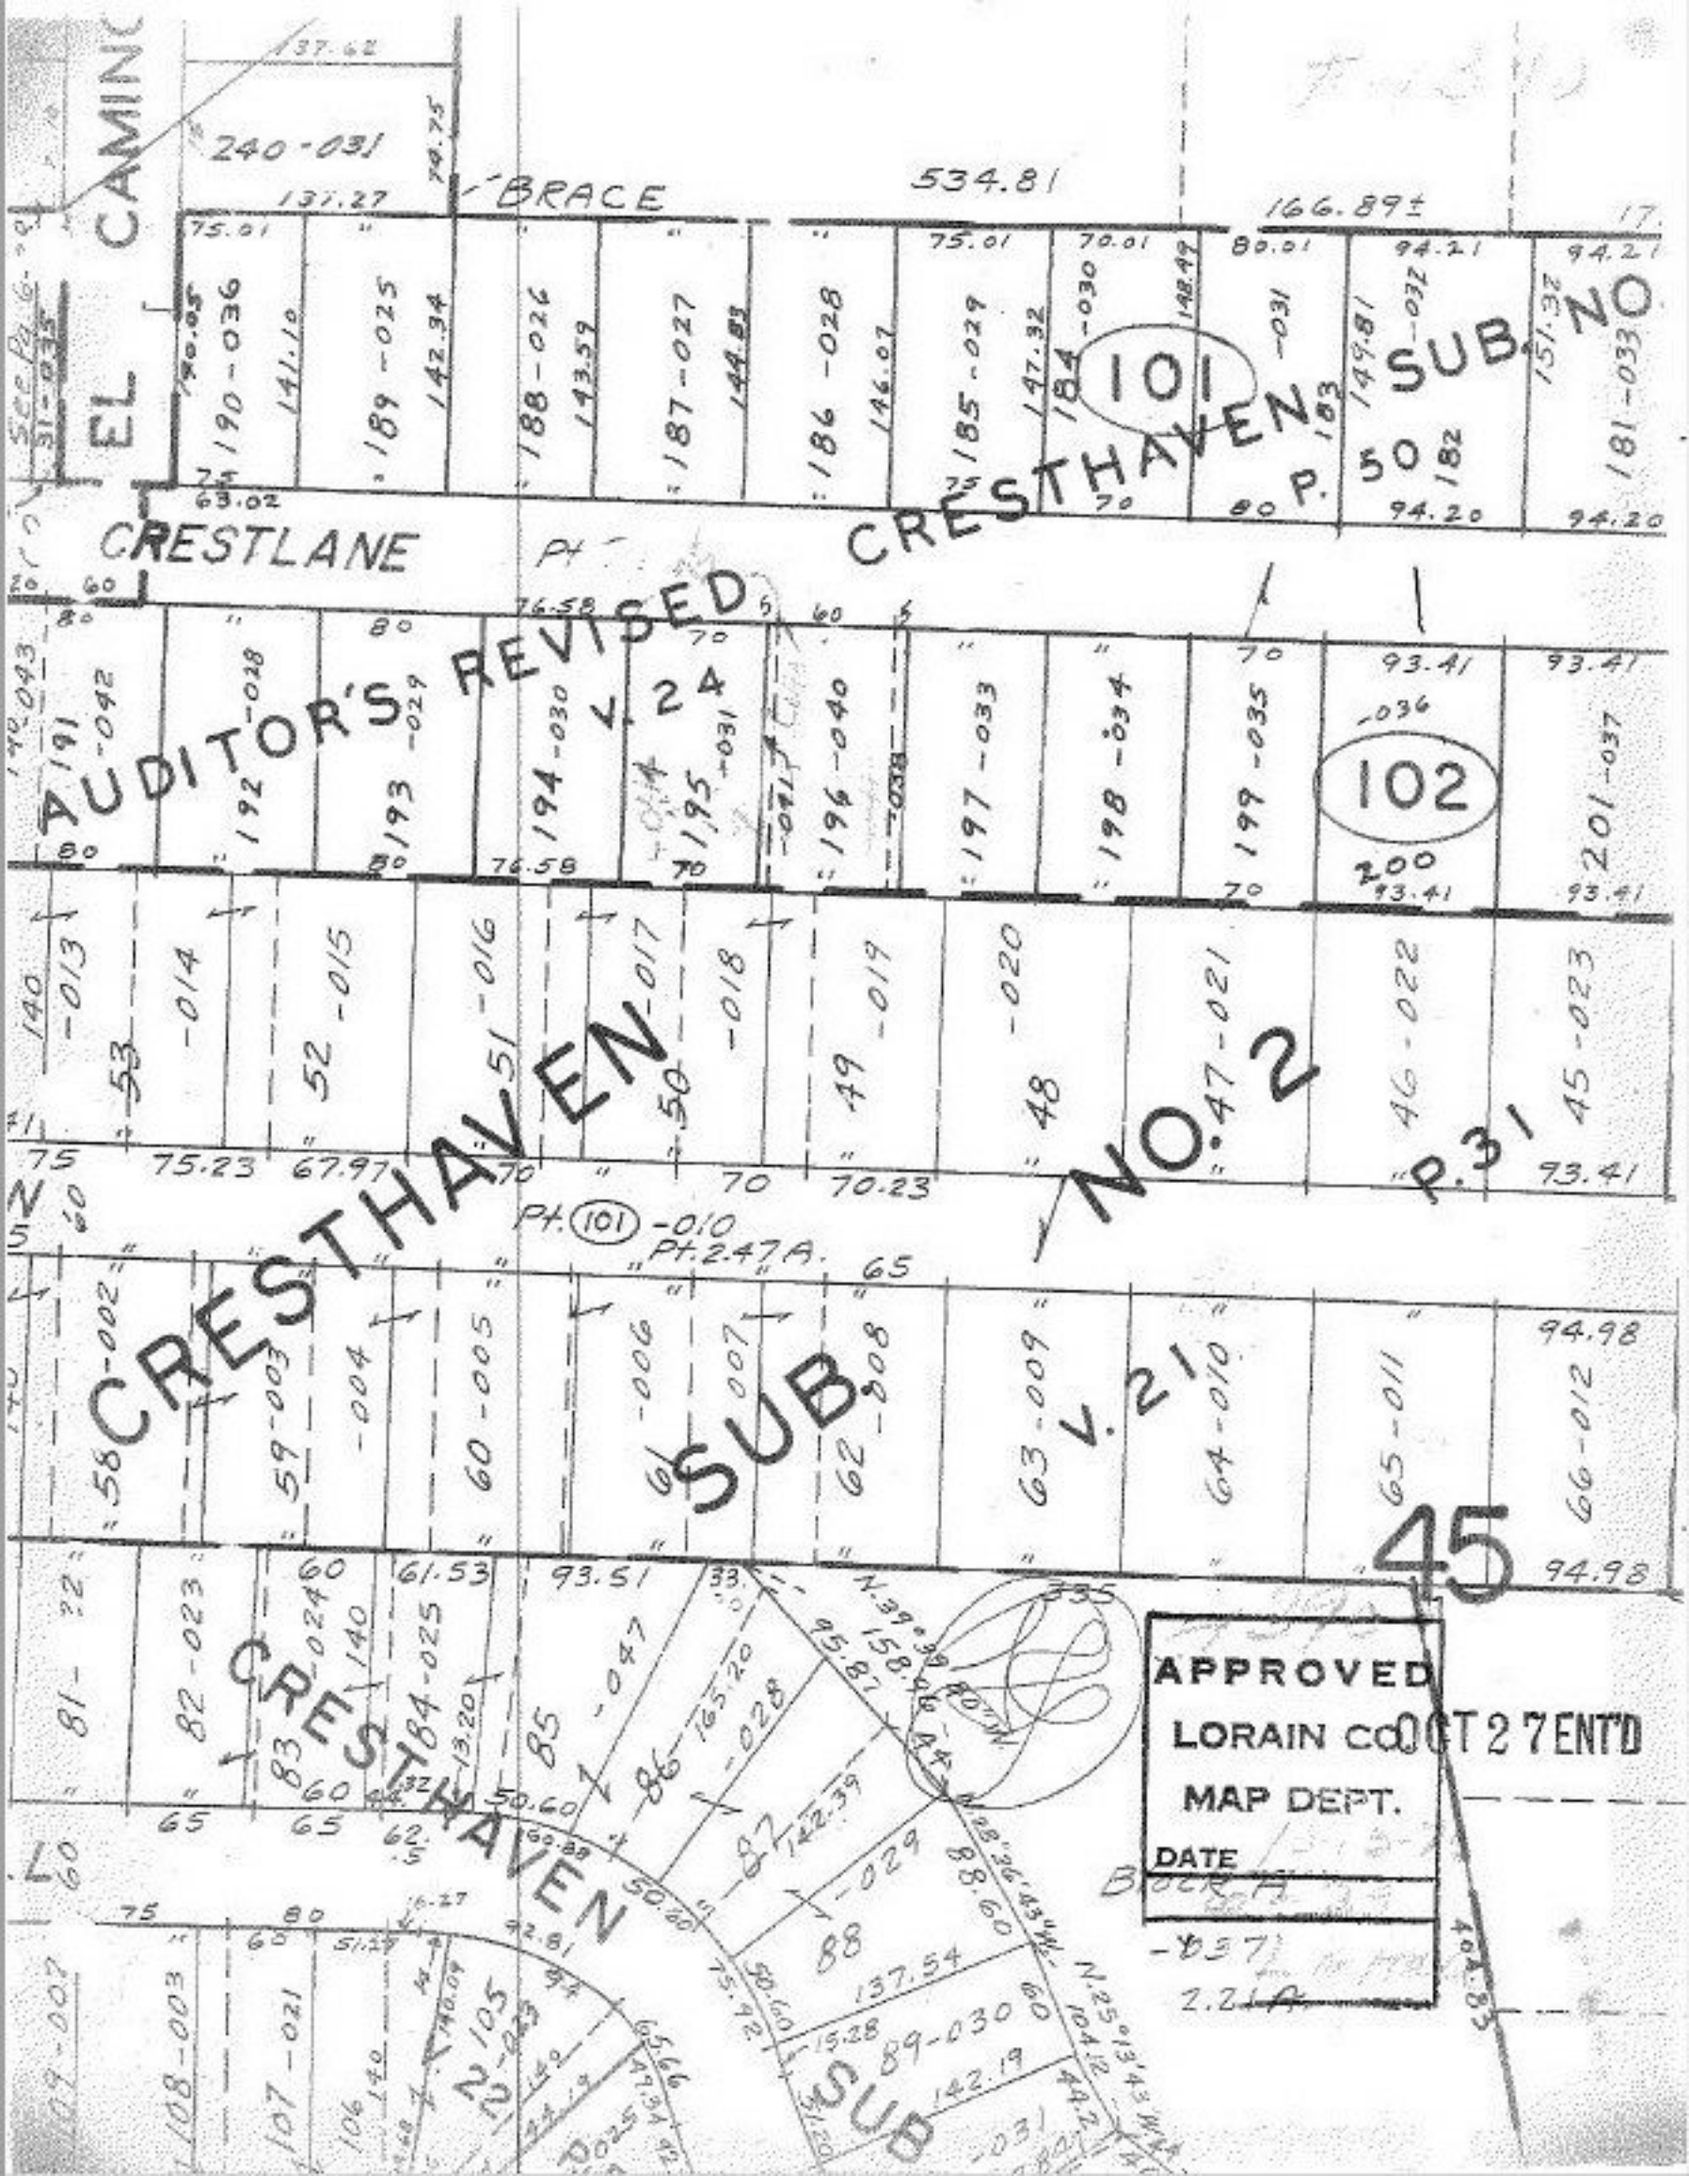
EL CAMINO
CRESTLANE
BRACE
CRESTHAVEN SUB NO. 2
AUDITOR'S REVISED
CRESTHAVEN SUB
CRESTHAVEN
534.81
166.89±
137.62
137.27
240-031
190-036
189-025
188-026
187-027
186-028
185-029
184-030
183-031
182
181-033
191-042
192-028
193-029
194-030
195-031
196-040
197-033
198-034
199-035
200
201-037
102
101
47-021
46-022
45-023
58-002
59-003
60-005
61
62-008
63-009
64-010
65-011
66-012
45
82-023
84-025
85-047
86-028
87
88
89-030
APPROVED
LORAIN CO OCT 27 ENT'D
MAP DEPT.
DATE