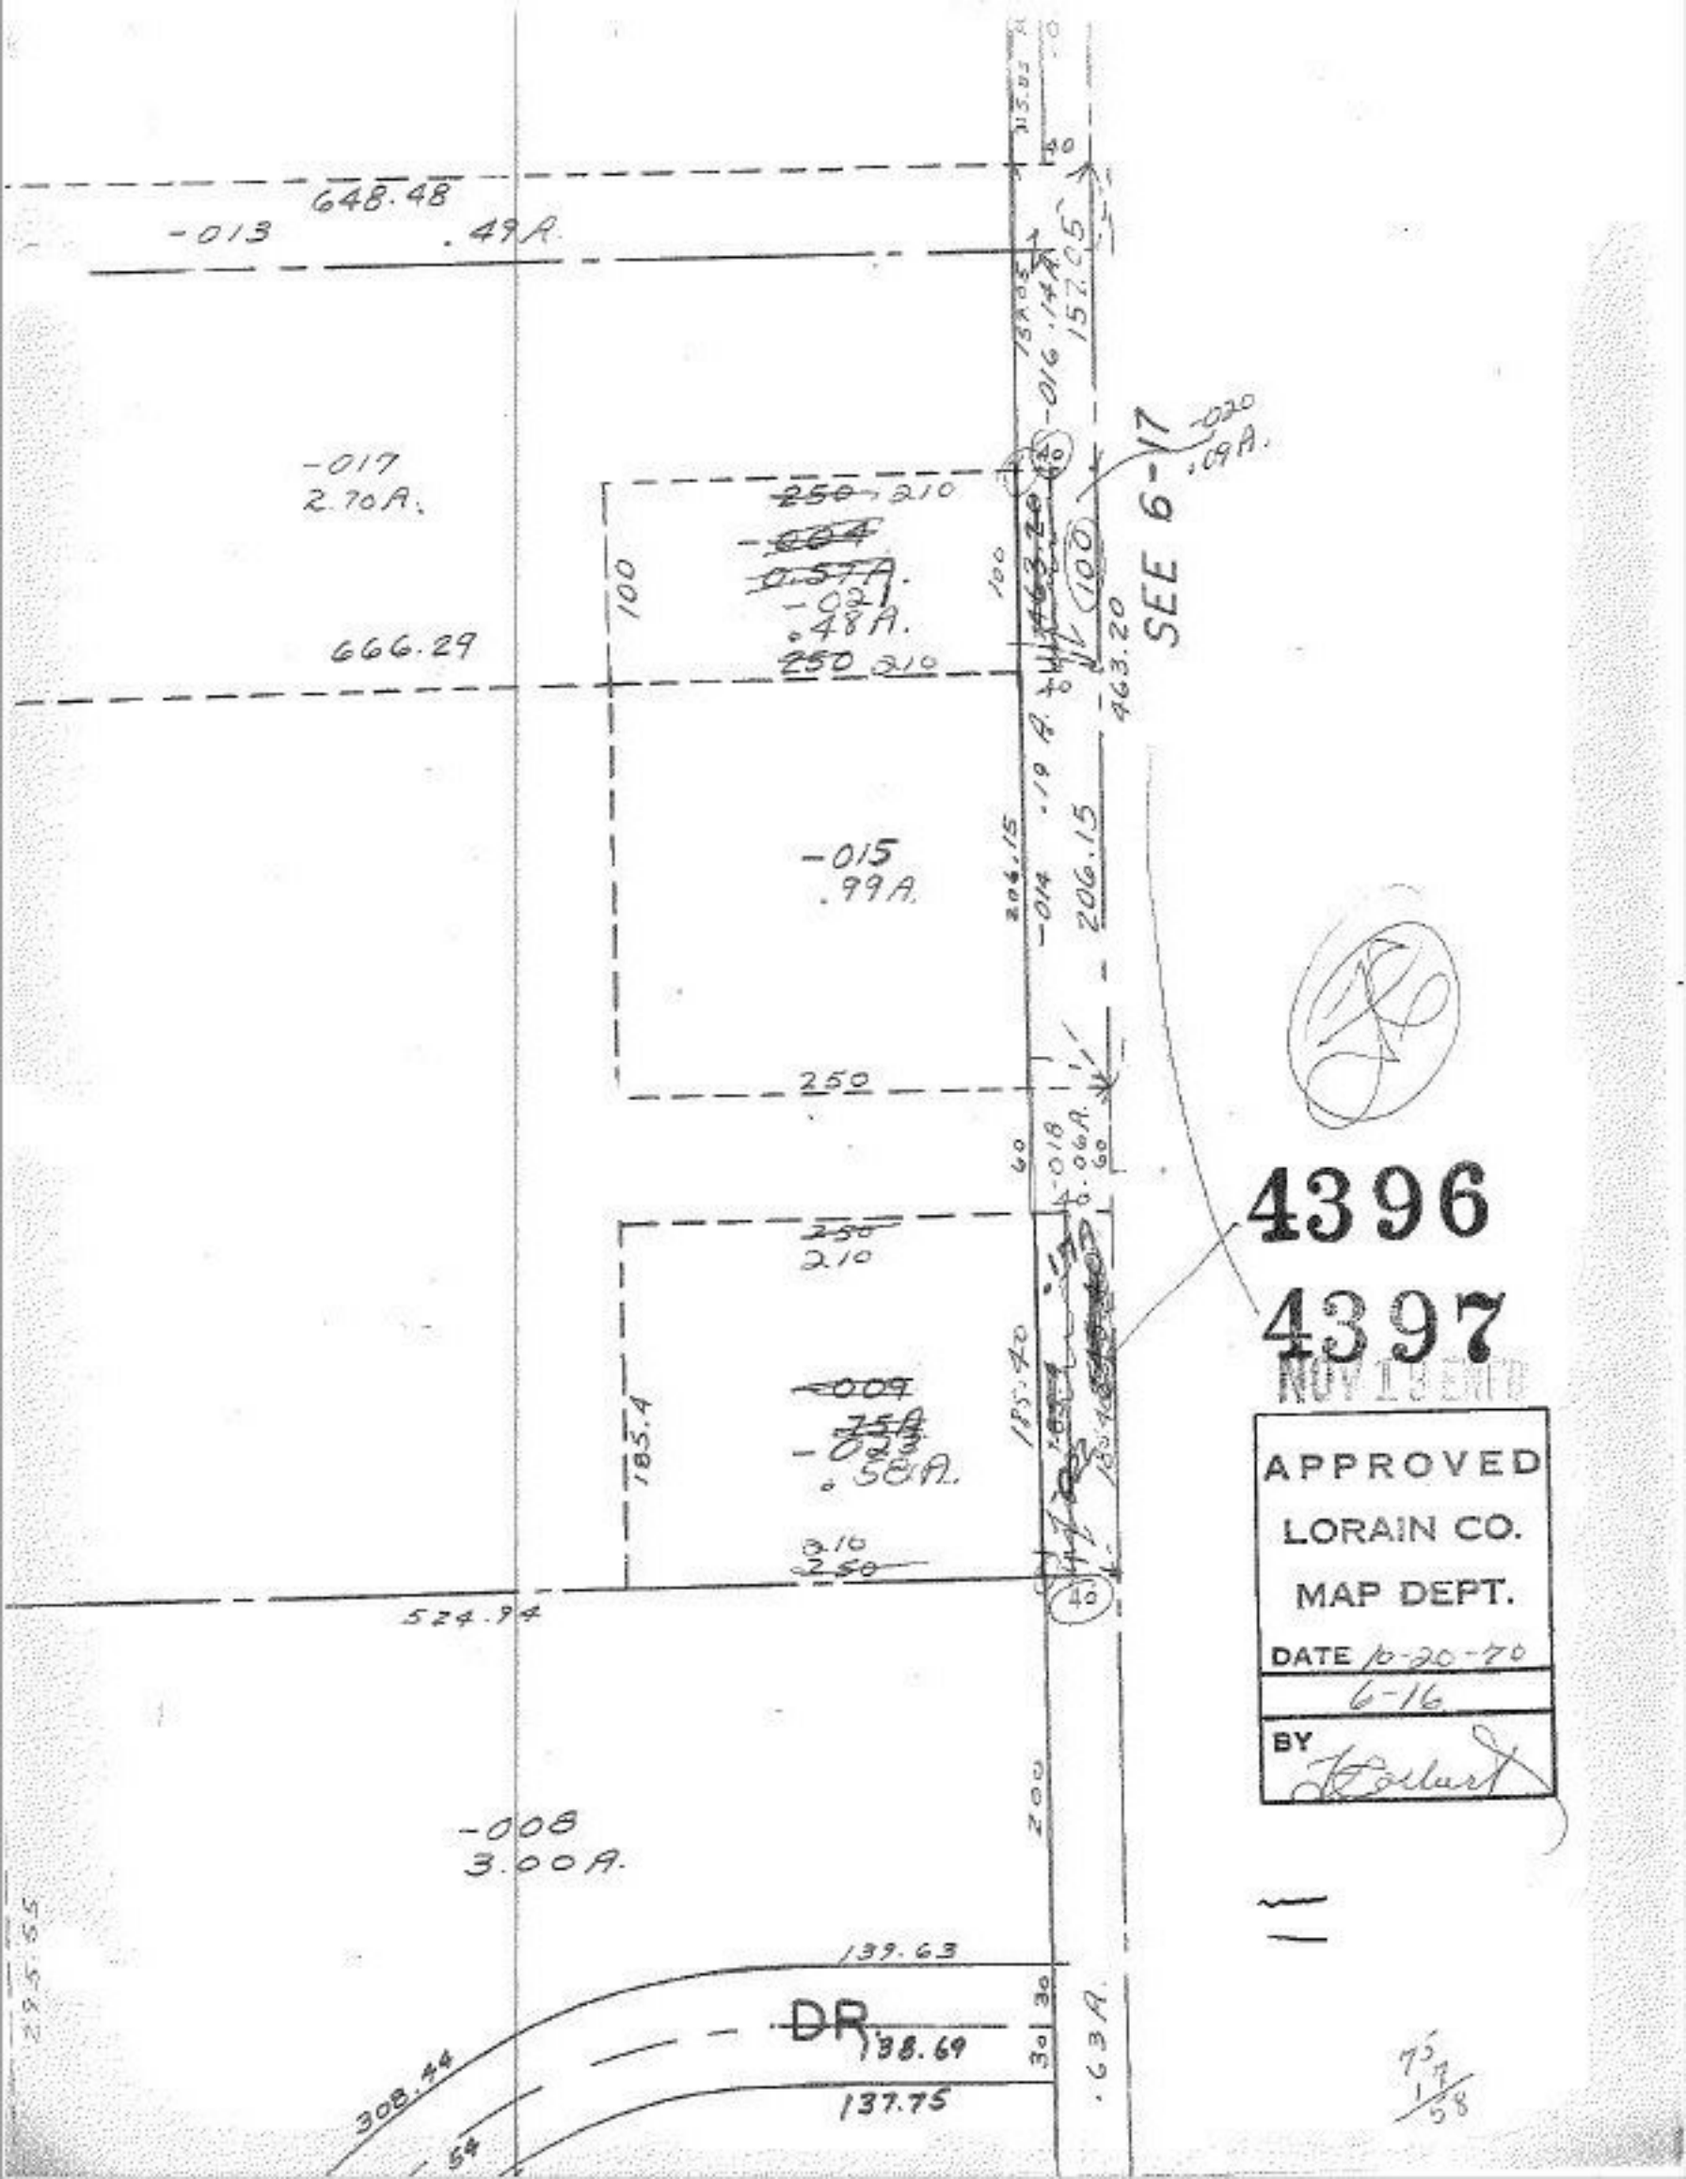
648.48
-013
.49A.
-017
2.70A.
666.29
250 210
-004
0.57A.
-021
.48A.
250 210
100
-015
.99A.
250
250
210
-009
.75A
-023
.58A.
185.4
210
250
524.94
-008
3.00A.
139.63
DR
138.69
137.75
308.44
.54
.63A.
-016 .14A.
157.05
-020
.09A.
SEE 6-17
463.20
206.15
-014
.19 A.
-018
.06A.
185.40
4396
4397
NOV 19 ENTD
APPROVED
LORAIN CO.
MAP DEPT.
DATE 10-20-70
6-16
BY