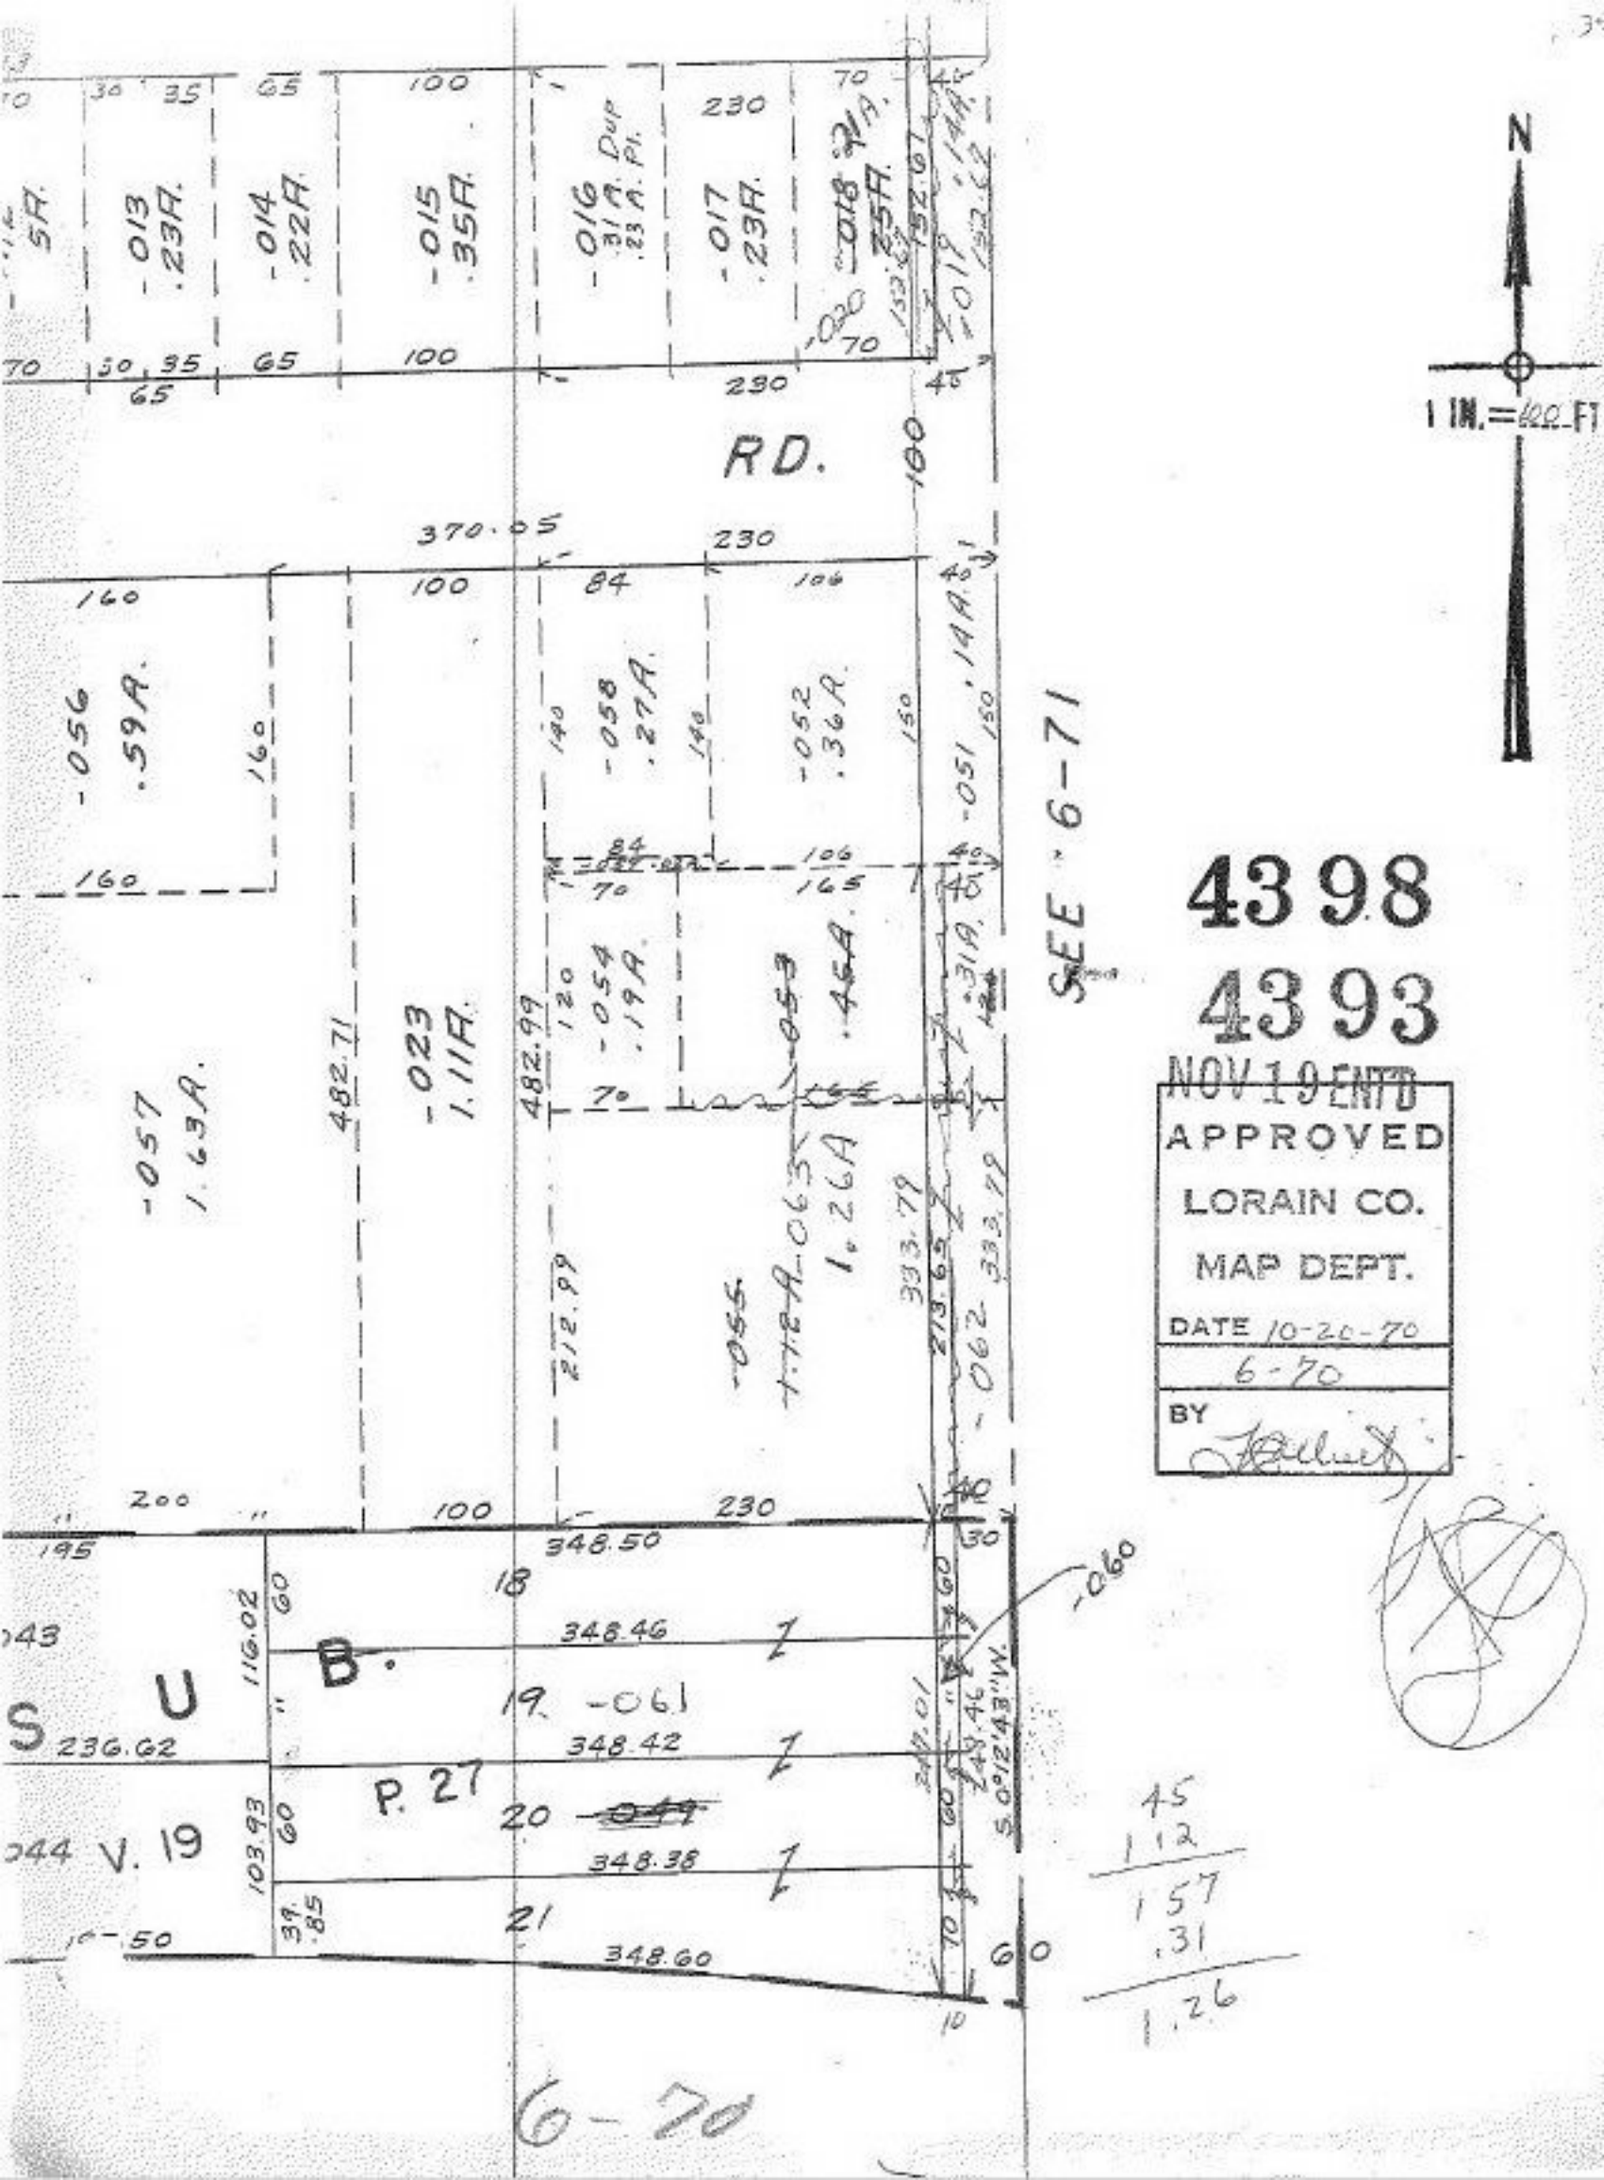

4398

4393

NOV 19 ENTD

APPROVED

LORAIN CO.

MAP DEPT.

DATE 10-20-70

6-70

BY

45
112
157
.31
1.26