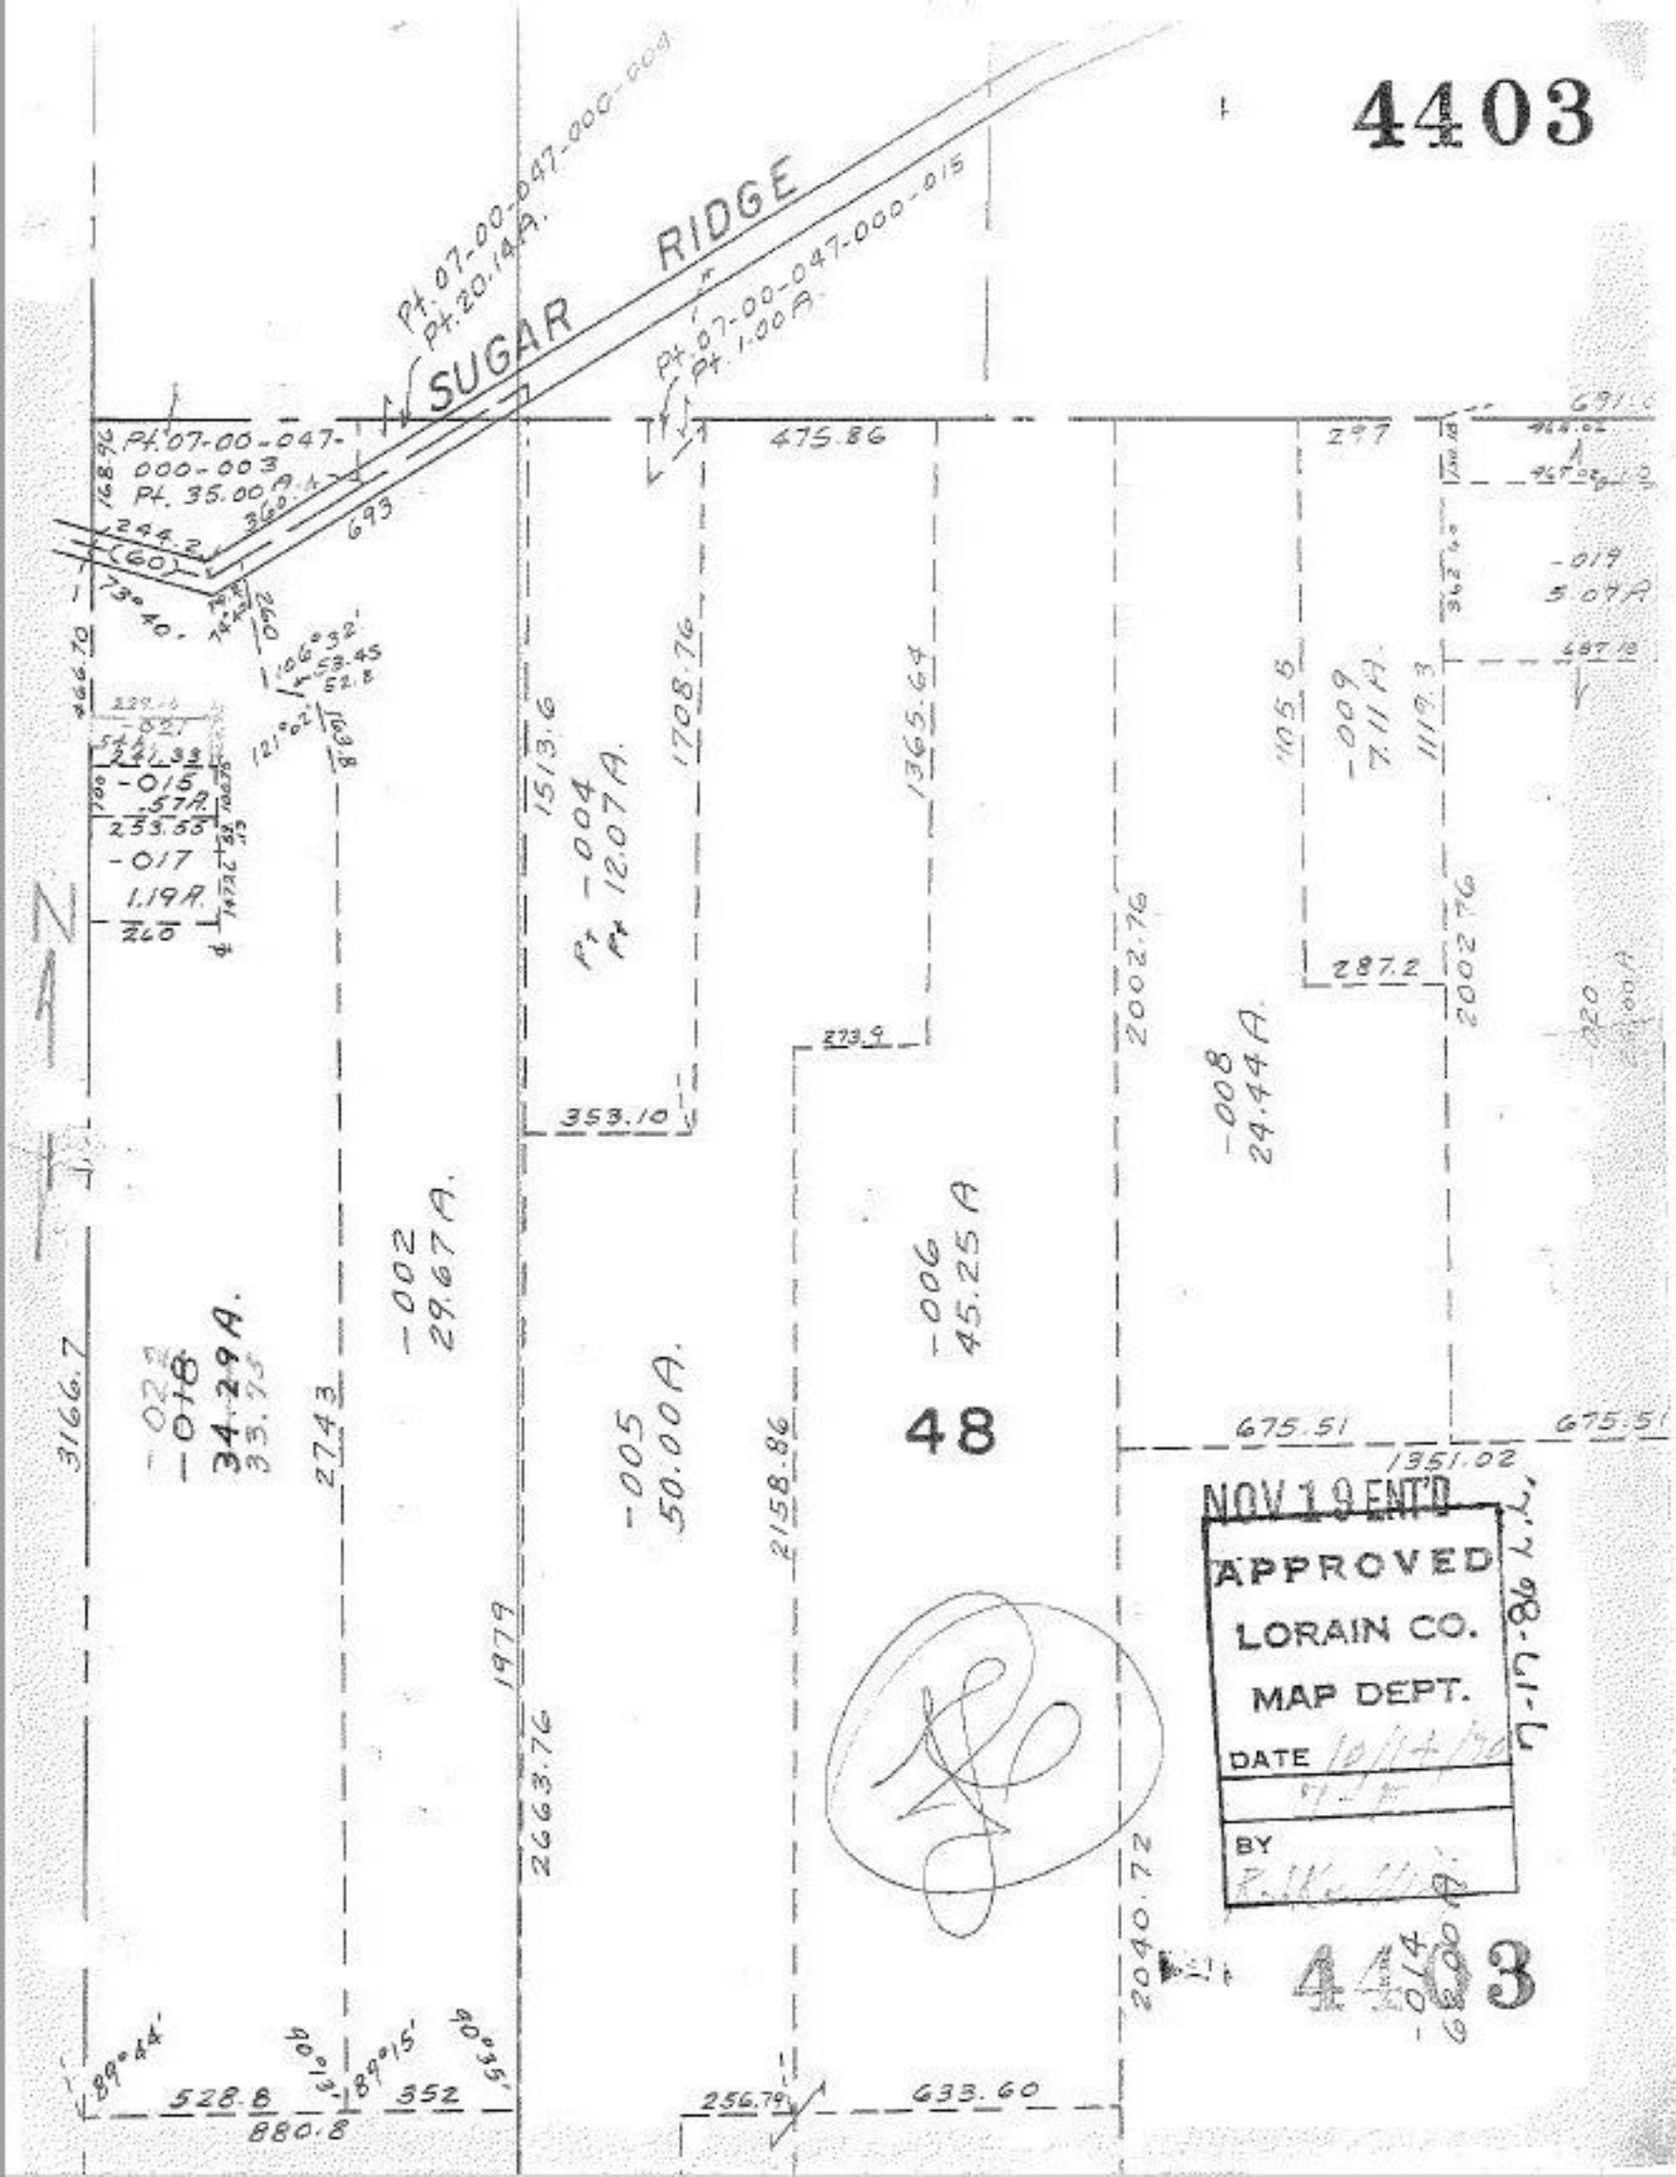
4403
SUGAR RIDGE
Pt. 07-00-047-000-004
Pt. 20.14 A.
Pt. 07-00-047-000-015
Pt. 1.00 A.
Pt. 07-00-047-000-003
Pt. 35.00 A.
475.86
297
-019
5.07 A
-015
.57 A.
-017
1.19 A.
-004
Pt. 12.07 A.
1513.6
1708.76
1365.64
-009
7.11 A.
1119.3
2002.76
287.2
-008
24.44 A.
273.9
353.10
-002
29.67 A.
-006
45.25 A
-005
50.00 A.
48
3166.7
-018
34.29 A.
2743
2158.86
675.51
1351.02
1979
2663.76
2040.72
528.8
352
880.8
256.79
633.60
NOV 19 ENT'D
APPROVED
LORAIN CO.
MAP DEPT.
DATE
BY
4403