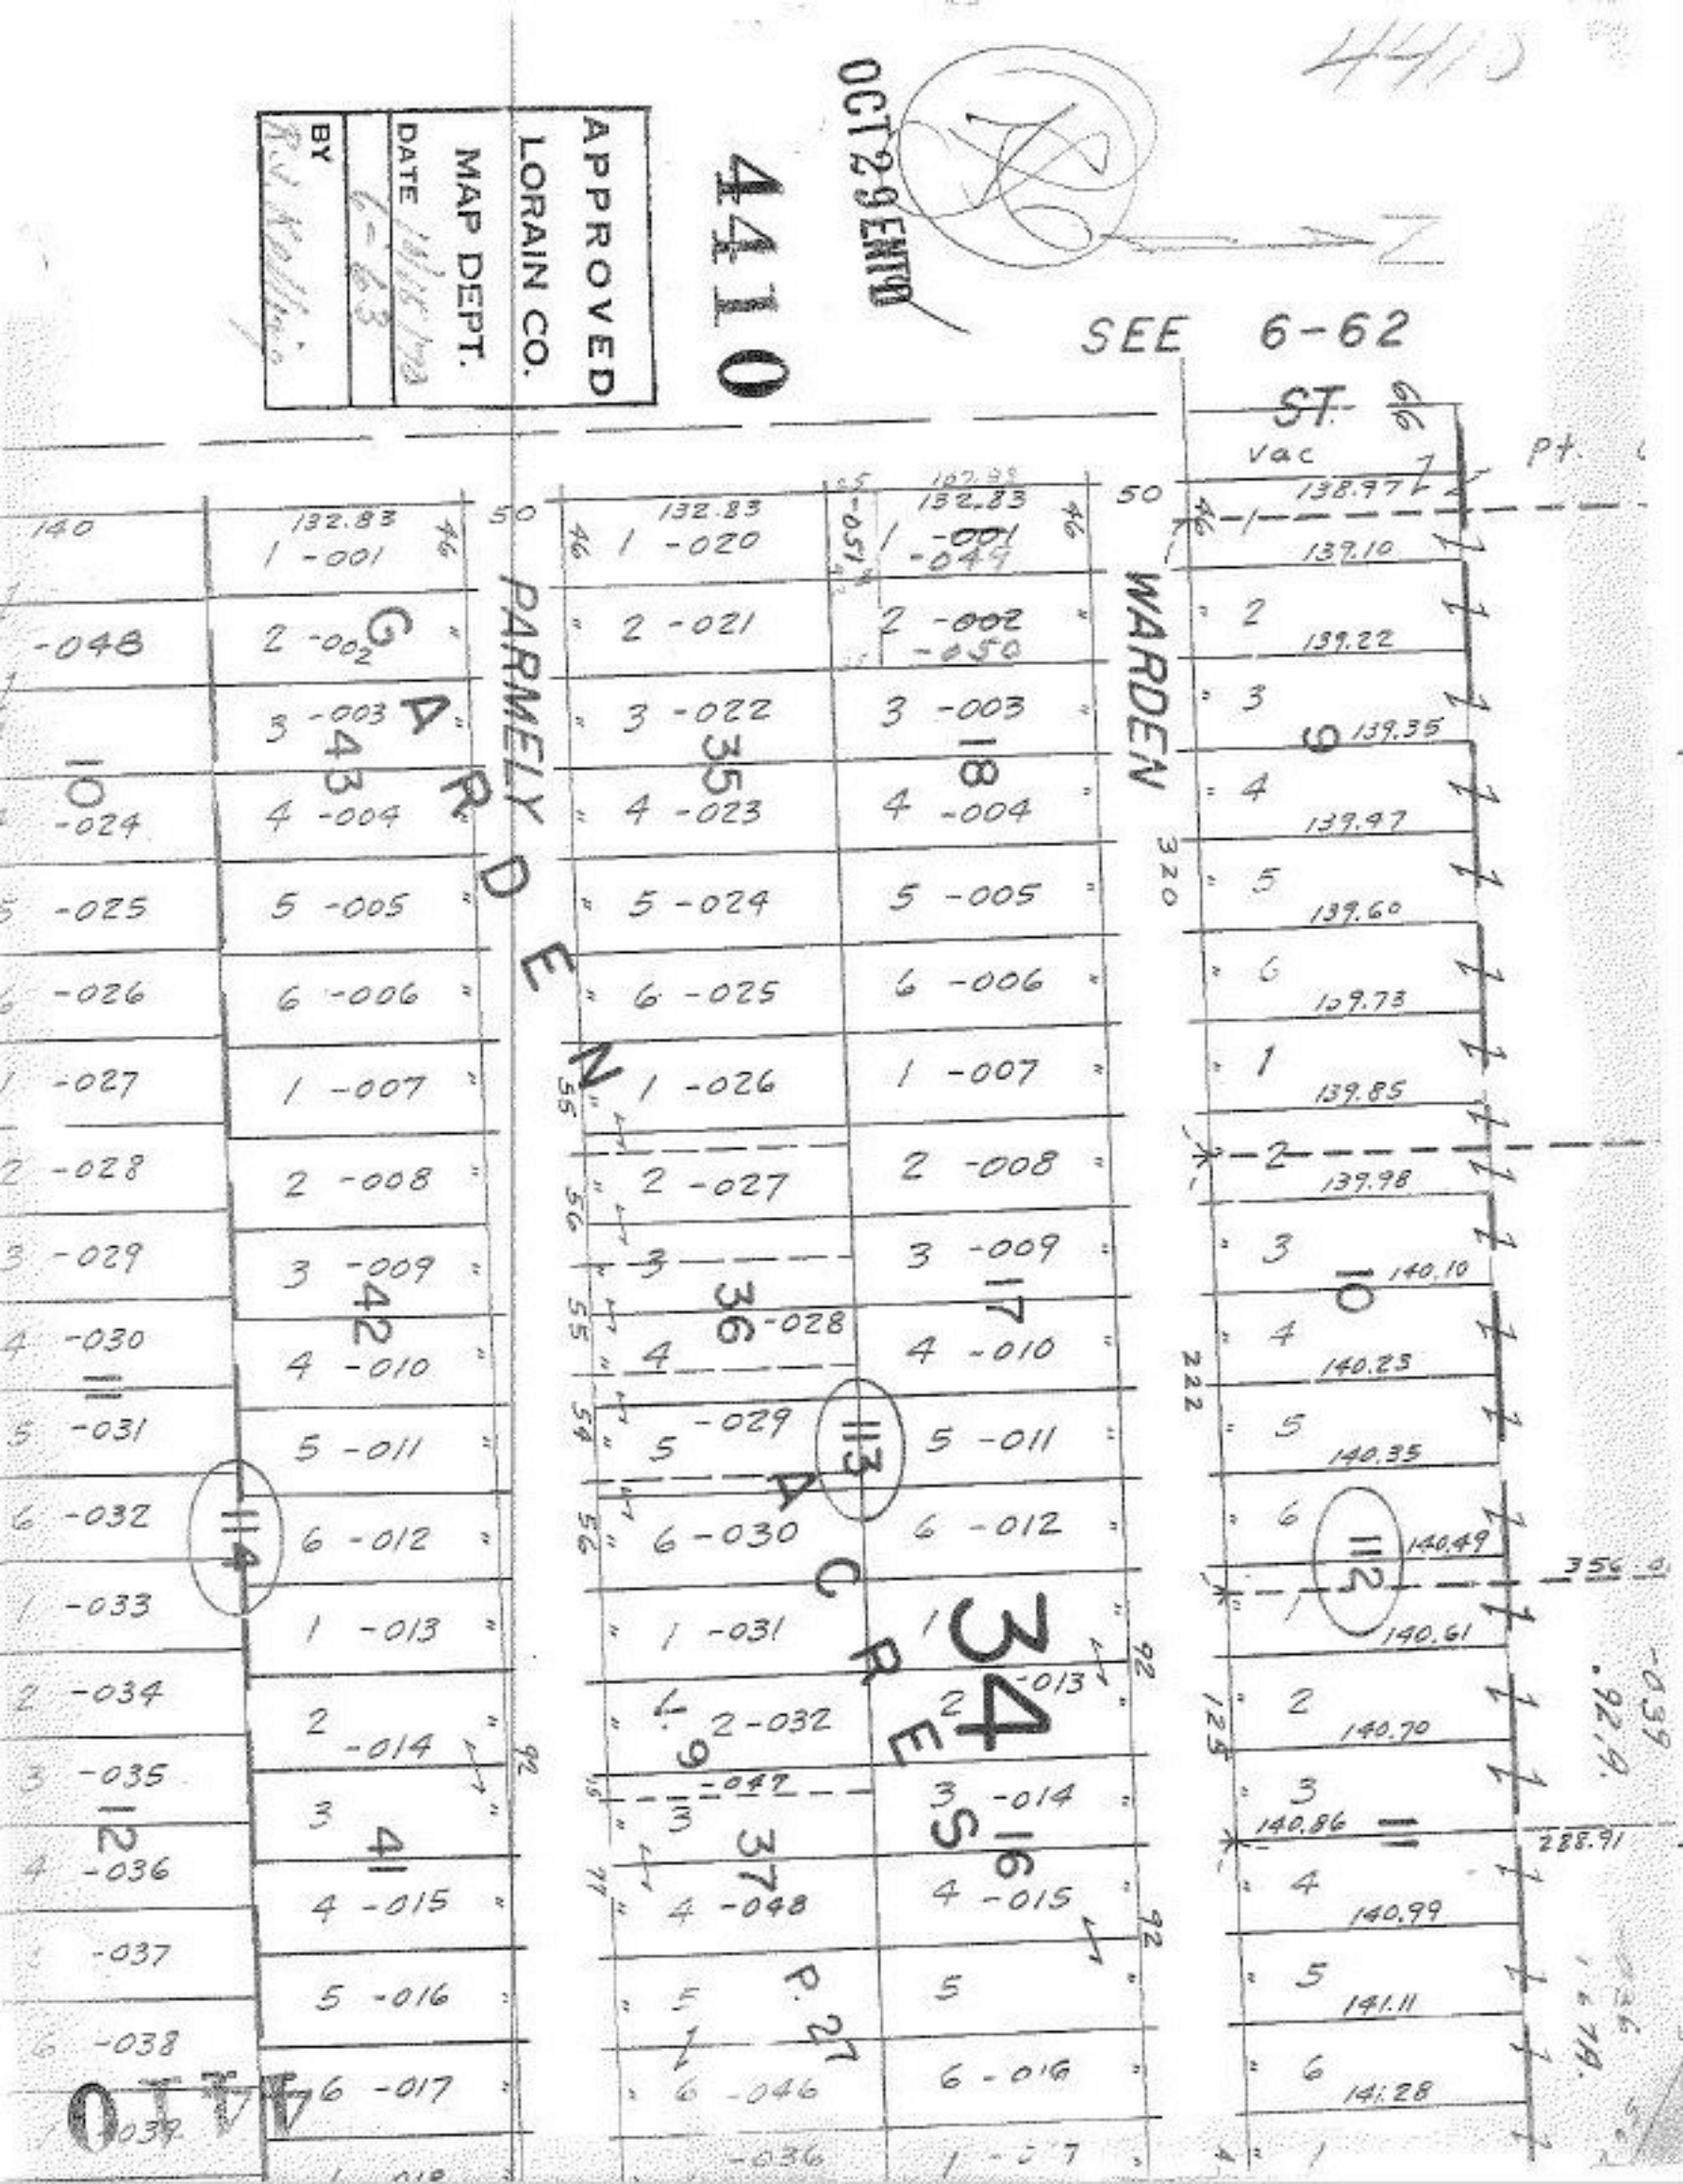
APPROVED
LORAIN CO.
MAP DEPT.
DATE 10/25/63
6-63
BY R.V. Kelly
OCT 29 ENTD
4410
SEE 6-62
ST.
Vac
Pt.
PARMELY
WARDEN
140
-048
-024
-025
-026
-027
-028
-029
-030
-031
-032
-033
-034
-035
-036
-037
-038
-039
132.83
1-001
2-002
3-003
4-004
5-005
6-006
1-007
2-008
3-009
4-010
5-011
6-012
1-013
2-014
