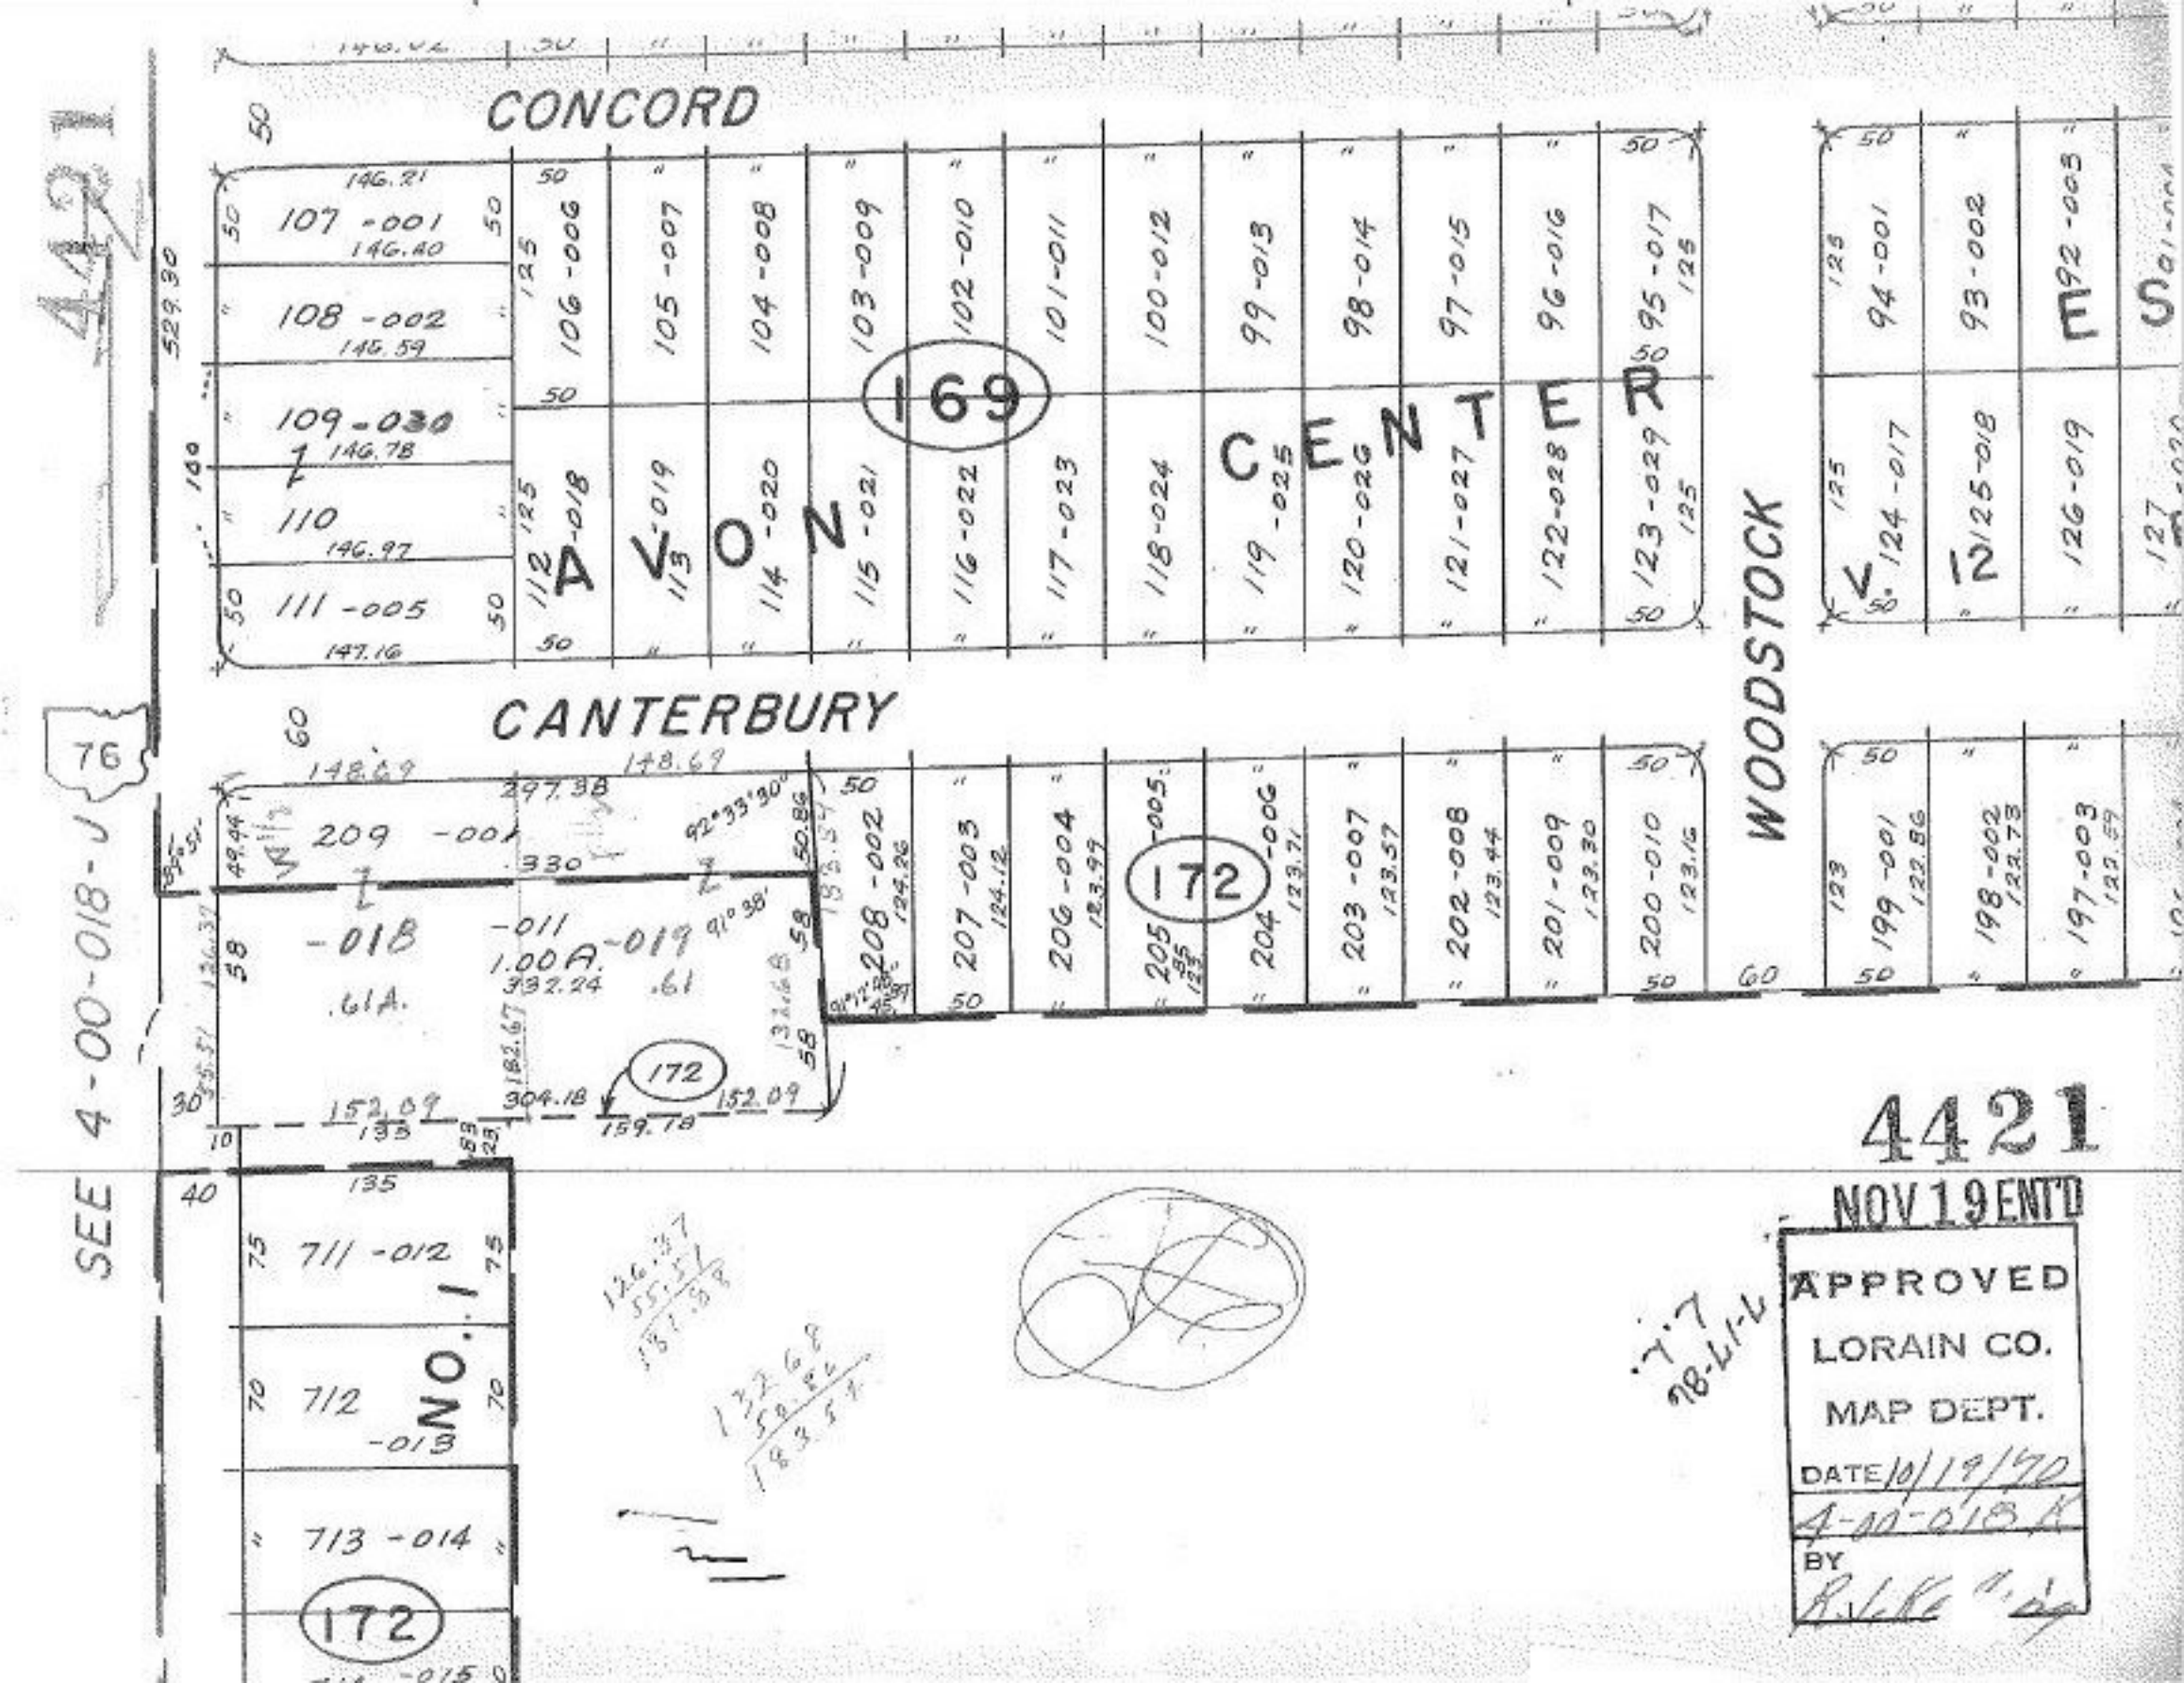

4421
CONCORD
CANTERBURY
WOODSTOCK
AVON CENTER
169
172
76
SEE 4-00-018-J
107-001
108-002
109-030
110
111-005
106-006
105-007
104-008
103-009
102-010
101-011
100-012
99-013
98-014
97-015
96-016
95-017
94-001
93-002
92-003
112-018
113-019
114-020
115-021
116-022
117-023
118-024
119-025
120-026
121-027
122-028
123-029
124-017
125-018
126-019
209-001
208-002
207-003
206-004
205-005
204-006
203-007
202-008
201-009
200-010
199-001
198-002
197-003
-018
-011
-019
1.00A.
.61A.
.61
711-012
712-013
713-014
NO. 1
4421
NOV 19 ENT'D
APPROVED
LORAIN CO.
MAP DEPT.
DATE 10/19/70
4-00-018 K
BY