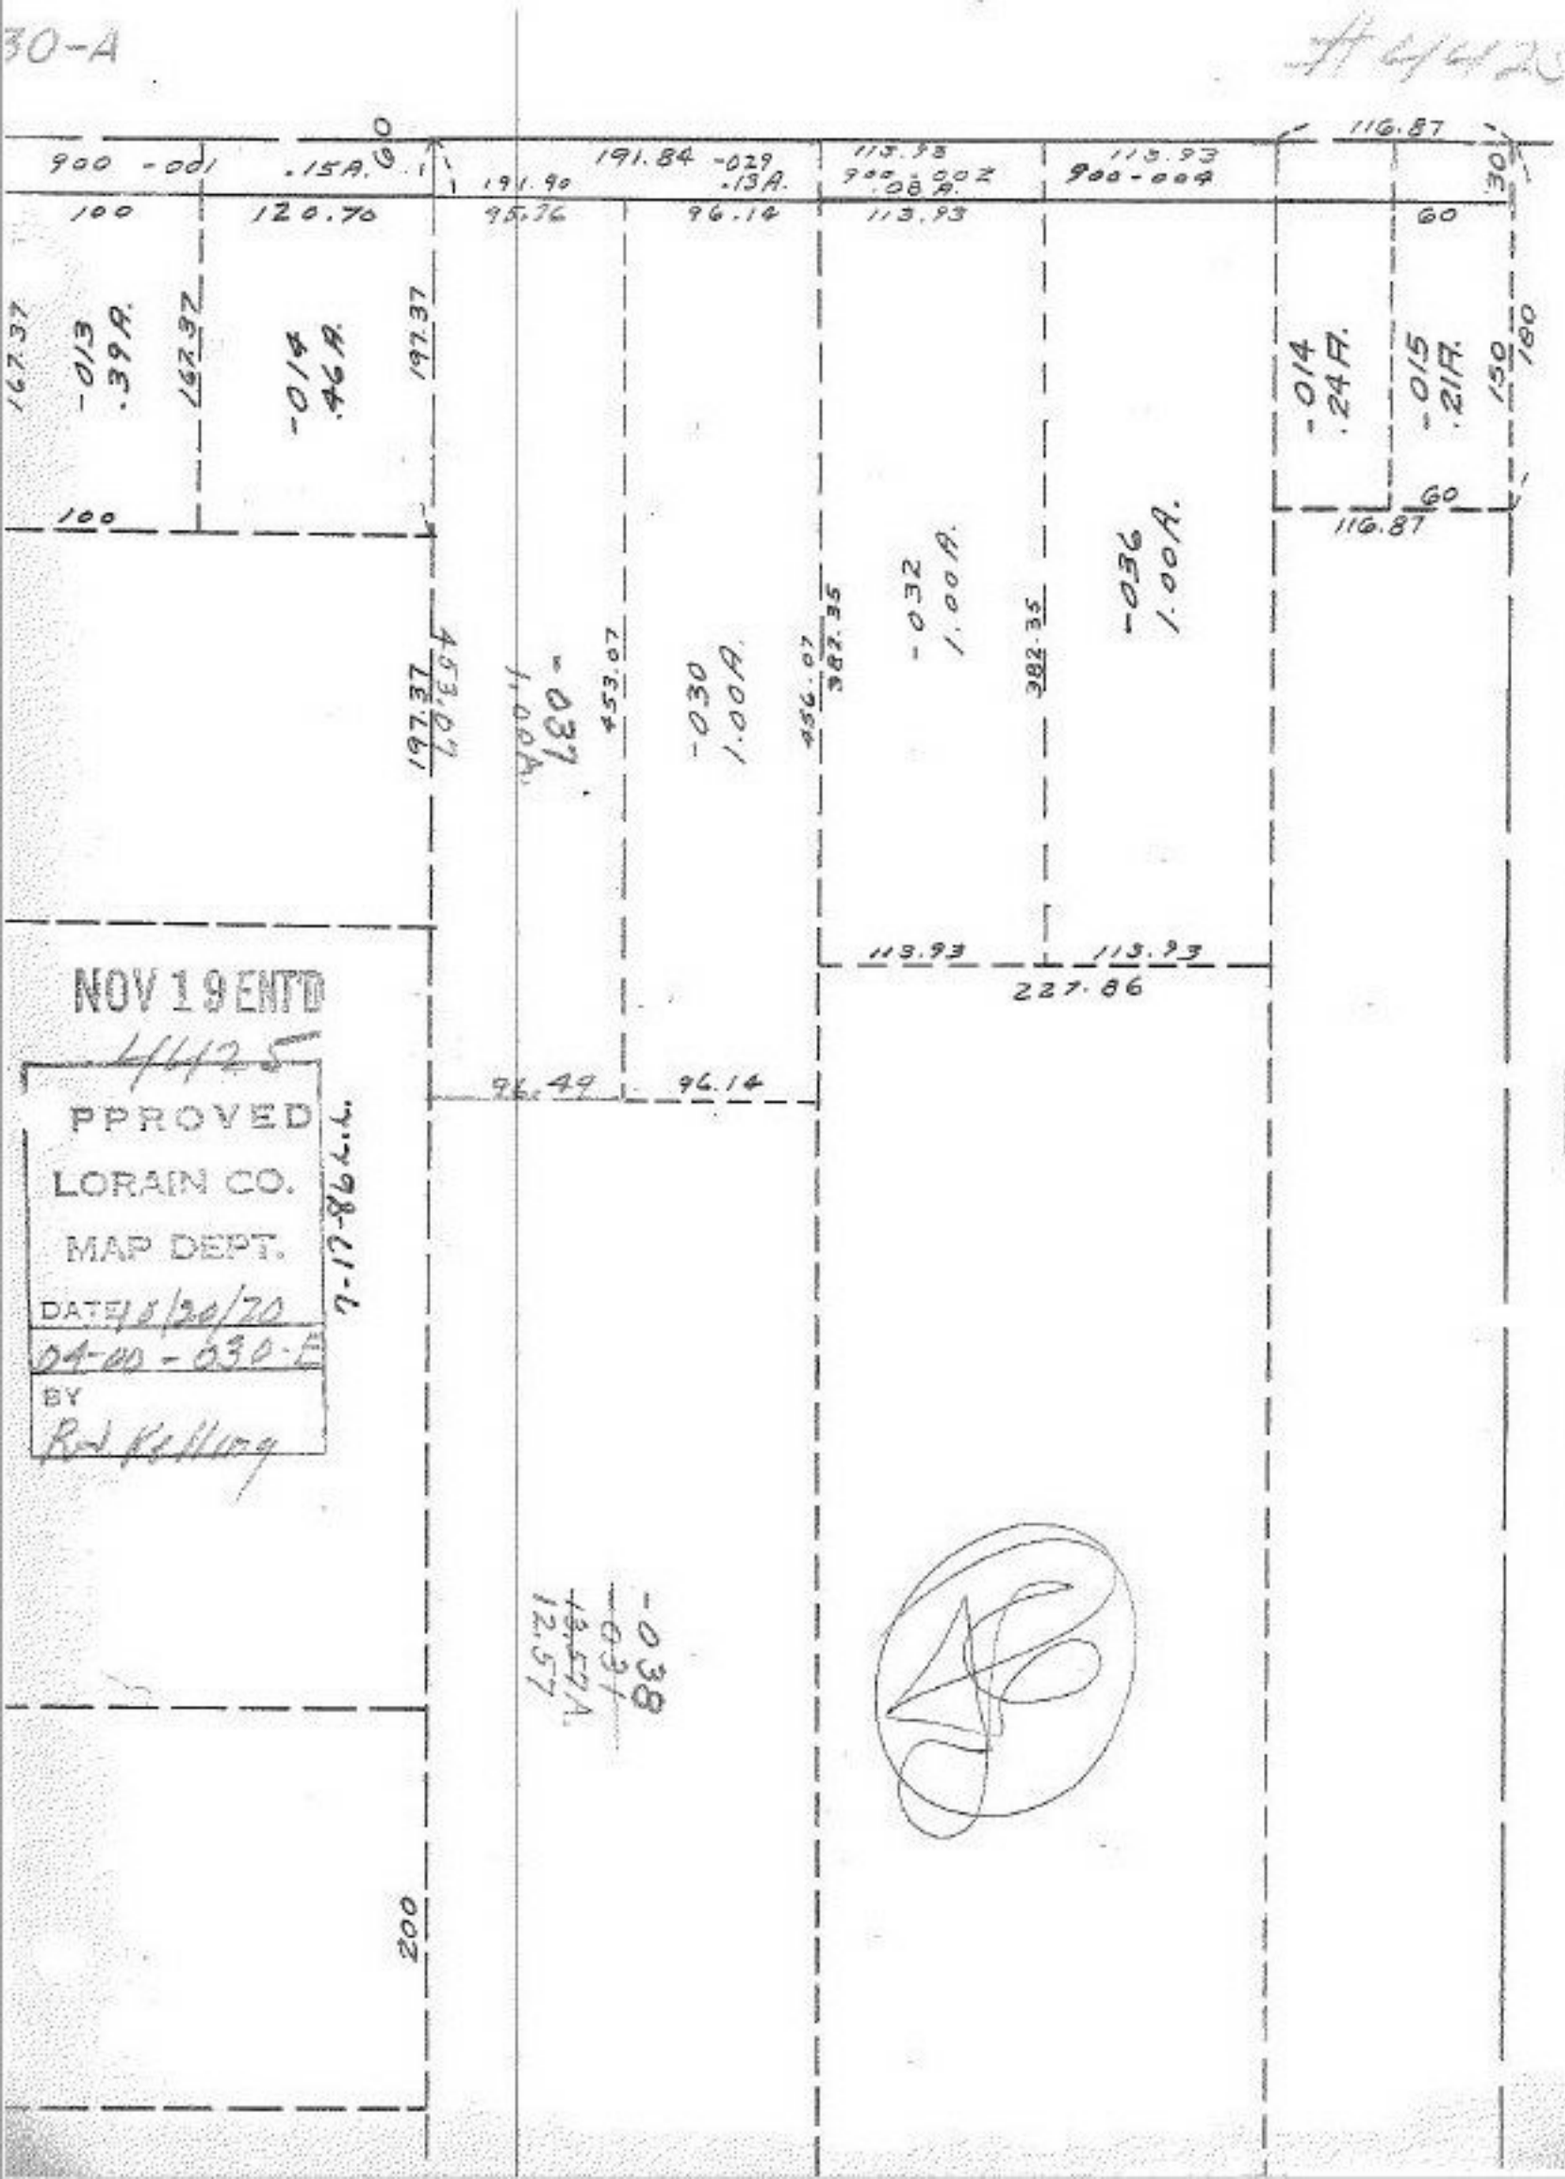
30-A
#4425
900 -001
.15A.
60
191.84 -029
.13A.
191.90
95.76
96.14
113.93
900-002
.08A.
113.93
900-004
116.87
30
100
120.70
113.93
60
167.37
-013
.39A.
167.37
-014
.46A.
197.37
-014
.24A.
-015
.21A.
150
180
100
60
116.87
197.37
453.07
-037
1.00A.
453.07
-030
1.00A.
456.07
382.35
-032
1.00A.
382.35
-036
1.00A.
113.93
113.93
227.86
96.49
96.14
-038
-031
12.57
200
NOV 19 ENT'D
4425
PPROVED
LORAIN CO.
MAP DEPT.
DATE 10/20/70
04-00-030-E
BY
7-17-86 L.L.