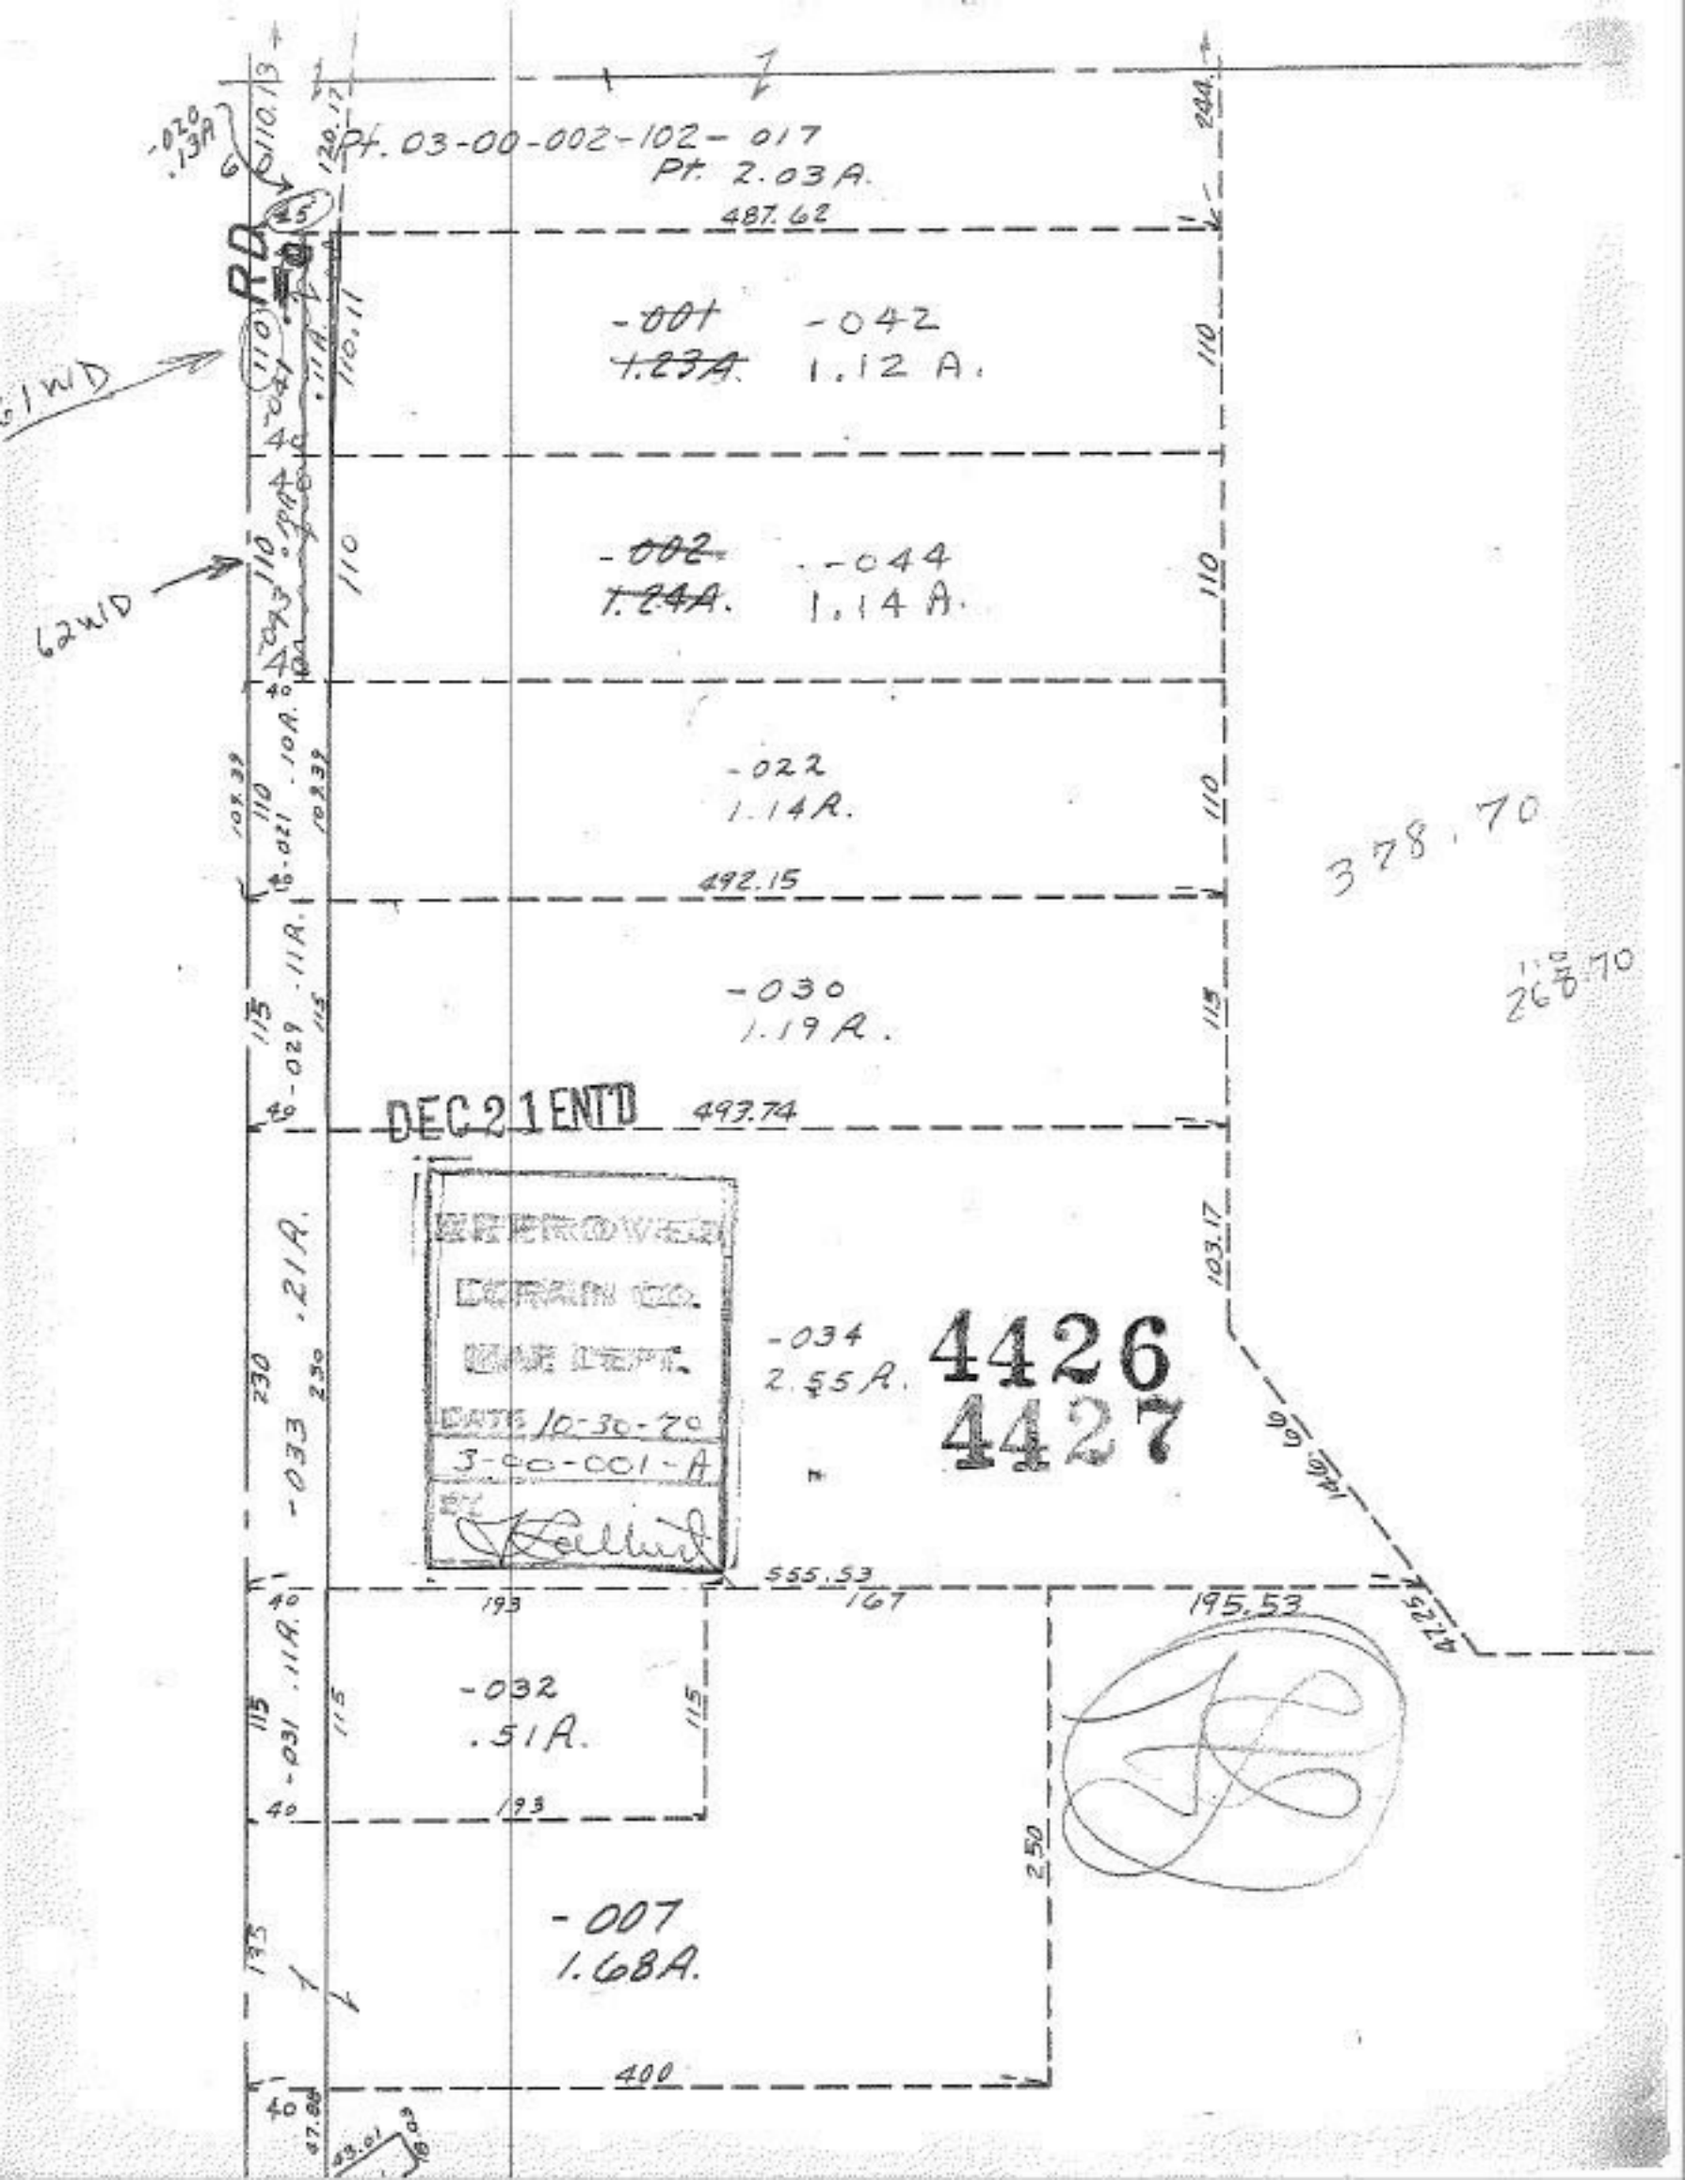

Pt. 03-00-002-102-017
Pt. 2.03 A.
487.62
RD
-001
1.23A.
-042
1.12 A.
-002
1.24A.
-044
1.14 A.
-022
1.14A.
492.15
-030
1.19 A.
493.74
DEC 21 ENT'D
APPROVED
MAP DEPT.
DATE 10-30-70
3-00-001-A
BY
-034
2.55 A.
4426
4427
555.53
195.53
-032
.51A.
-007
1.68A.
400
378.70
268.70
61 WD
62 WD