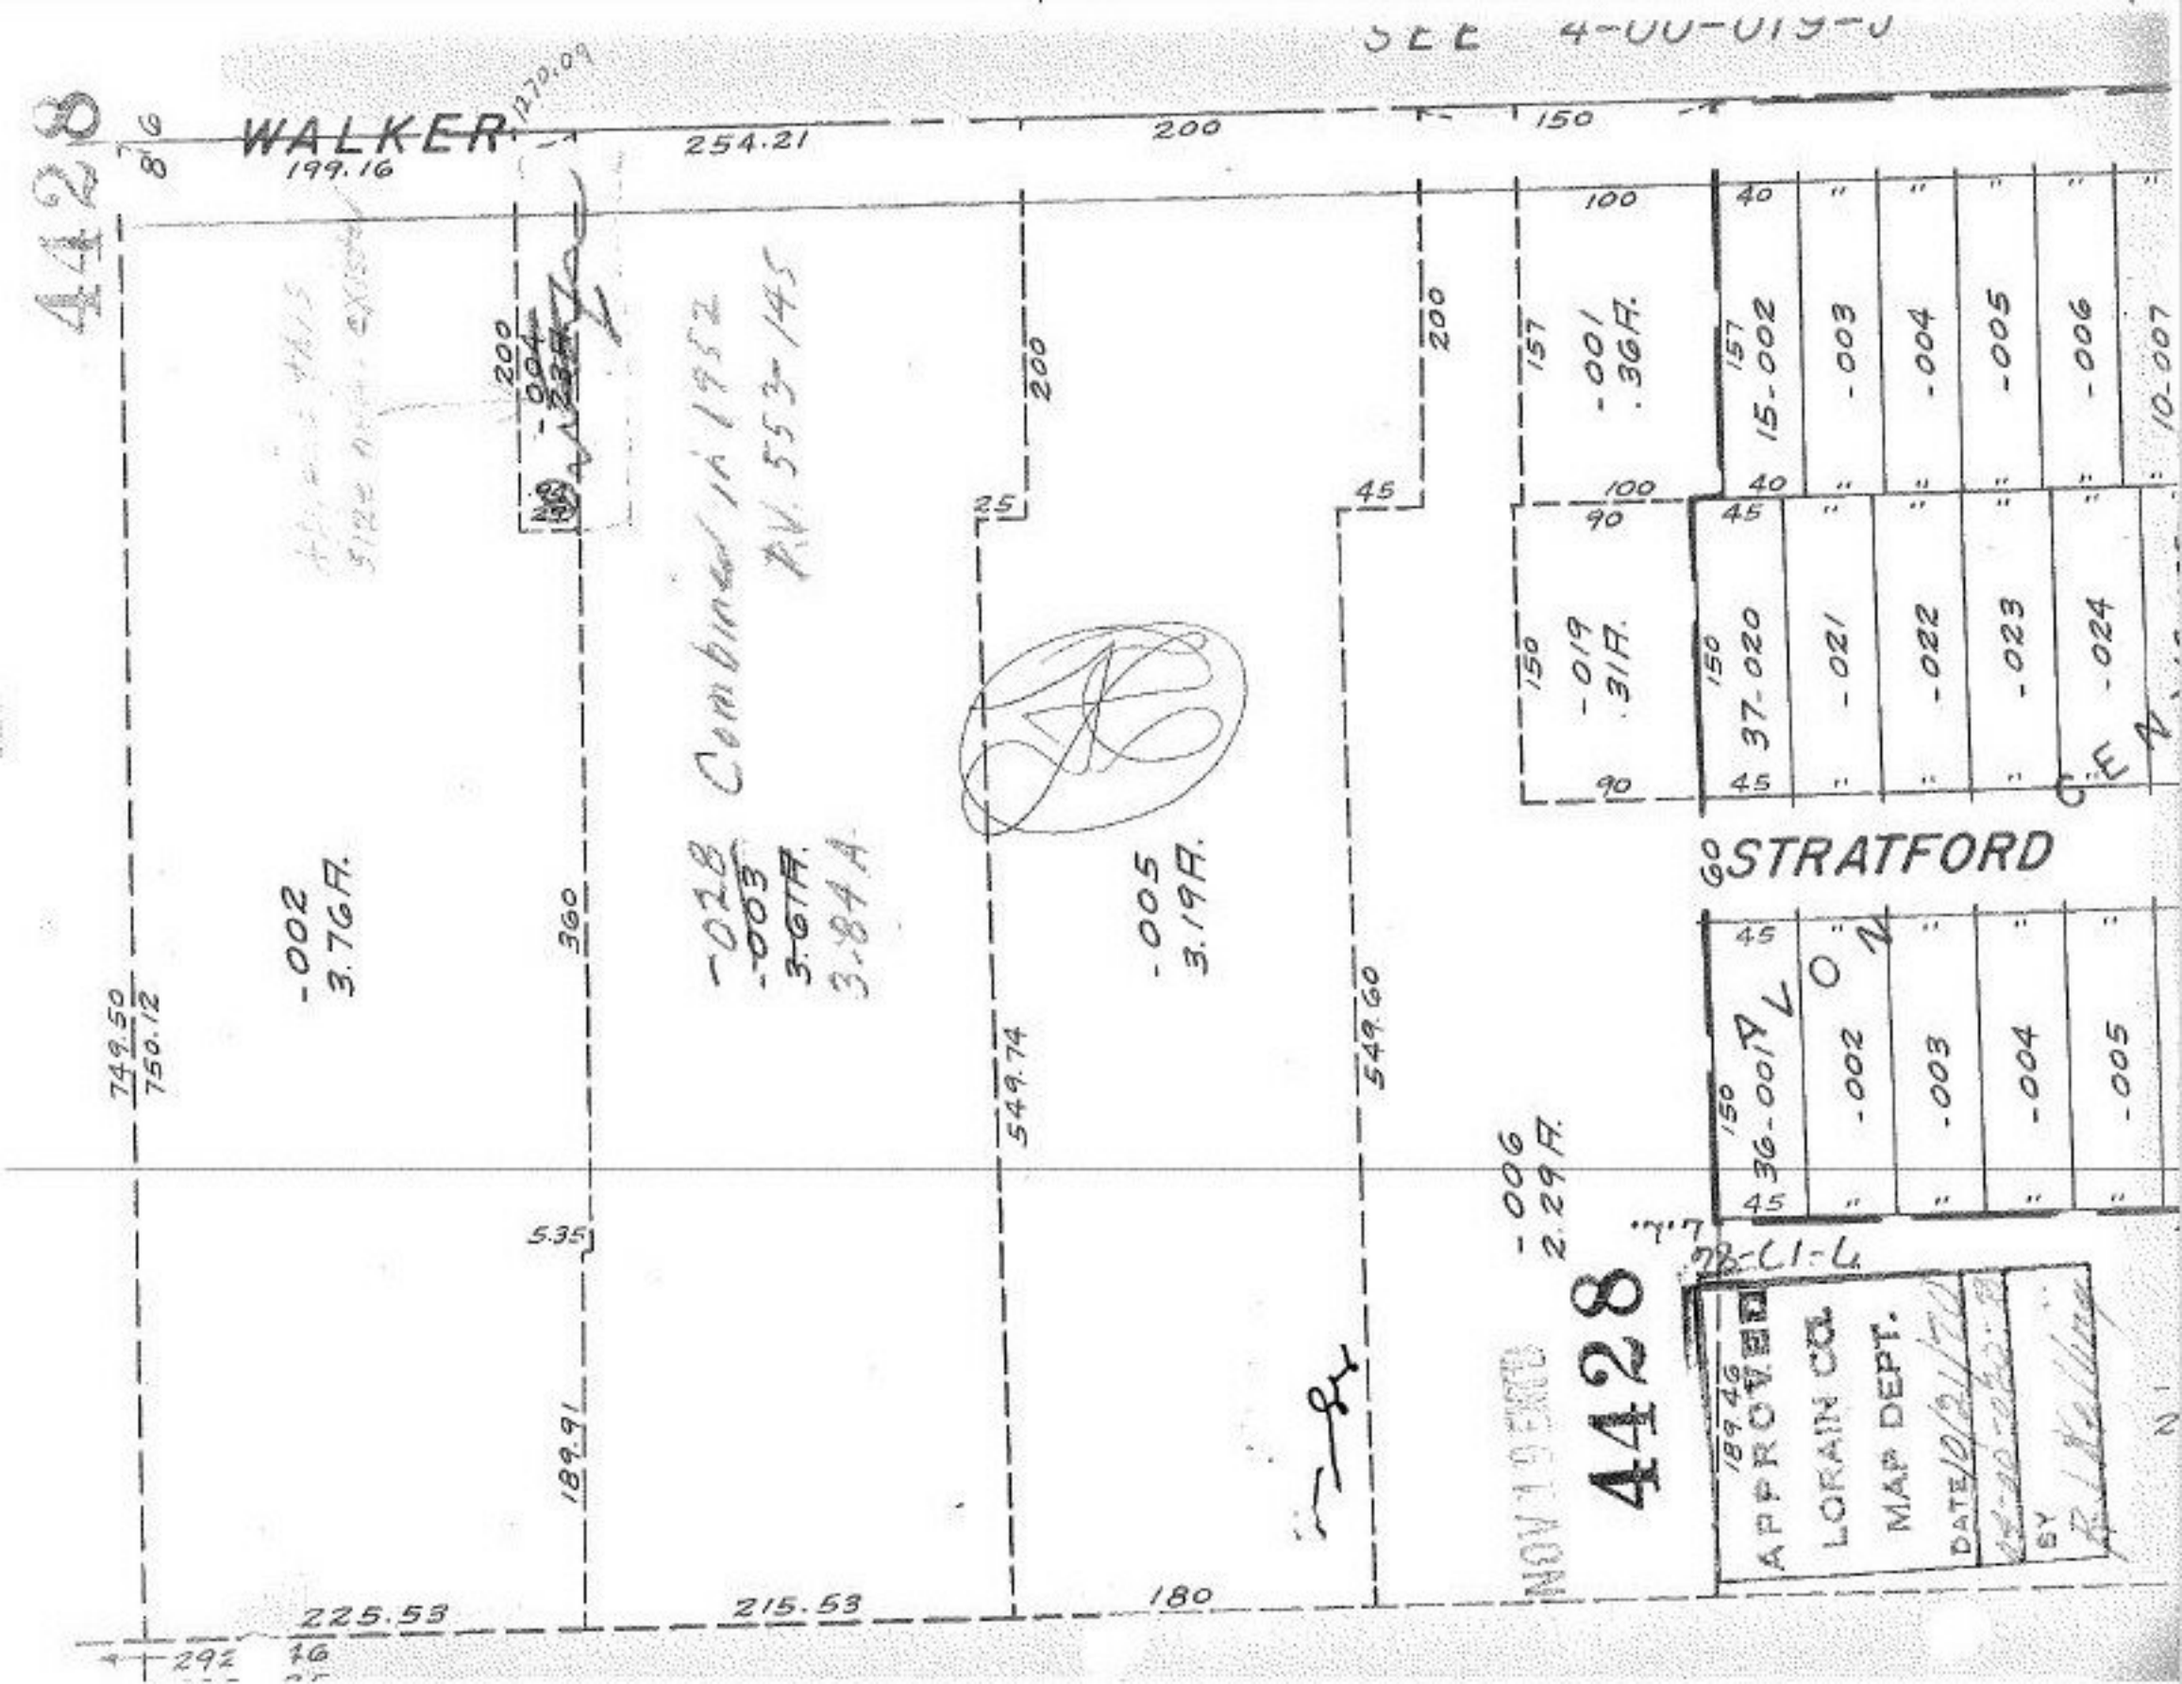

4428
SEE 4-00-019-J
WALKER
199.16
254.21
200
150
100
40
157
15-002
-003
-004
-005
-006
10-007
-001
.36A.
90
45
150
37-020
-021
-022
-023
-024
-019
.31A.
STRATFORD
60
36-001
-002
-003
-004
-005
-006
2.29A.
-002
3.76A.
-028
-003
3.61A.
3.84A
Combined in 1952
P.V. 553-145
-005
3.19A.
360
549.74
549.60
749.50
750.12
5.35
189.91
225.53
215.53
180
292
46
NOV 19 1970
4428
APPROVED
LORAIN CO.
MAP DEPT.
DATE
BY