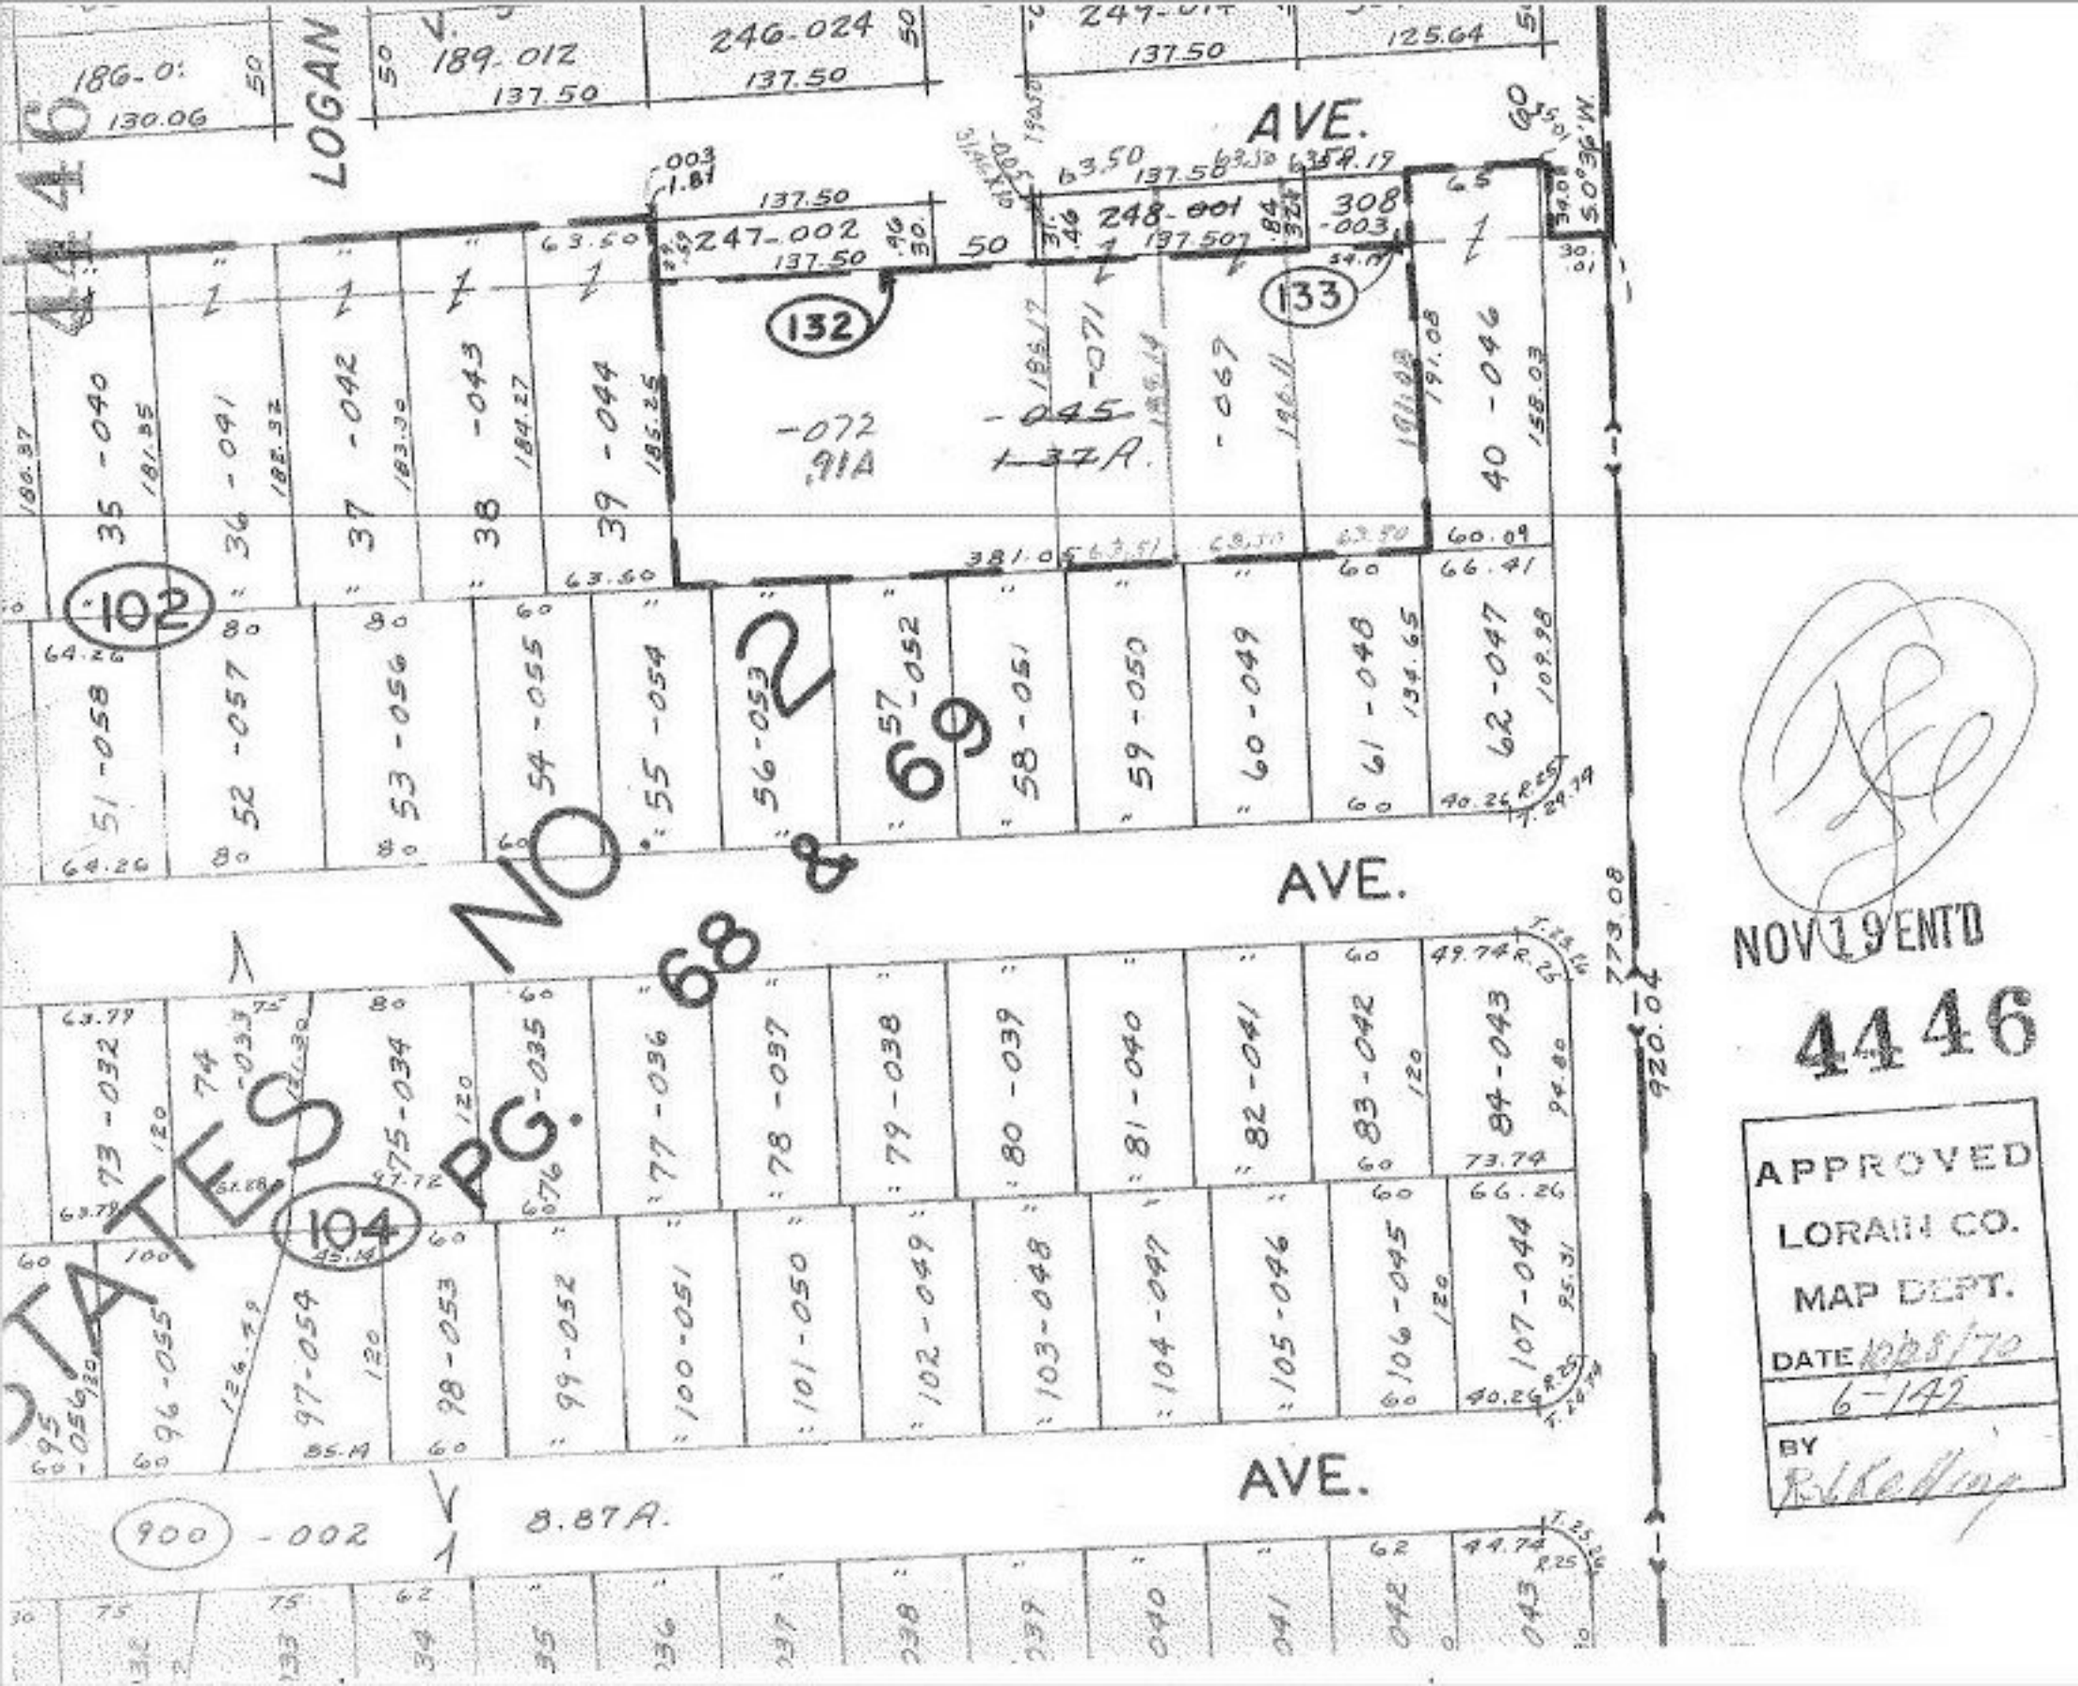
LOGAN AVE.
AVE.
AVE.
AVE.
STATES NO 8
PG. 68
132
133
102
104
900
-002
8.87A.
247-002
248-001
308
-003
-072
.91A
-045
1.37A.
-071
-057
-052
-035
-033
-034
-054
-055
-056
-058
-040
-041
-042
-043
-044
-046
-047
-048
-049
-050
-051
-036
-037
-038
-039
-032
-053
-099
-100
-101
-102
-103
-104
-105
-106
-107
-096
-097
-098
-095
NOV 19 ENT'D
4446
APPROVED
LORAIN CO.
MAP DEPT.
DATE 10/8/70
6-142
BY R.L.Kelley