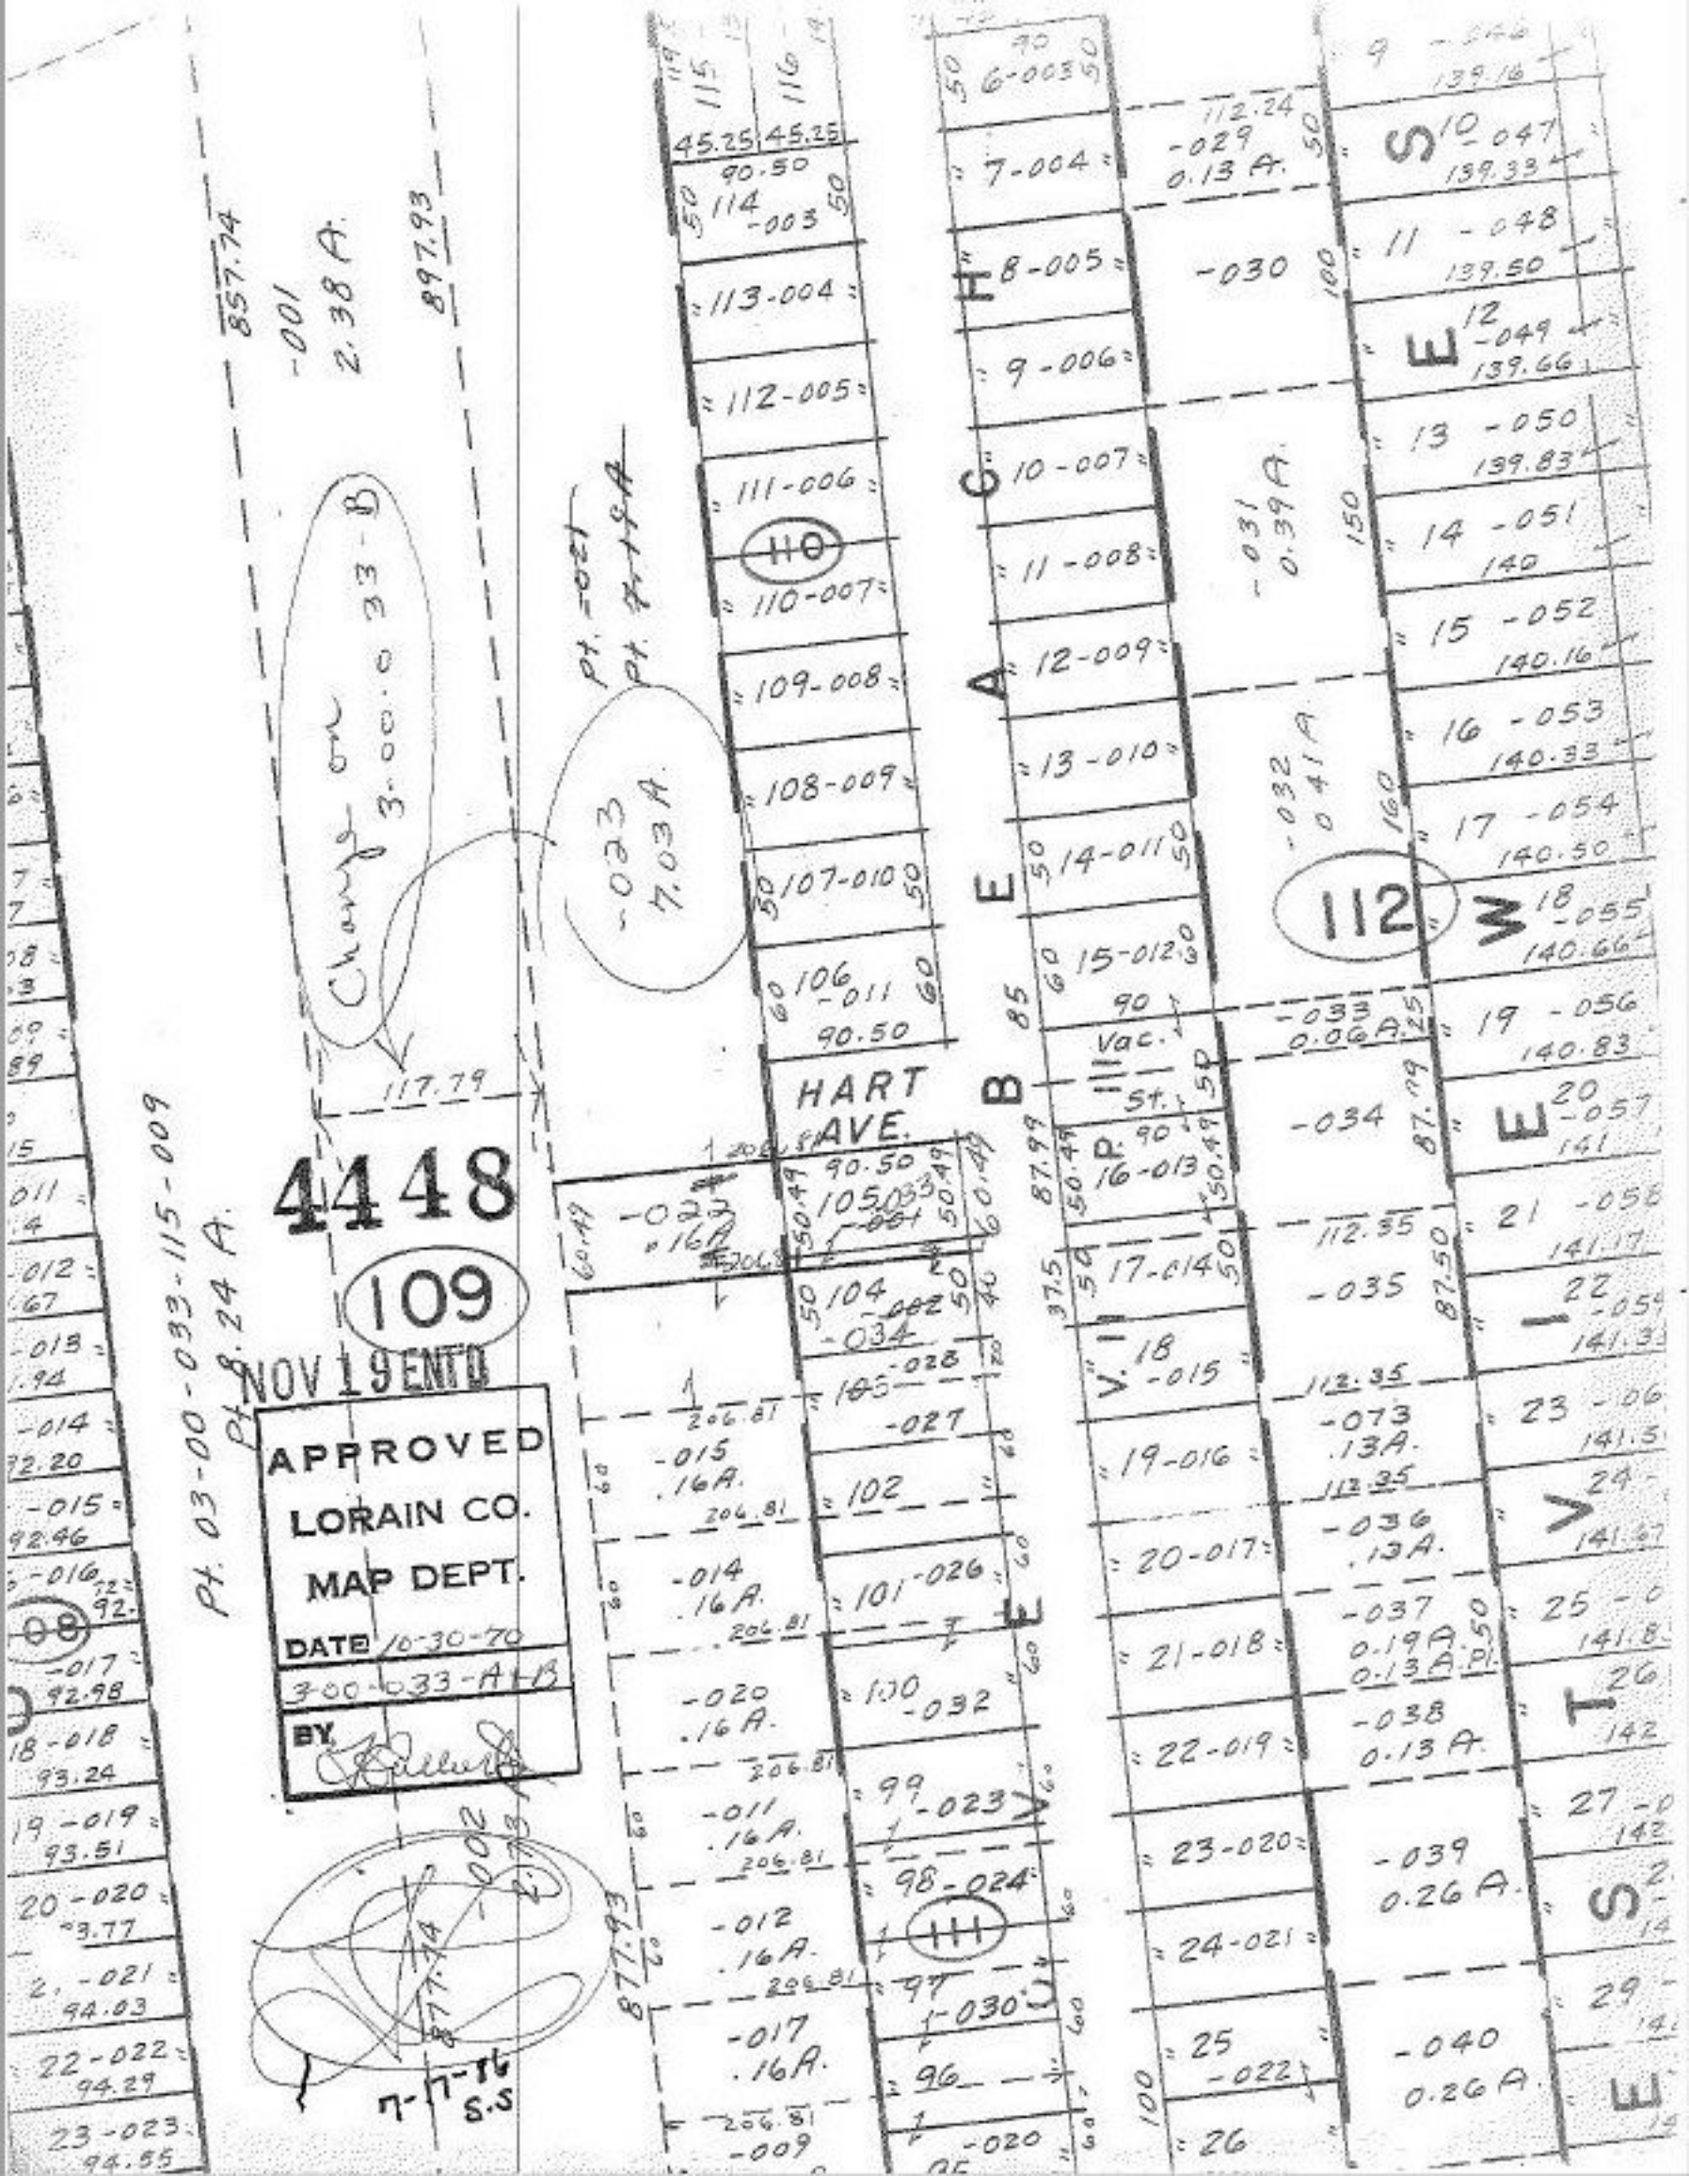
4448
109
110
111
112
HART AVE.
NOV 19 ENTD
APPROVED
LORAIN CO.
MAP DEPT.
DATE 10-30-70
300-033-A+B
BY
Pt. 03-00-033-115-009
Pt. 8.24 A.
857.74
897.93
2.38 A.
-001
Change one 3.00.0 33-B
Pt. -021
Pt. 7.41 SA
-023
7.03 A.
117.79
877.43
A
B
C
D
E
H
V
I
T
S
W