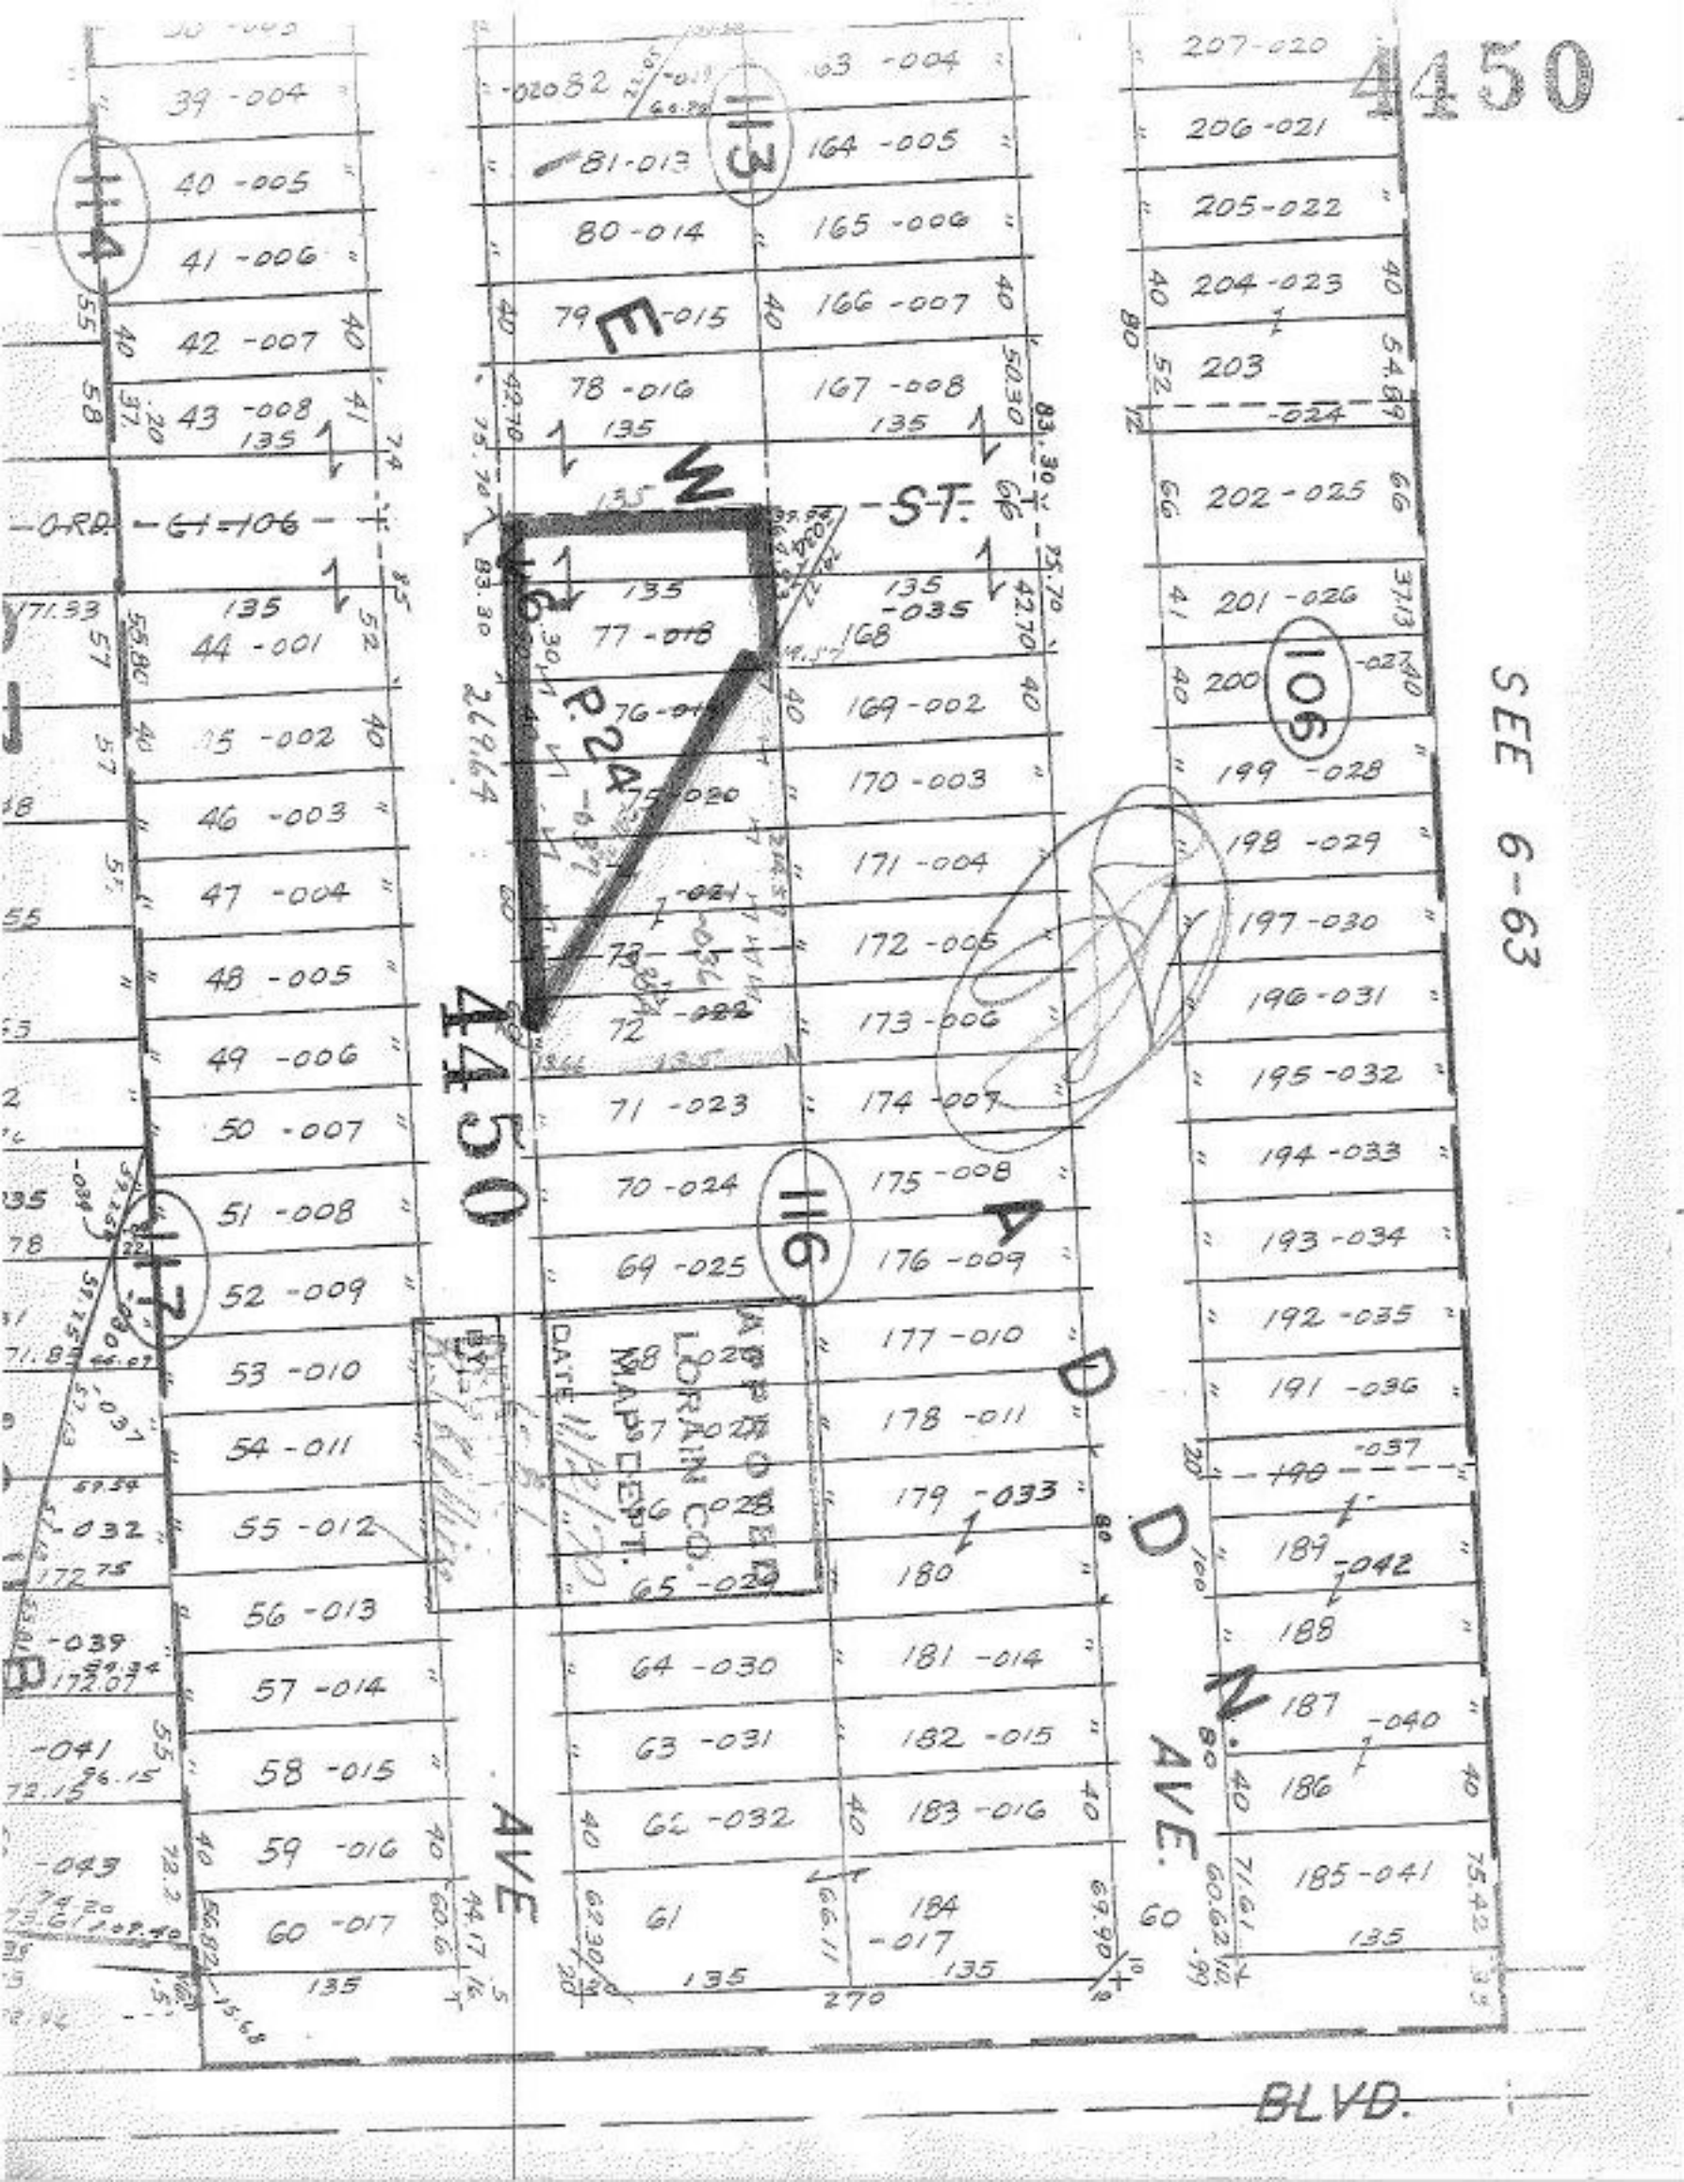
4450
SEE 6-63
