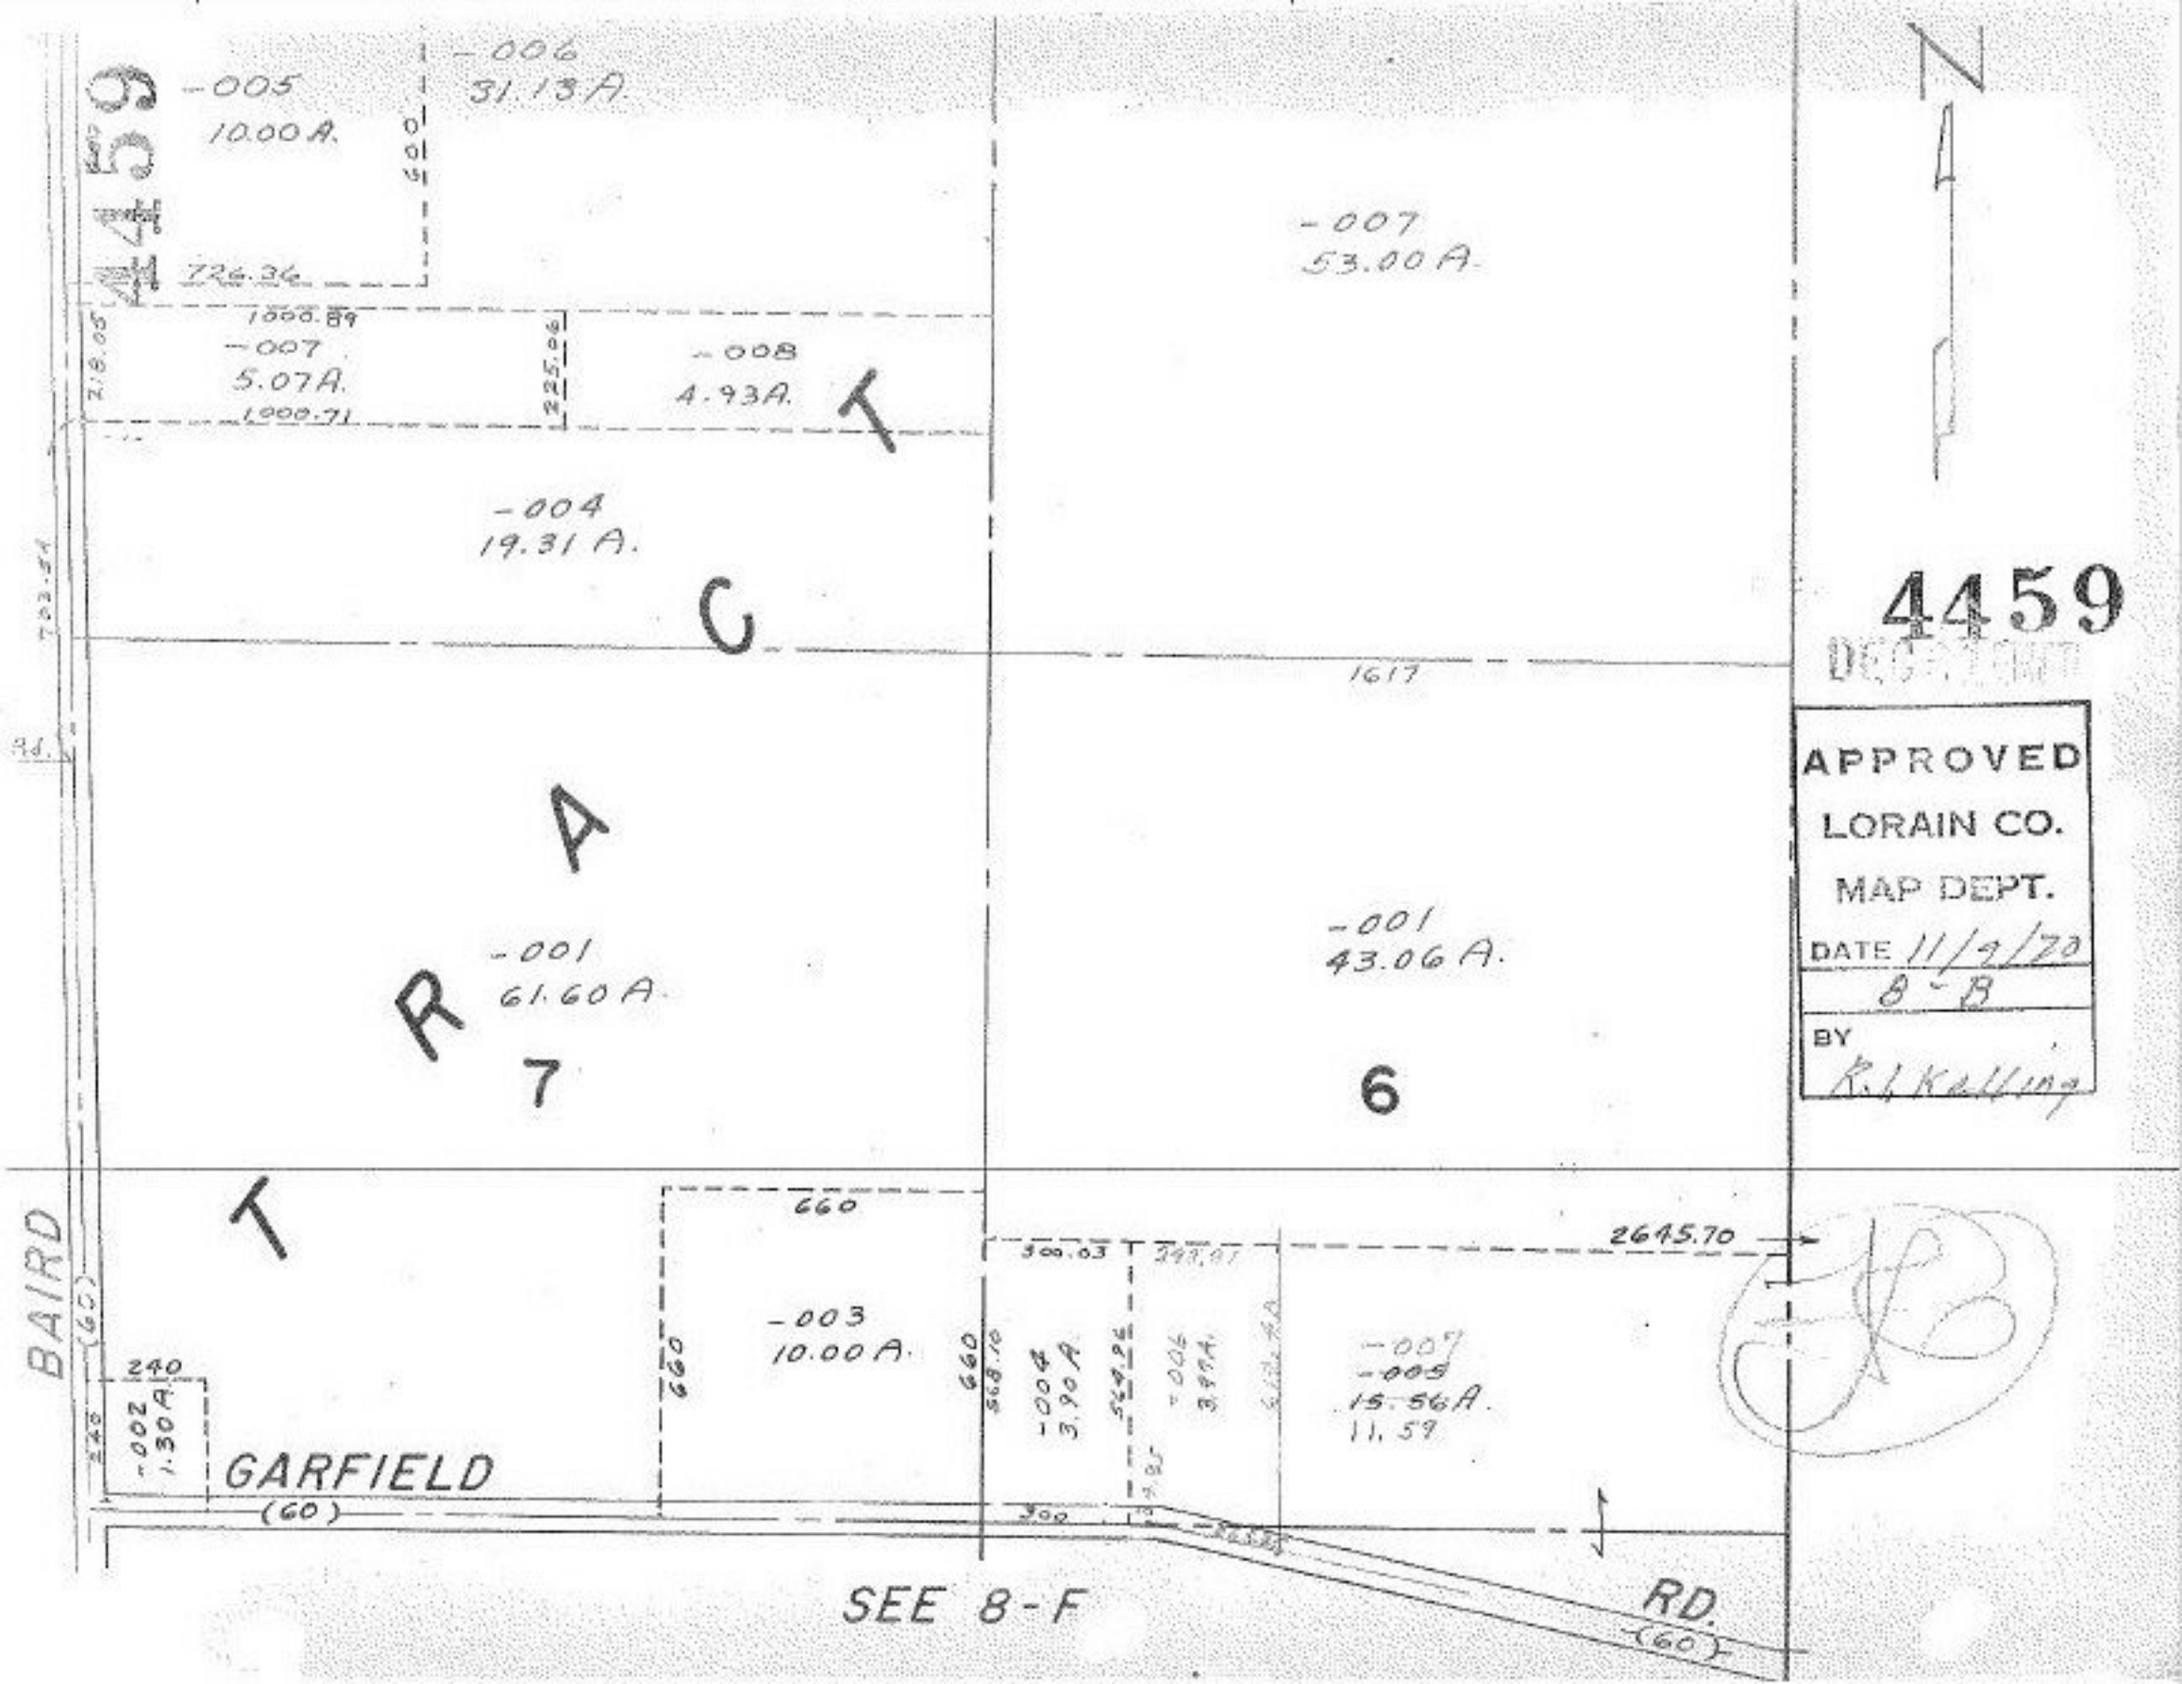
-006
31.13A.
-005
10.00A.
726.34
1000.89
-007
5.07A.
1000.71
218.05
225.06
-008
4.93A.
-007
53.00A.
-004
19.31 A.
733.54
1617
4459
DEPARTMENT
APPROVED
LORAIN CO.
MAP DEPT.
DATE 11/9/70
8-B
BY
R. J. Kelling
-001
61.60 A.
7
-001
43.06 A.
6
660
-003
10.00 A.
660
568.10
300.03
349.01
2645.70
-004
3.90 A.
-006
3.99A.
-007
-009
15.56A.
11.59
240
-002
1.30 A.
240
BAIRD
(60)
GARFIELD
(60)
300
SEE 8-F
RD.
(60)
N