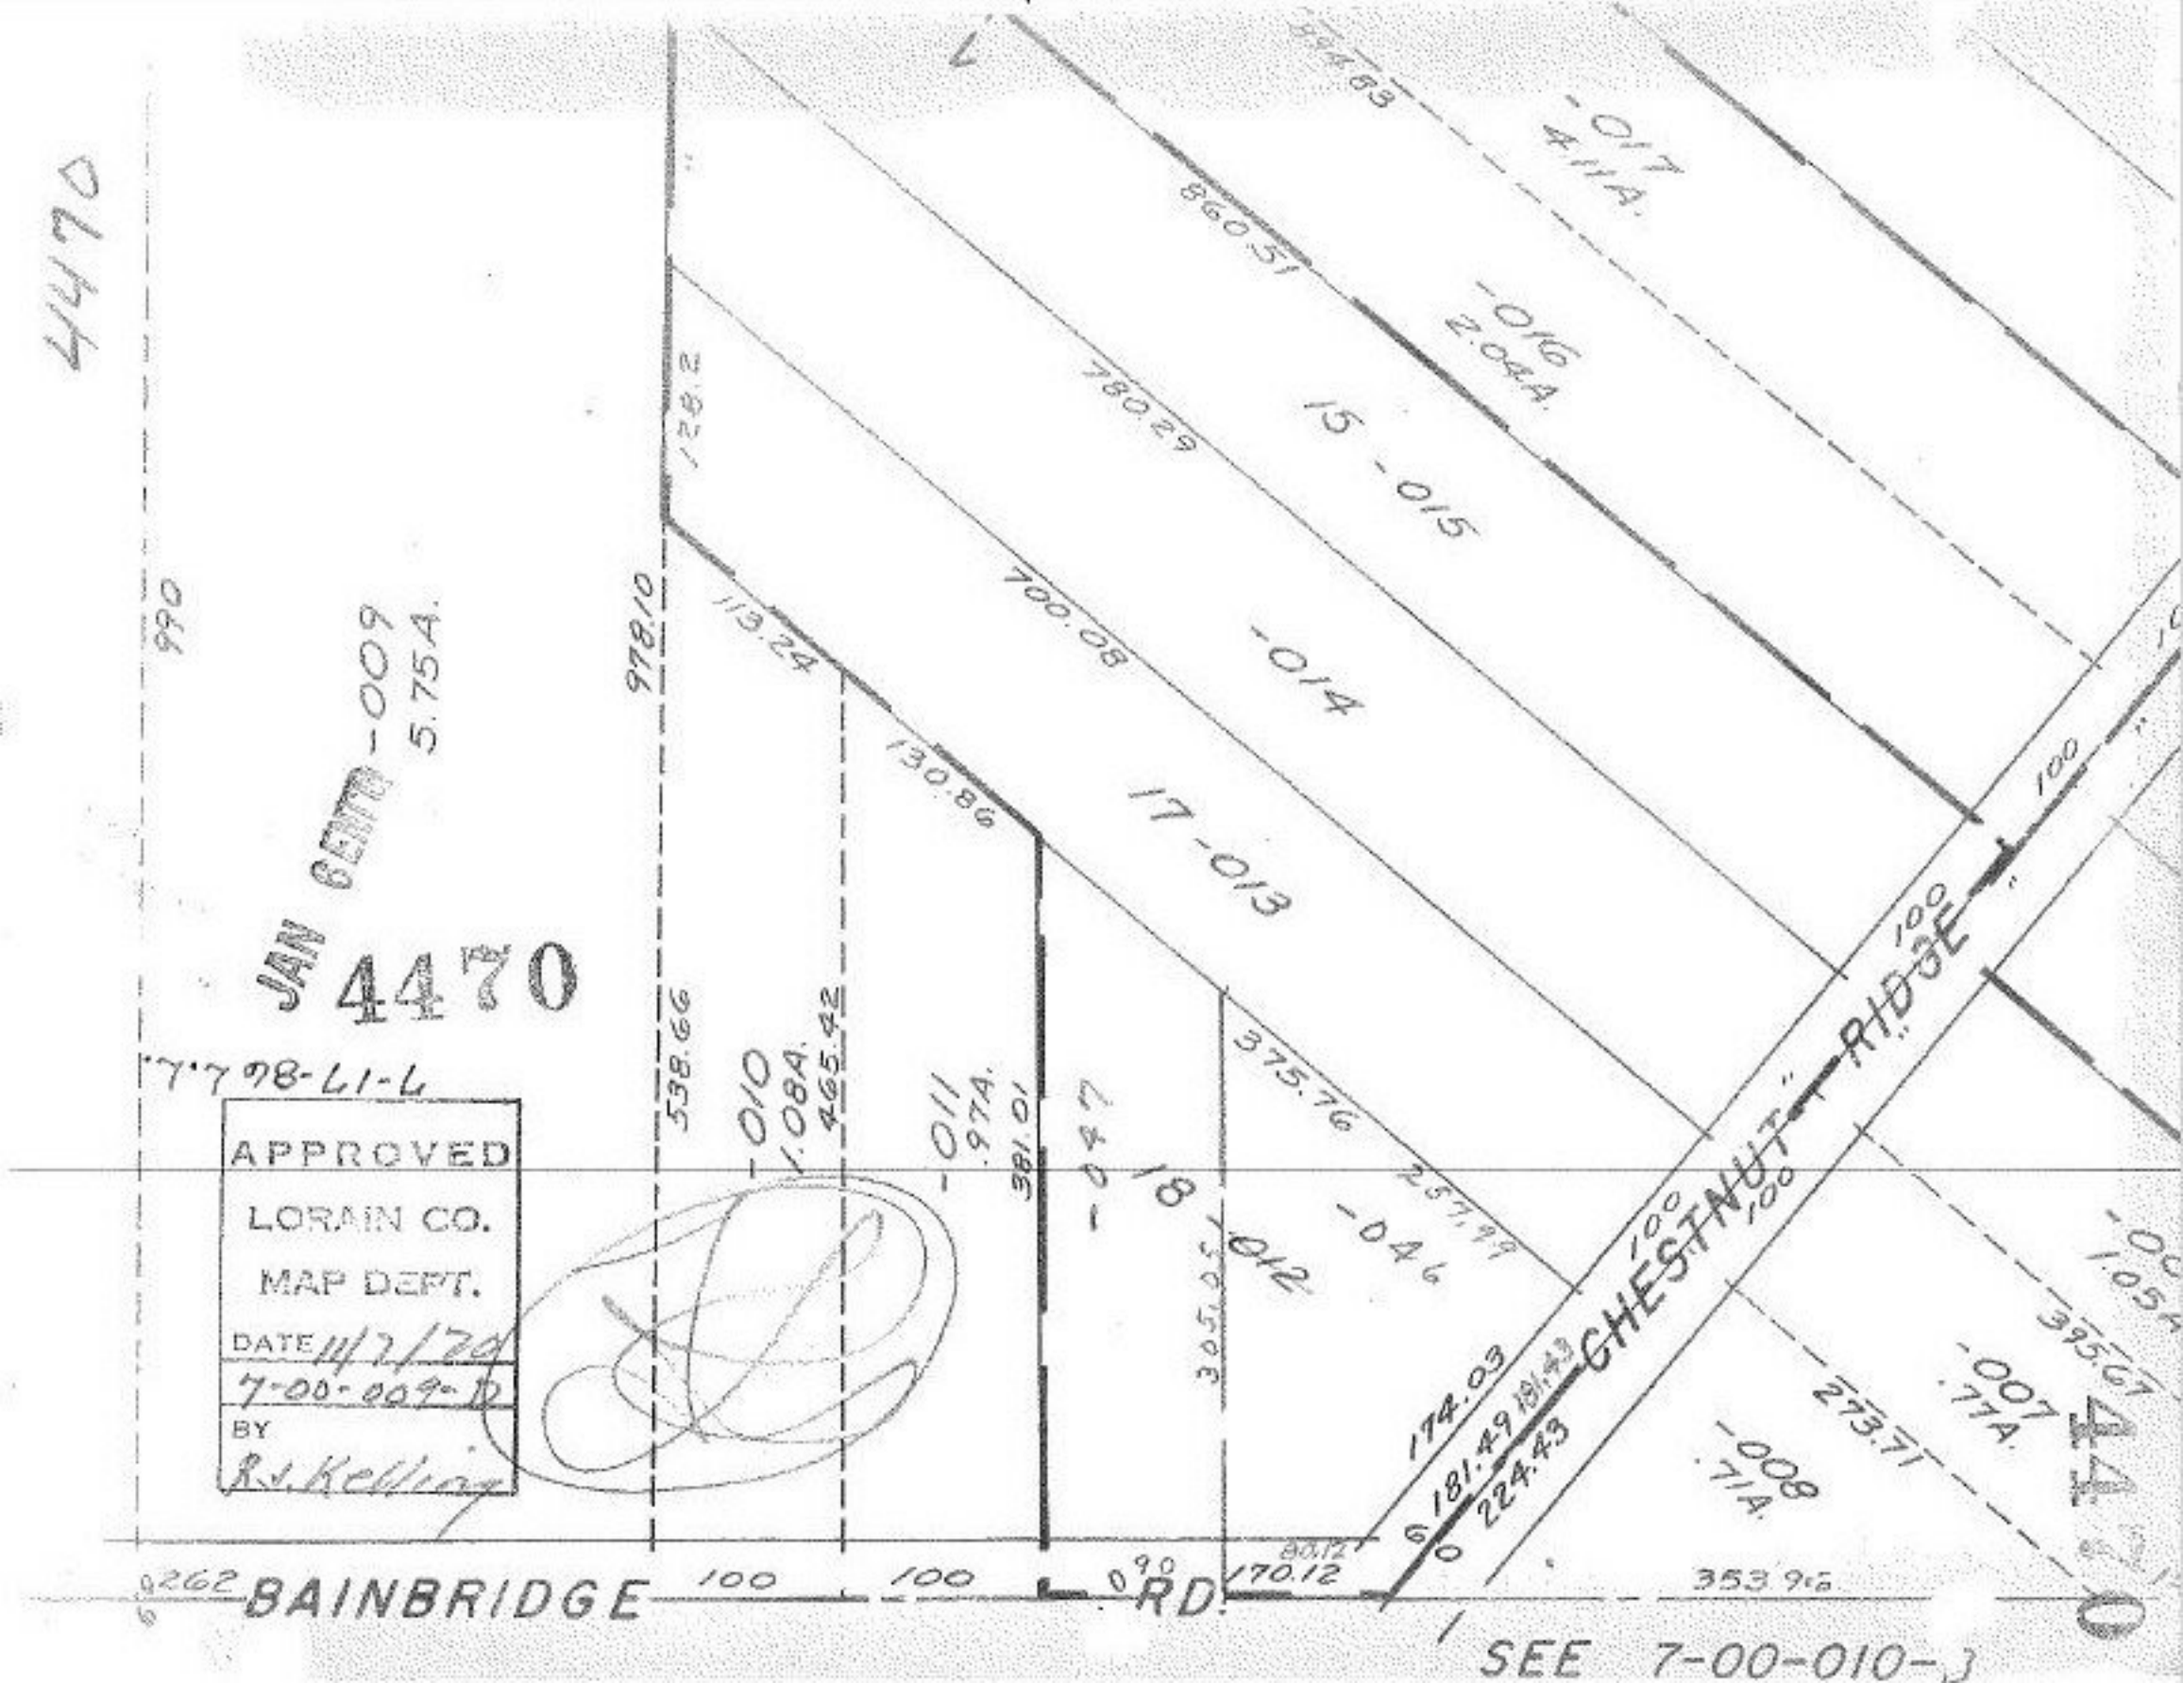
4470
JAN 6 ENTR
4470
APPROVED
LORAIN CO.
MAP DEPT.
DATE 11/7/70
7-00-009-D
BY
R.J. Kelling
-009
5.75A.
-010
1.08A.
-011
.97A.
-012
-014
-015
-016
2.04A.
-017
4.11A.
-008
.71A.
-007
.77A.
-046
-047
15
17
18
BAINBRIDGE RD.
CHESTNUT RIDGE
SEE 7-00-010-J
990
978.10
538.66
465.42
381.01
305.05
257.99
375.76
700.08
780.29
860.51
894.83
113.24
130.86
128.2
174.03
181.49
181.43
224.43
273.71
395.67
353.96
170.12
80.12
100
262