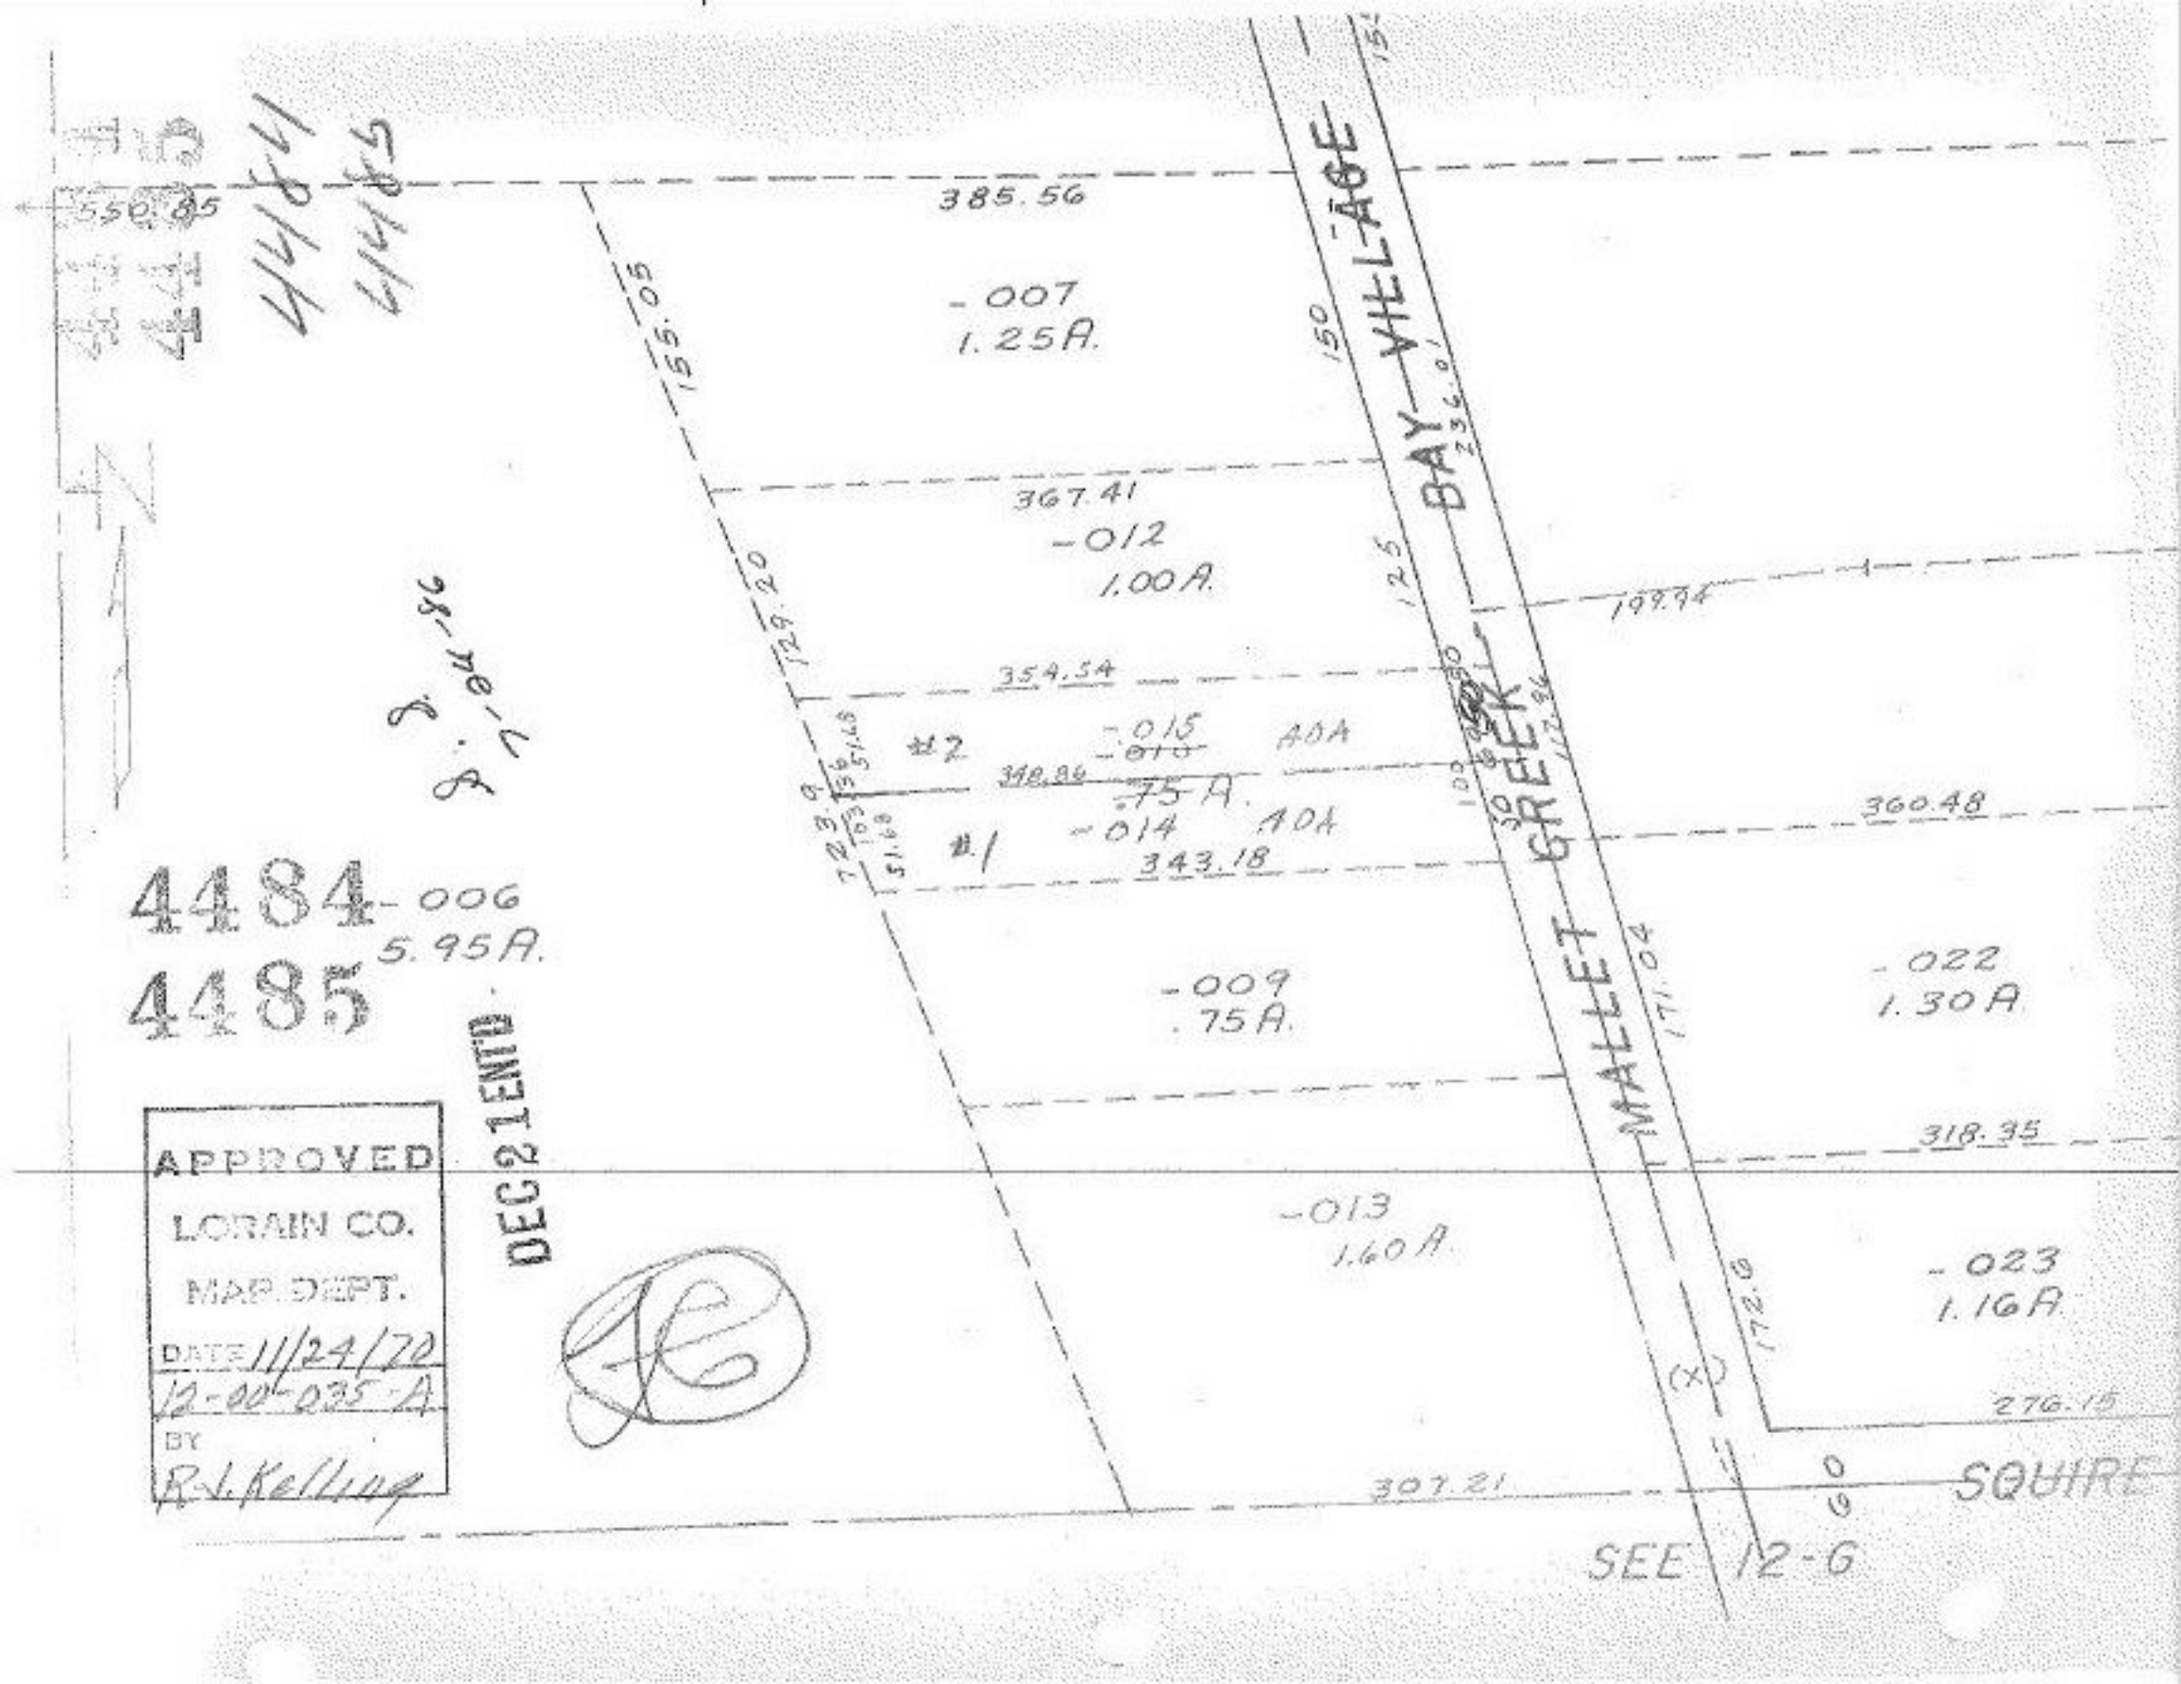

4484
4485
4484
4485
550.85
385.56
-007
1.25A.
155.05
150
BAY VILLAGE
367.41
-012
1.00A.
129.20
125
199.94
354.54
#2
-015
-010
40A
348.86
.75A.
#1
-014
40A
343.18
360.48
4484 -006
5.95A.
4485
-009
.75A.
171.04
-022
1.30A
318.35
-013
1.60A.
-023
1.16A.
172.6
276.15
307.21
SQUIRE
SEE 12-6
APPROVED
LORAIN CO.
MAP DEPT.
DATE 11/24/70
12-00-035-A
BY
R.J. Kelling
DEC 21 ENT'D