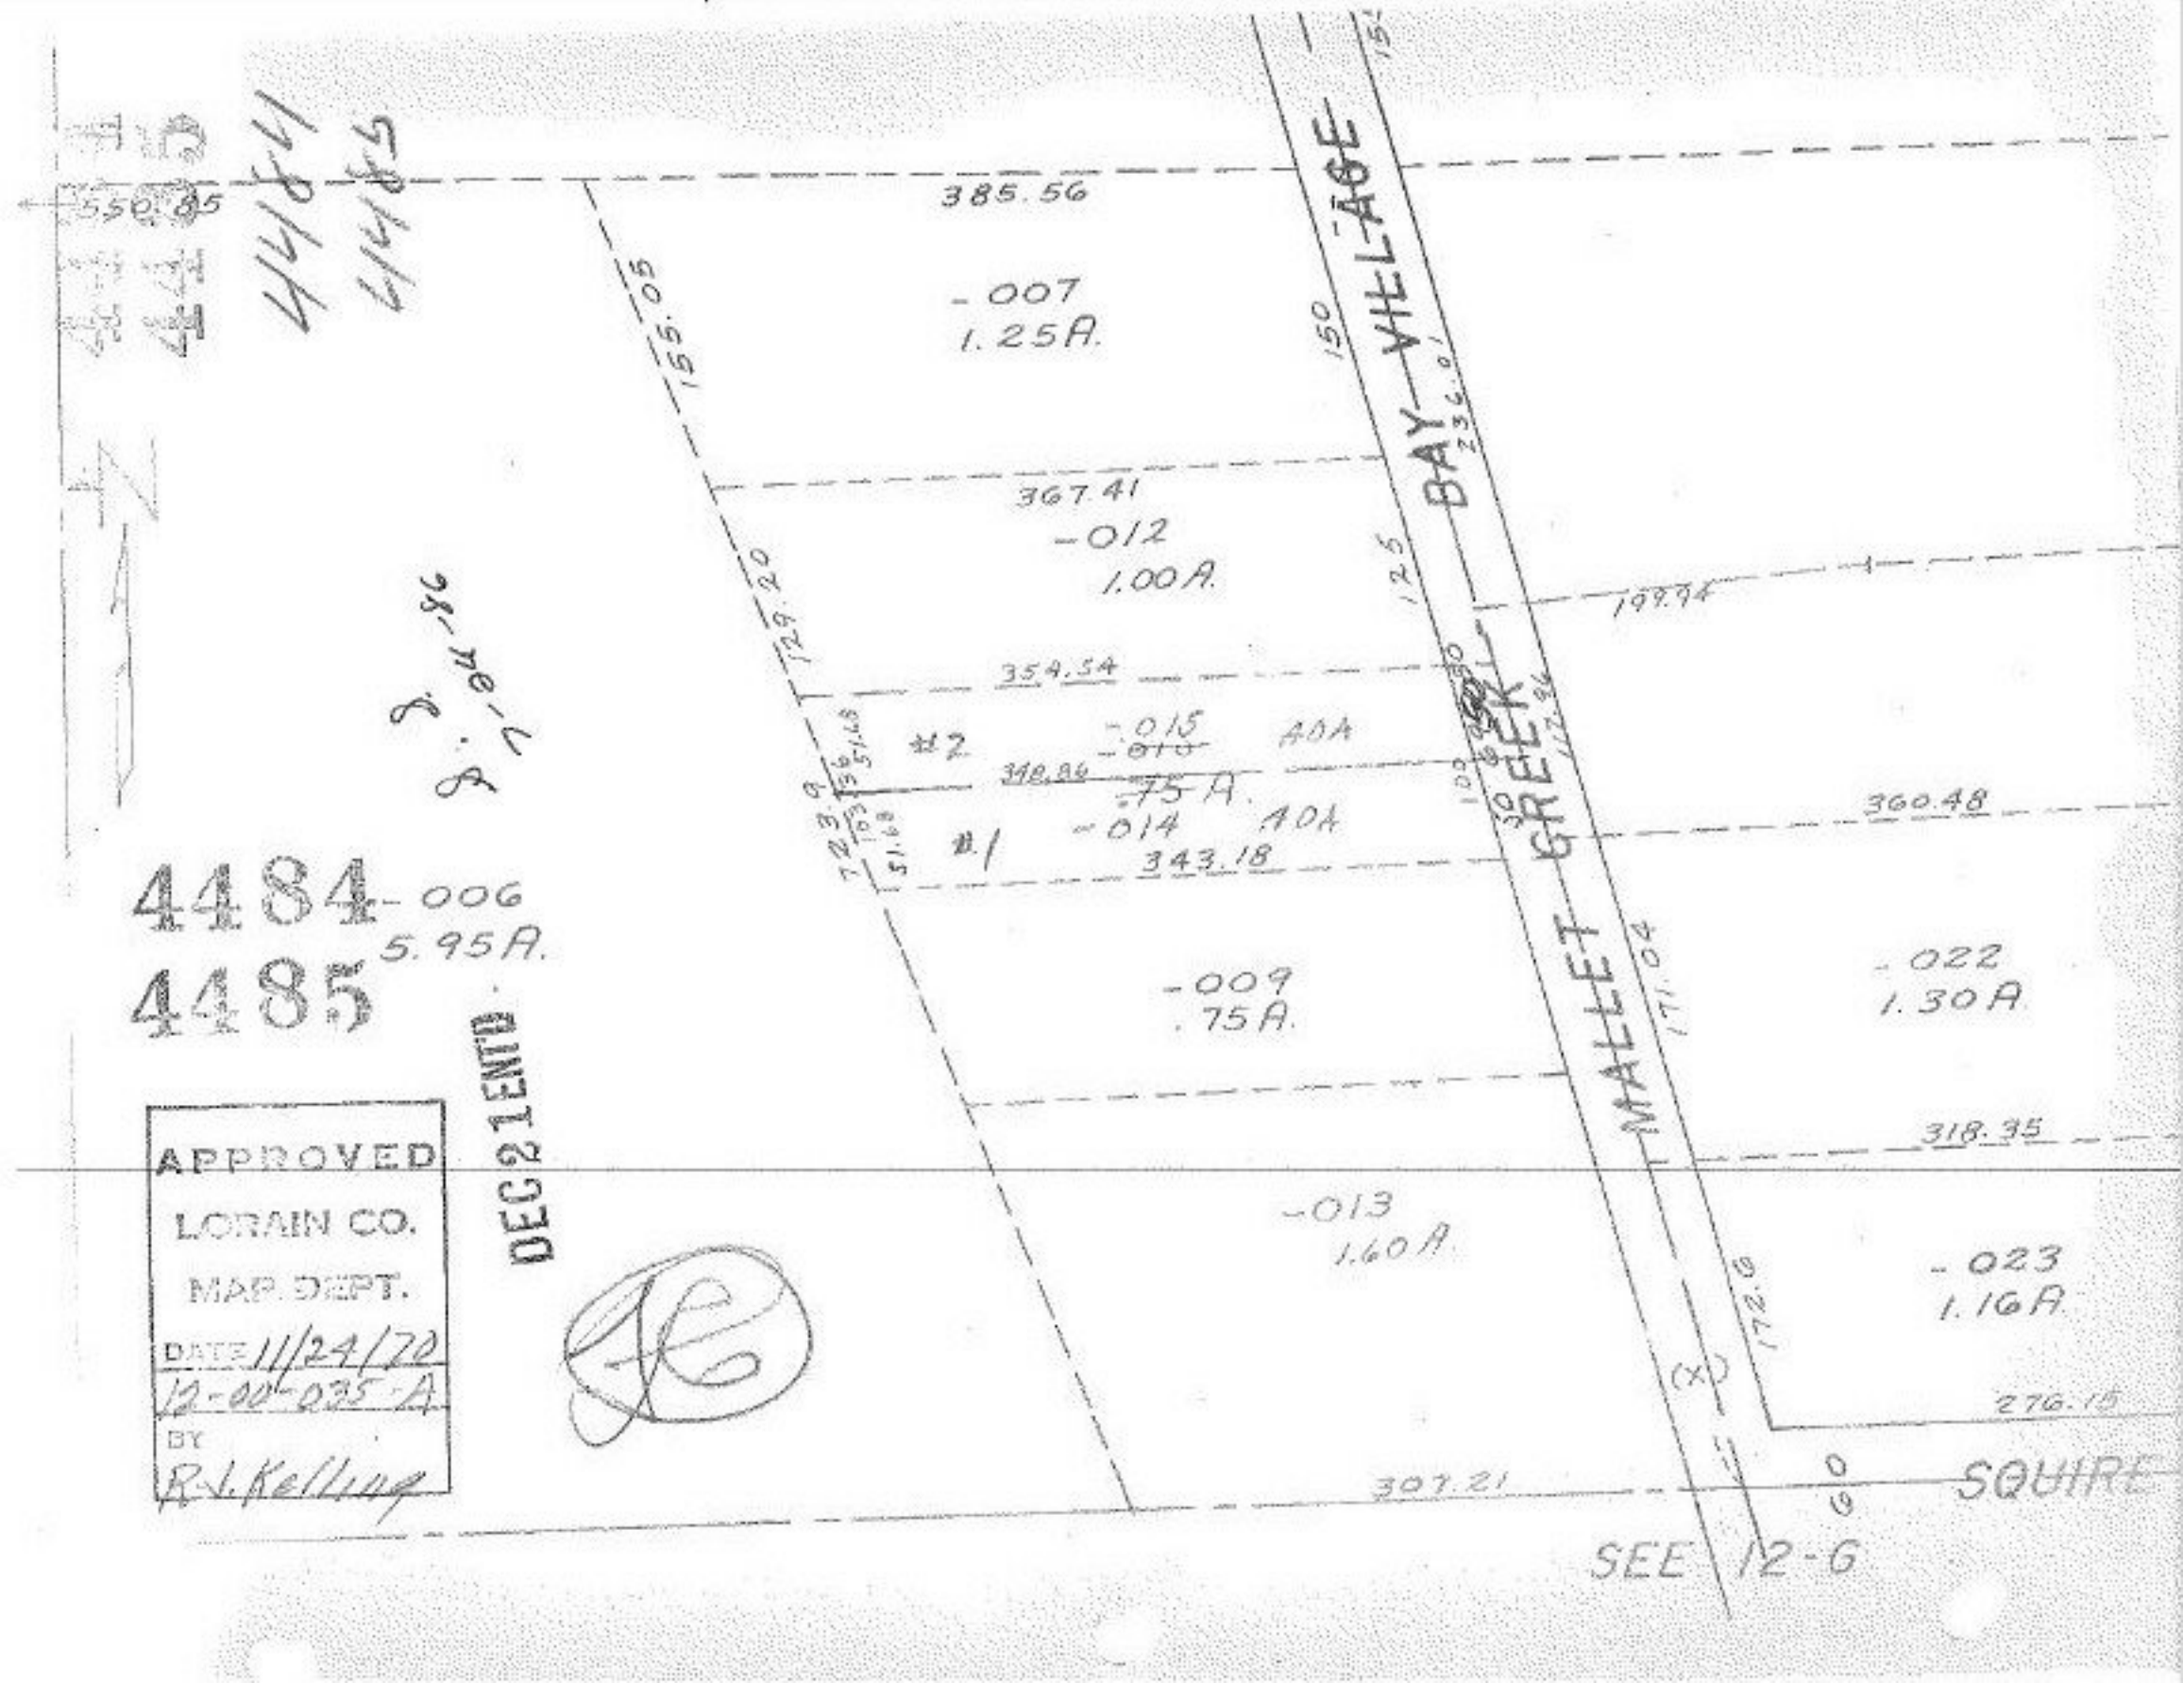
385.56
-007
1.25A.
155.05
150
BAY VILLAGE
367.41
-012
1.00A.
125
109.94
354.54
#2
-015
-010
.40A
318.86
.75A.
-014
.40A
#1
343.18
360.48
4484 -006
5.95A.
4485
-009
.75A.
-022
1.30A
318.35
-013
1.60A.
-023
1.16A.
276.15
307.21
SEE 12-G
APPROVED
LORAIN CO.
MAP DEPT.
DATE 11/24/72
12-00-035-A
BY
R. L. Kellum
DEC 21 ENTD