4503

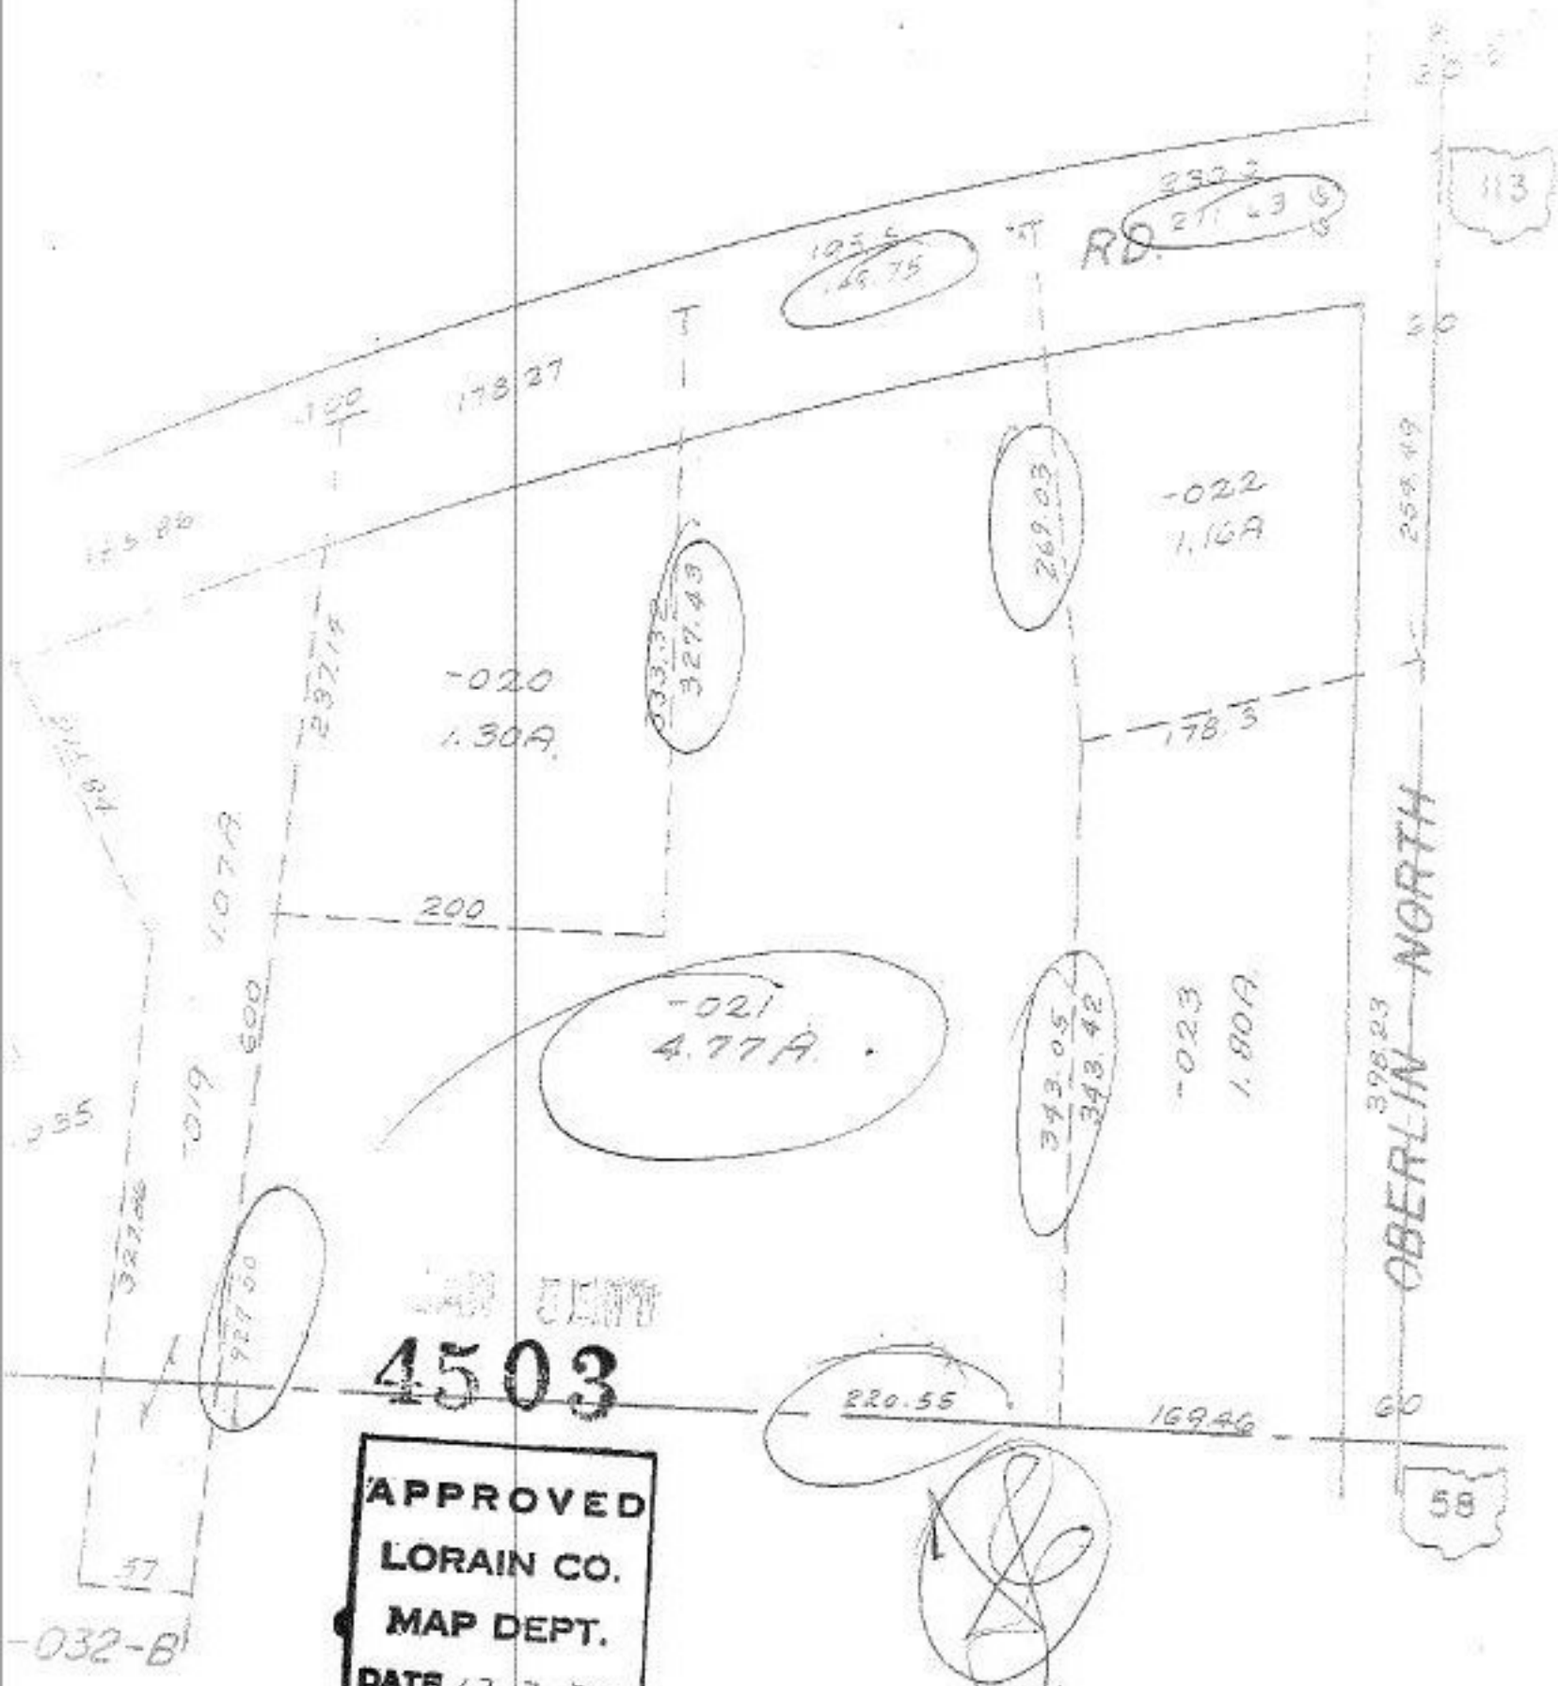

4503

APPROVED
LORAIN CO.
MAP DEPT.
DATE 12-3-70
3-00-033-B
BY

3-00-033-B