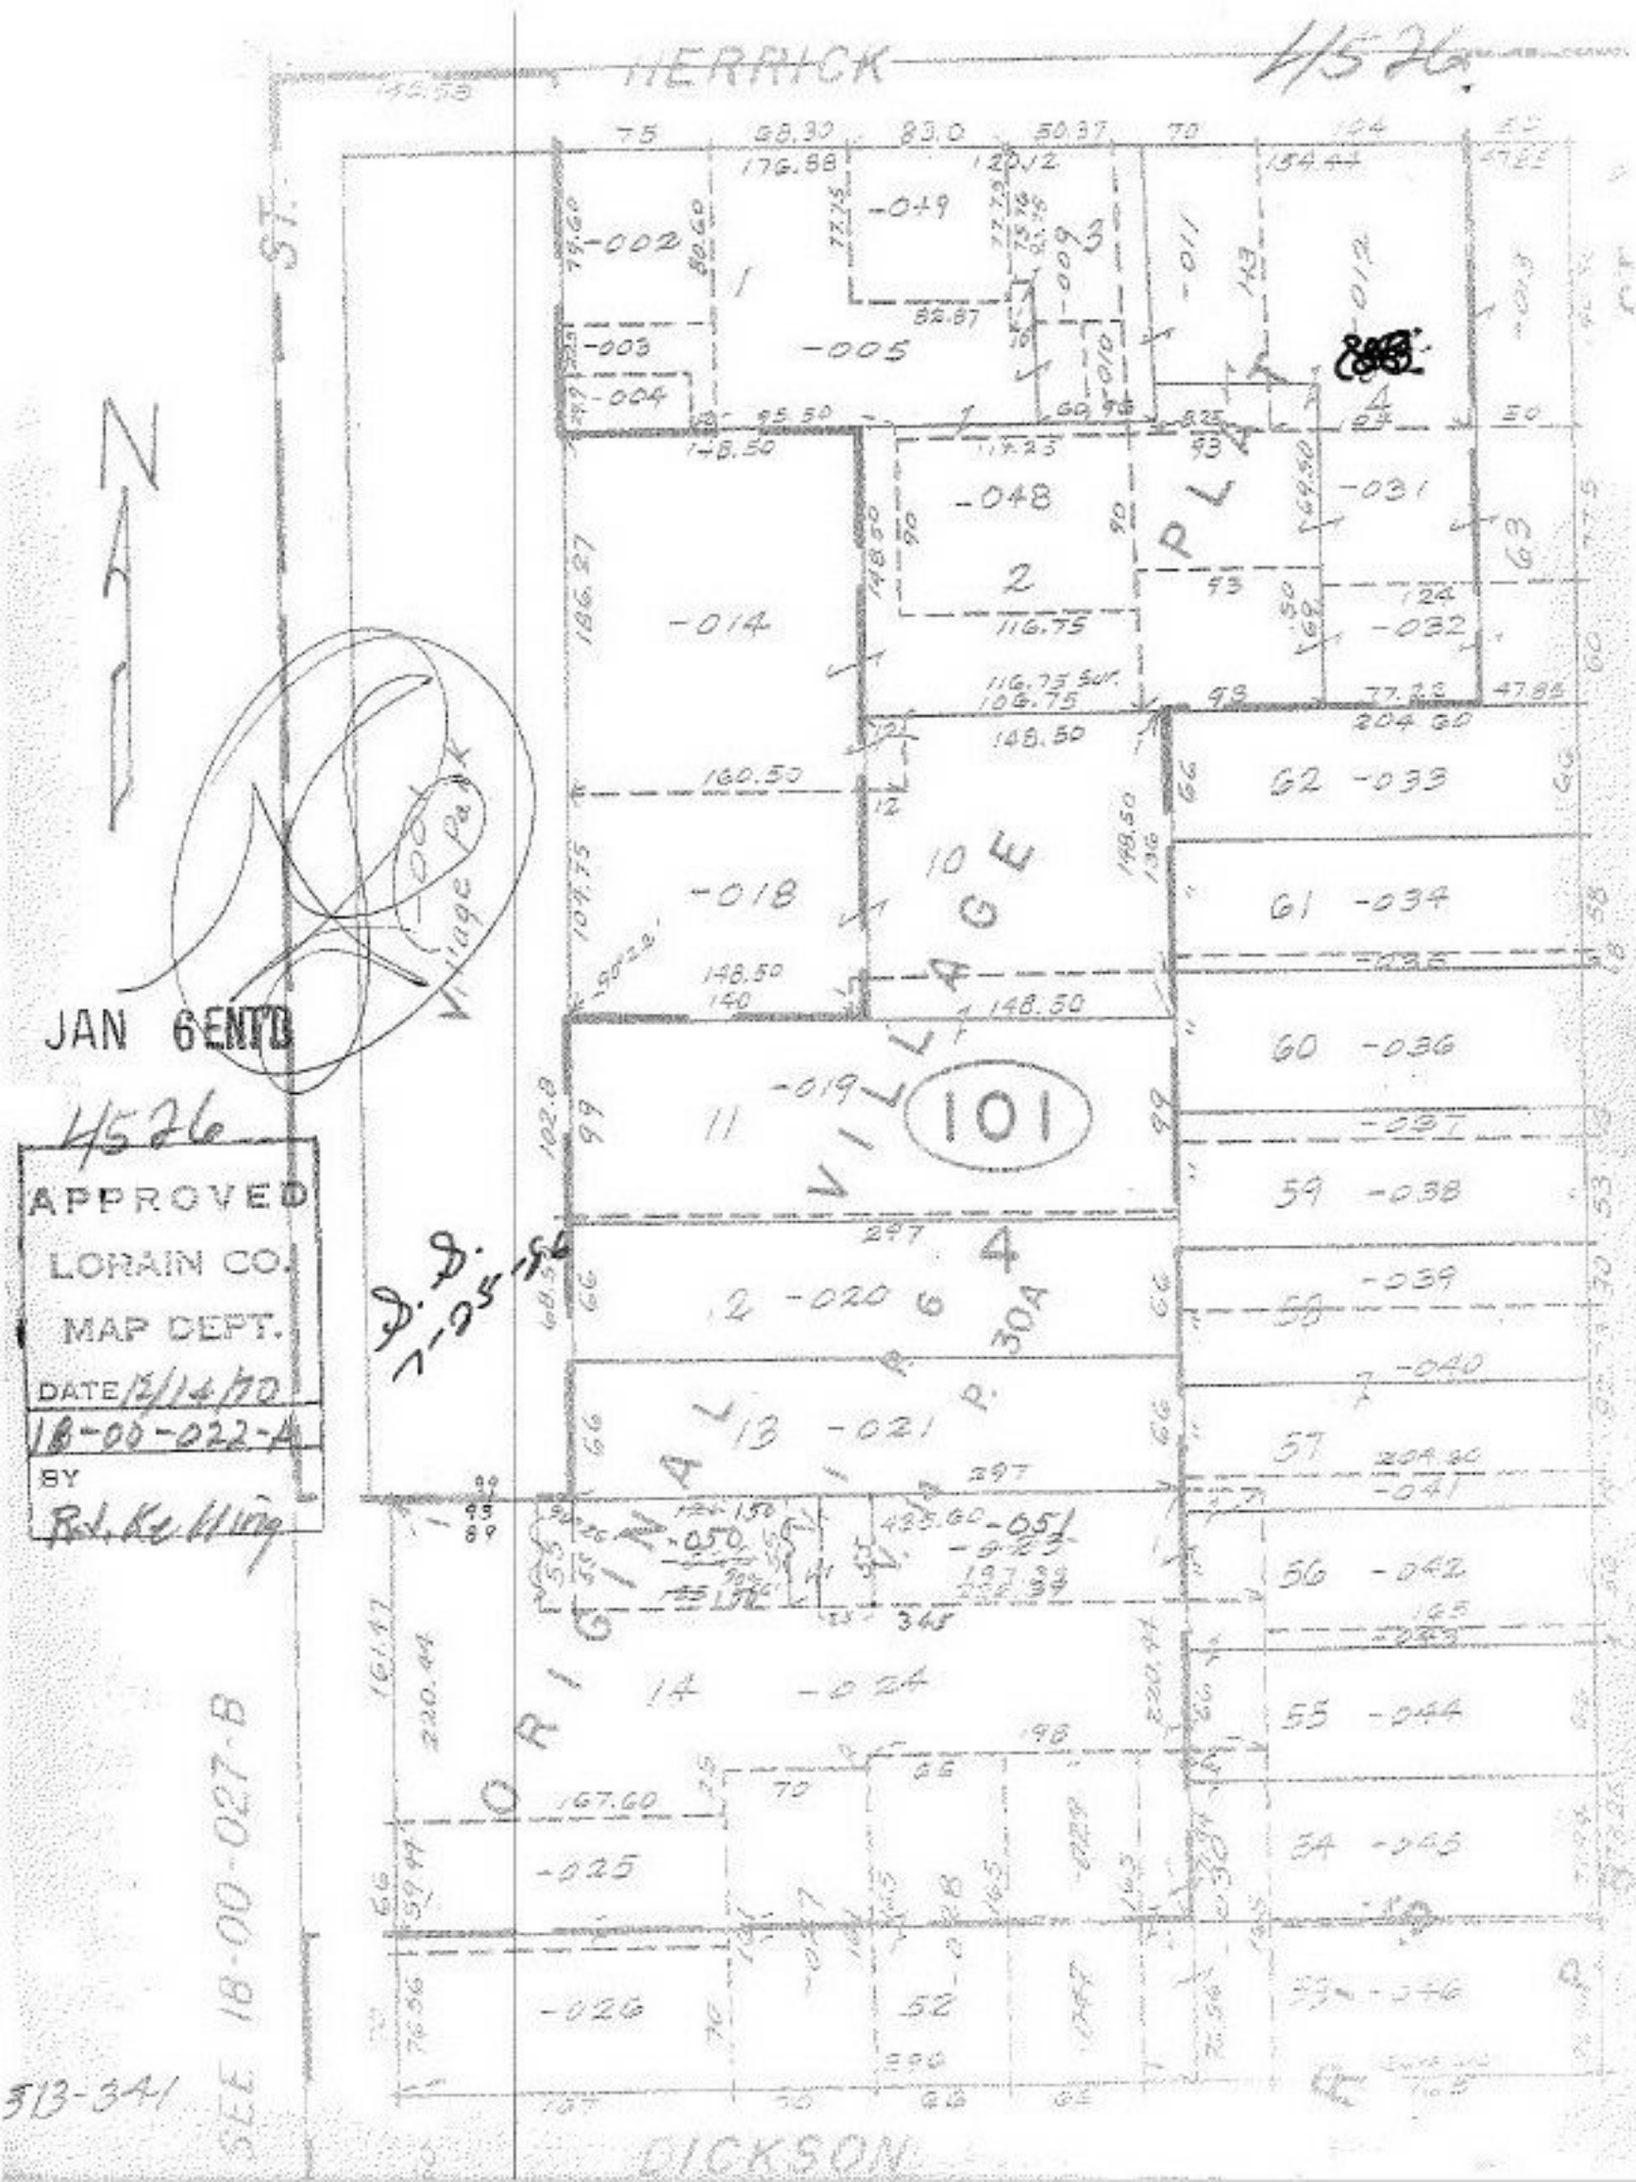
HERRICK
4526
NAPOLEON ST.
ORIGINAL VILLAGE
PLAT
101
-002
-003
-004
-005
-009
-010
-011
-012
-013
-014
-018
-019
-020
-021
-022
-024
-025
-026
-027
-028
-029
-030
-031
-032
-033
-034
-035
-036
-037
-038
-039
-040
-041
-042
-043
-044
-045
-046
-047
-048
-049
-050
-051
-052
JAN 6 ENTD
4526
APPROVED
LORAIN CO.
MAP DEPT.
DATE 12/14/70
18-00-022-A
BY
R.L. Ke Illing
7-05-84
SEE 18-00-027.B
513-341
DICKSON