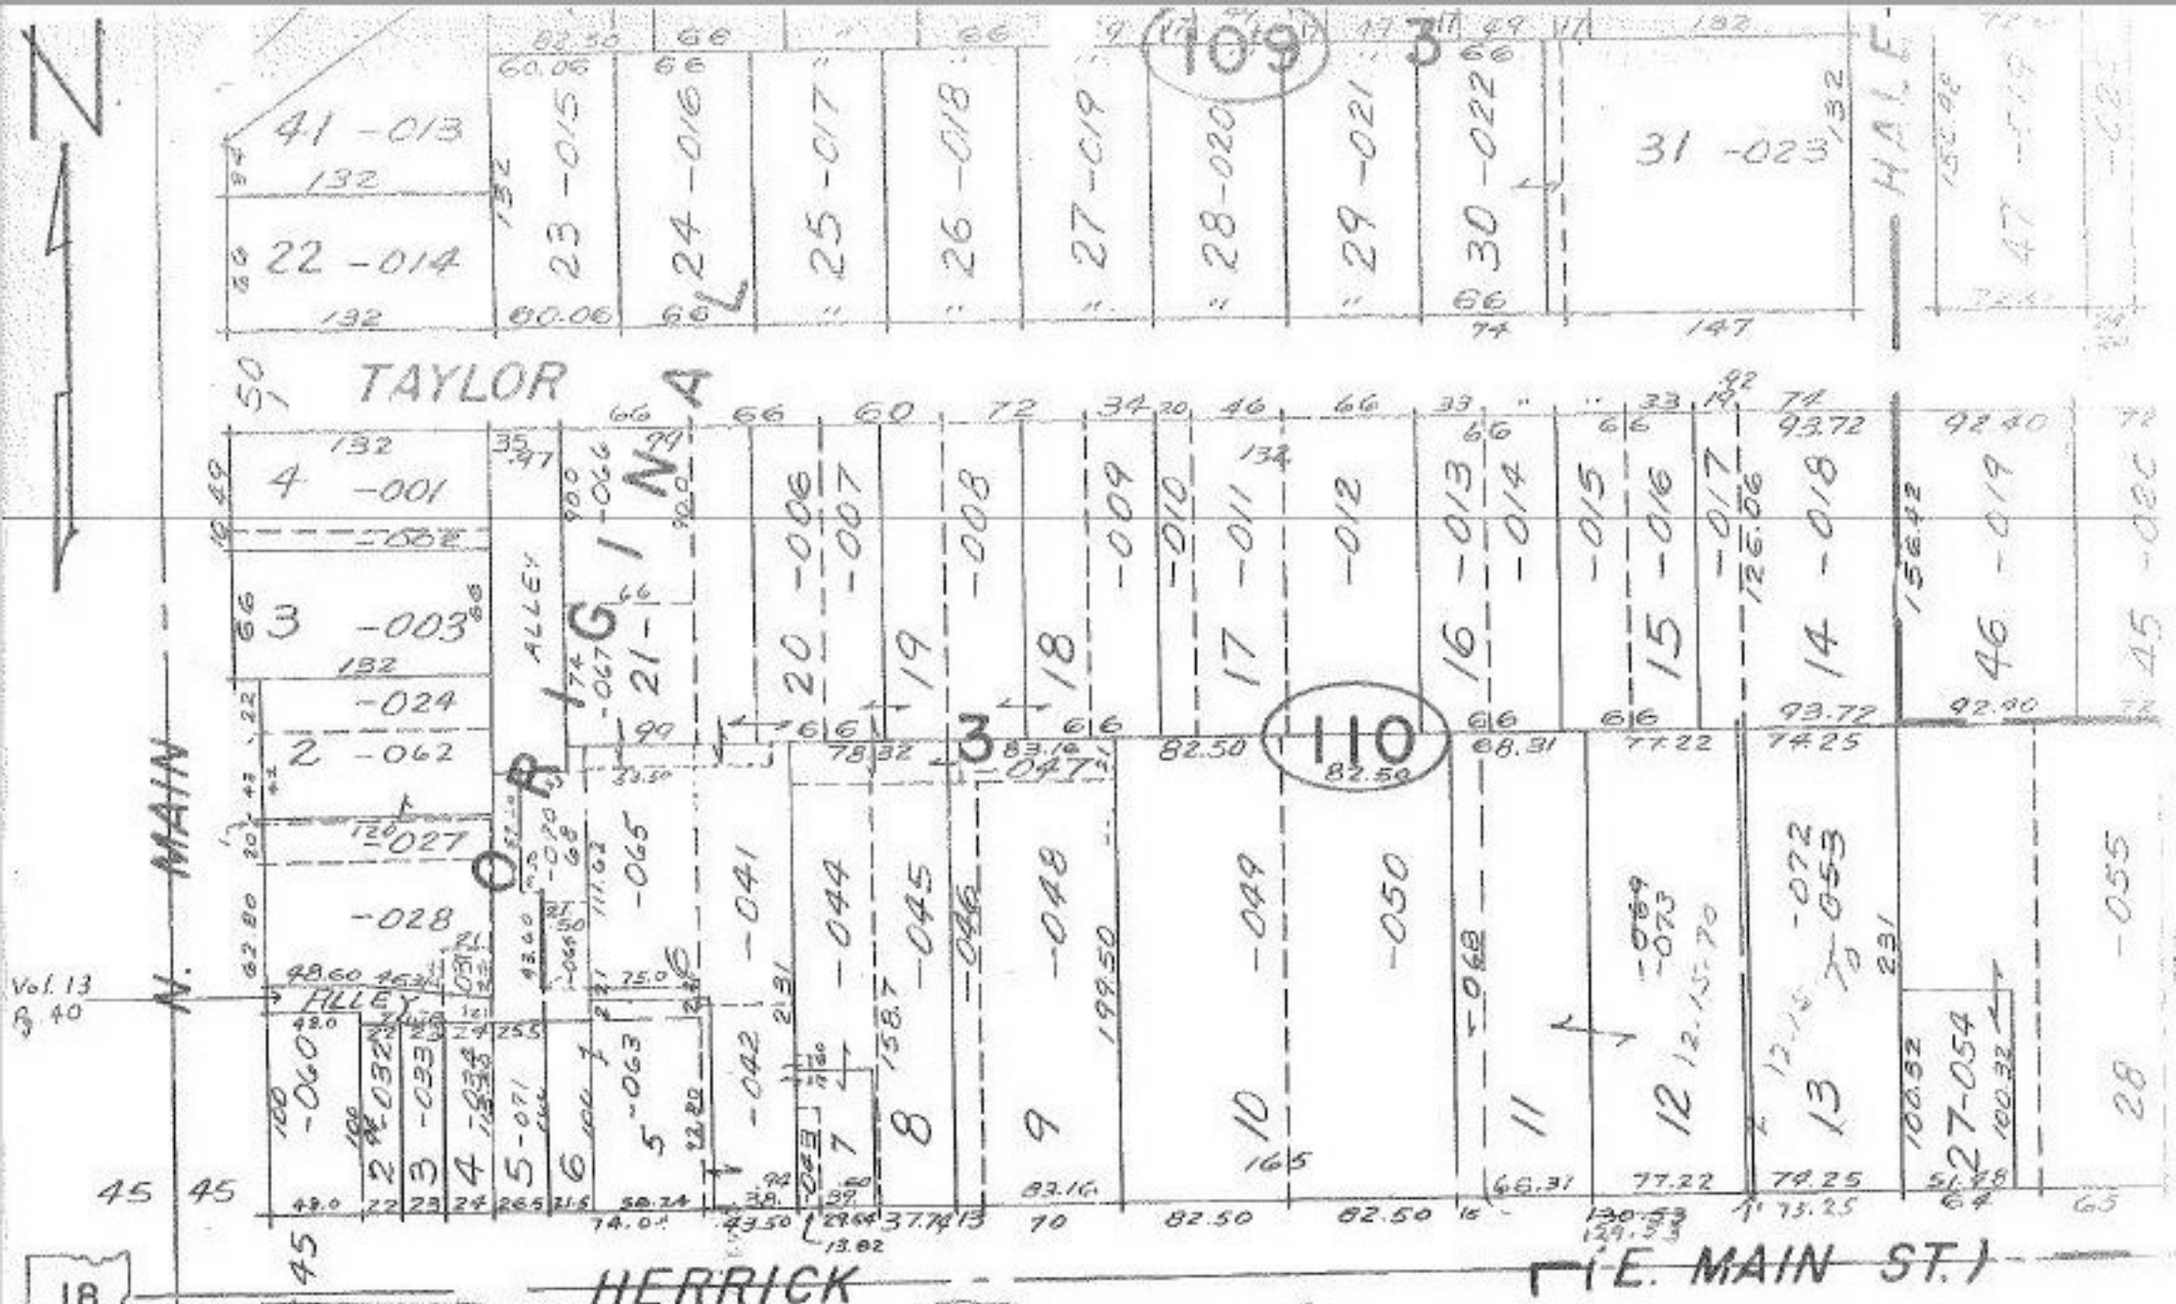

FEB 19 ENT'D
APPROVED
LORAIN CO.
MAP DEPT.
DATE 12/15/70
18-00-021-C
BY R.J. Kelling

4533

Northern Ohio Telephone Co

1 Sh #13
12-15-70
Yellow Copy in Dec Book

4533