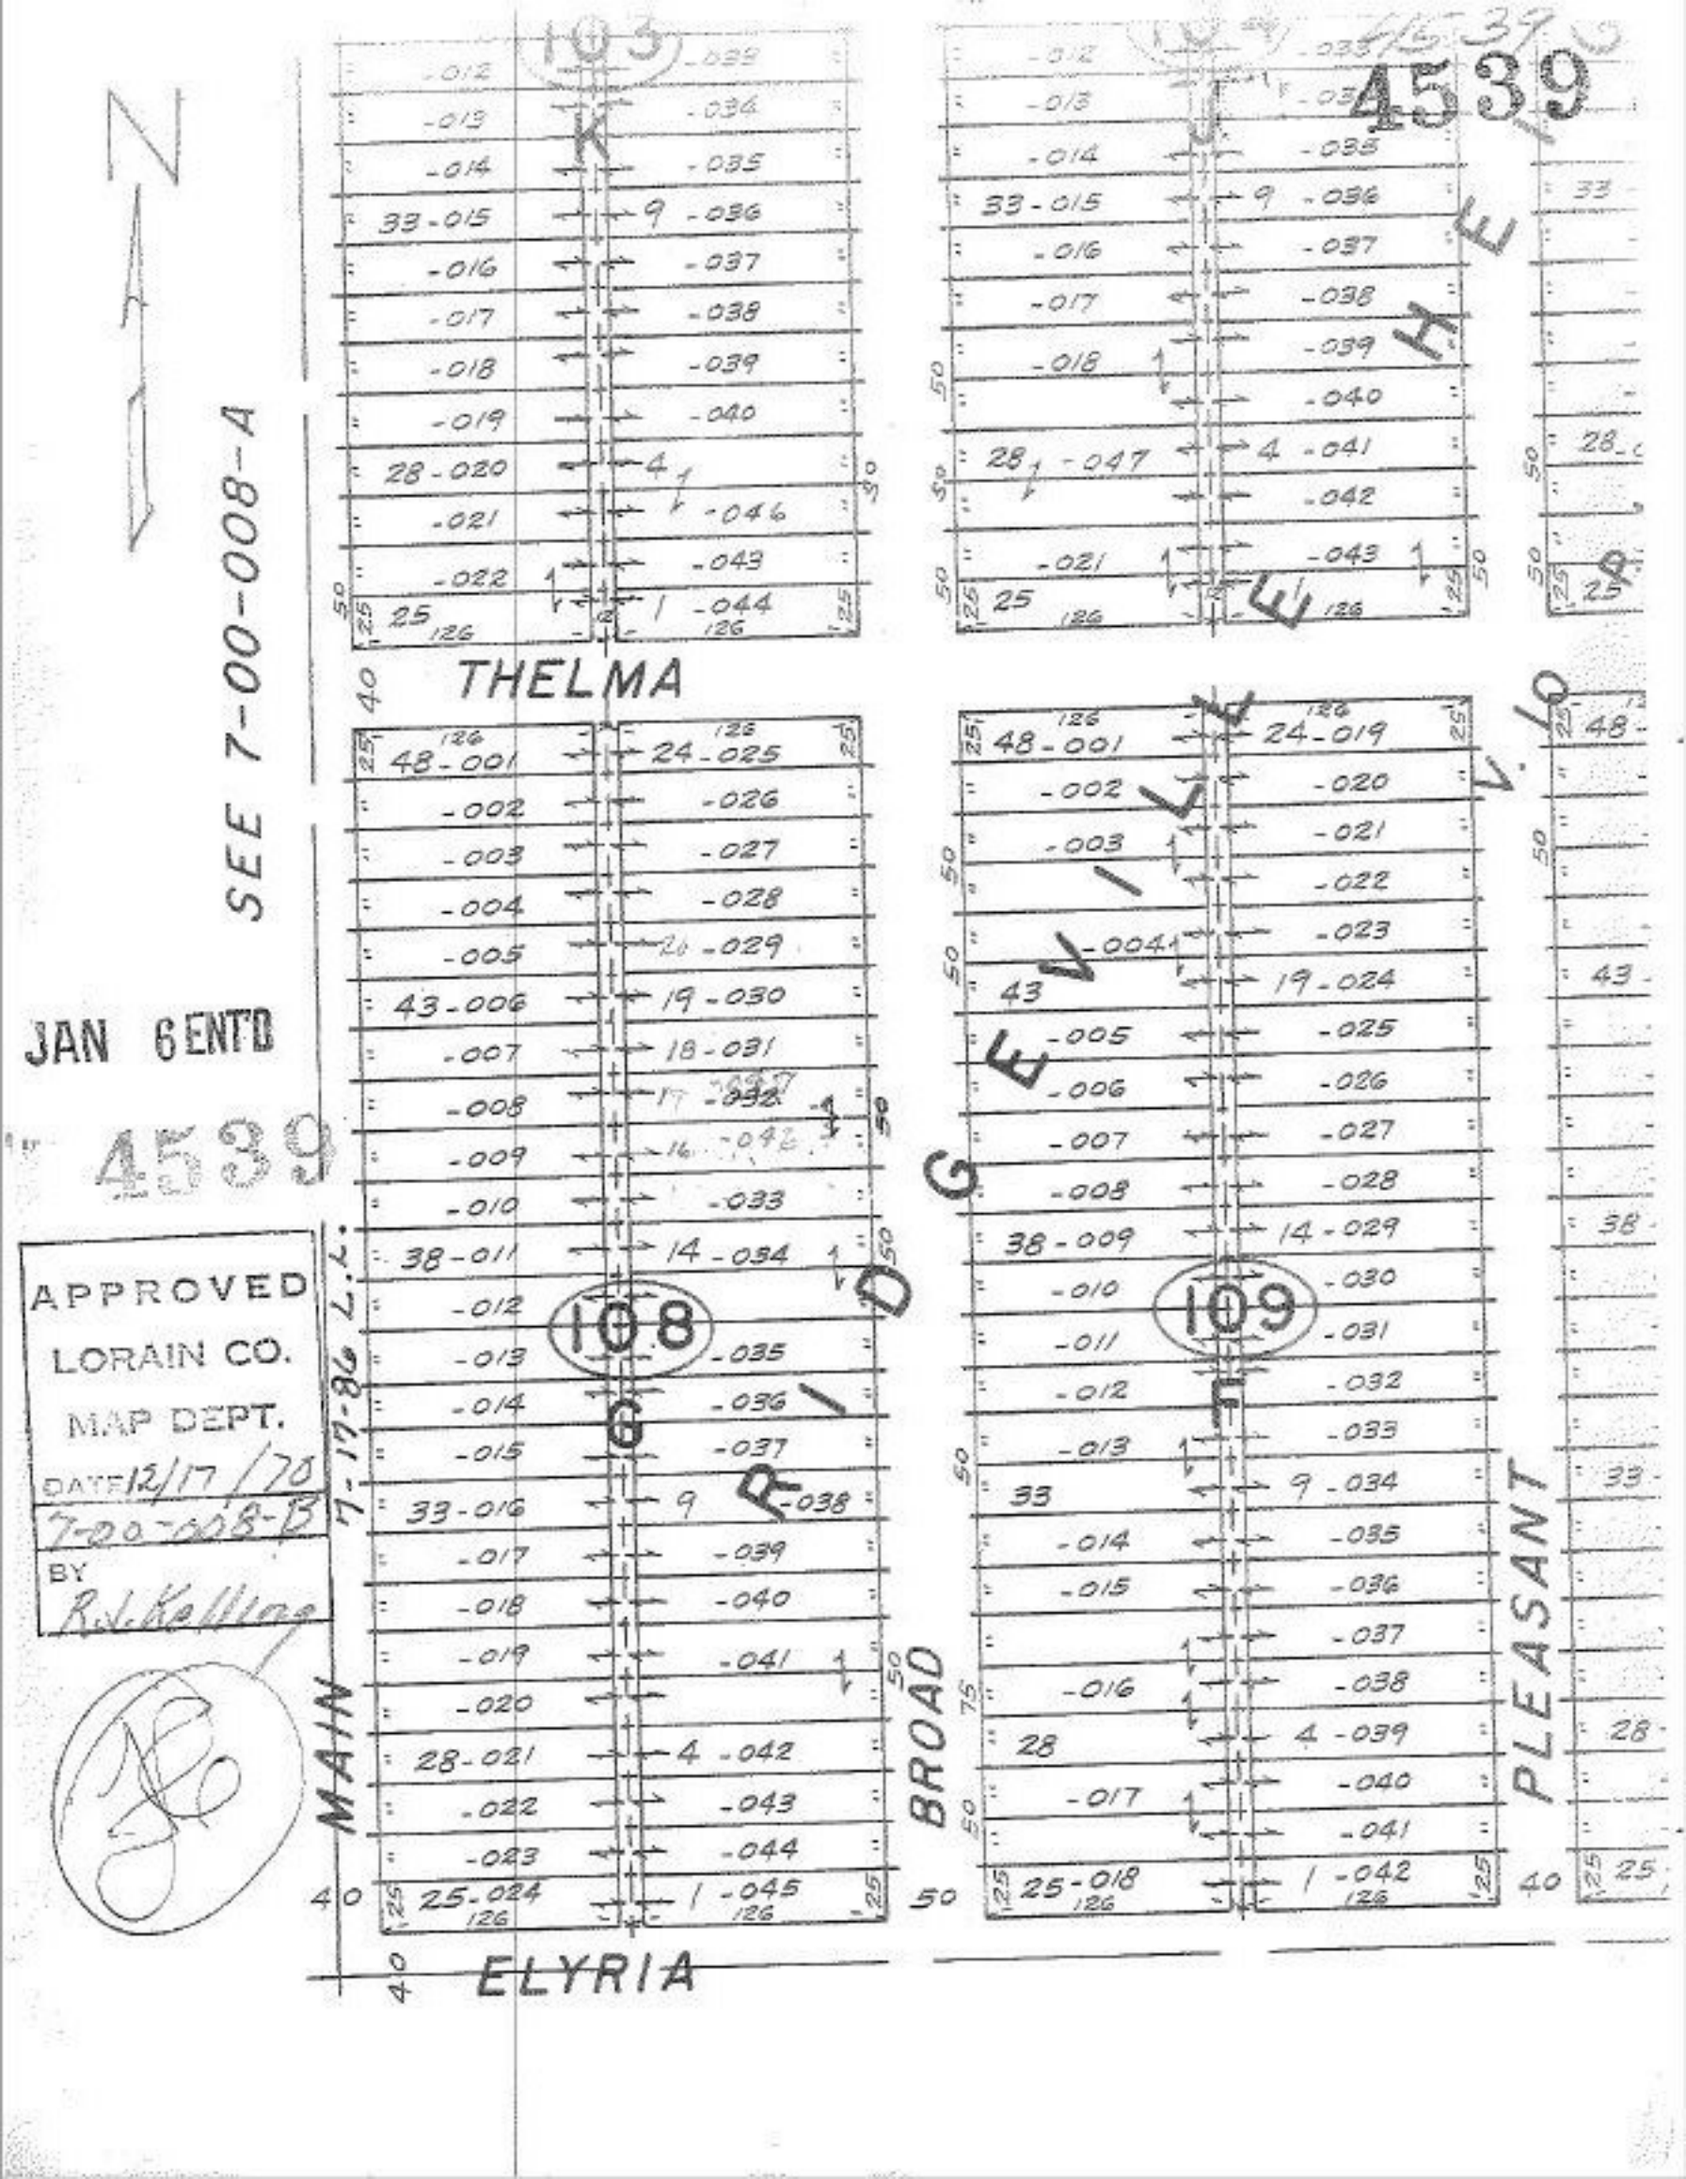
SEE 7-00-008-A
JAN 6 ENT'D
4539
APPROVED
LORAIN CO.
MAP DEPT.
DATE 12/17/70
7-20-008-B
BY
R.V. Kellogg
7-17-86 L.L.
THELMA
ELYRIA
MAIN
BROAD
PLEASANT
HE
DR
V. 10
4539
108
109
103